


NO.	DATE	REVISION
3		
2		
1		

APPROV. _____

NOTE
REFER TO SW-1 FOR
STORM SEWER NOTES

CAUTION!!!
18" SBC DUCT BANK
TO REMAIN

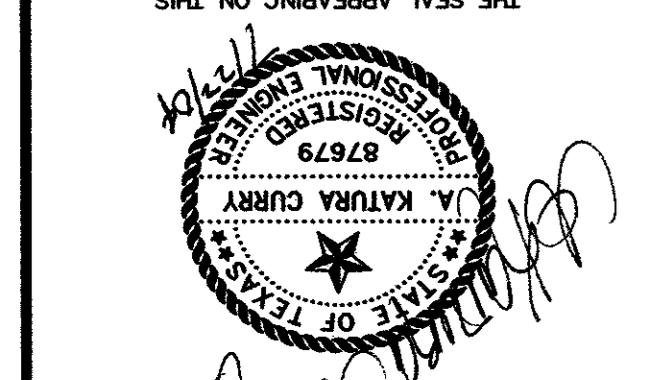


THE SEAL APPEARING ON THIS DOCUMENT WAS AUTHORIZED BY
A. KATURA CURRY
ON 7-21-04.
ALTERATION OF A SEALED
DOCUMENT WITHOUT PROPER
NOTIFICATION TO THE RESPONSIBLE
ENGINEER IS AN OFFENSE
UNDER THE TEXAS ENGINEERING
PRACTICE ACT.

STATION	ELEVATION	PIPE SIZE	CONVERTER
20+00	F/L 9'x5' 603.81	9'x5'	
21+00	F/L 9'x5' 604.51	9'x5'	
22+00	F/L 9'x5' 605.21	9'x5'	500 L.F. 9'x5' REINFORCED CONCRETE BOX CULVERT
23+00	F/L 9'x5' 605.91	9'x5'	
24+00	F/L 9'x5' 606.40	9'x5'	
25+00	F/L 9'x5' 607.50	9'x5'	
26+00	F/L 9'x5' 607.56	9'x5'	
27+00	F/L 9'x5' 607.59	9'x5'	
28+00	F/L 9'x5' 607.63	9'x5'	
29+00	F/L 9'x5' 607.88	9'x5'	
30+00	F/L 9'x5' 608.88	9'x5'	

DATE: MAY 2004
DRAWN: G&A DESK
PROJECT: ARAI
TO: STORM SEWER

VOTED

GARLAND, TEXAS 75042
1919 S. SHILOH ROAD, SUITE 31

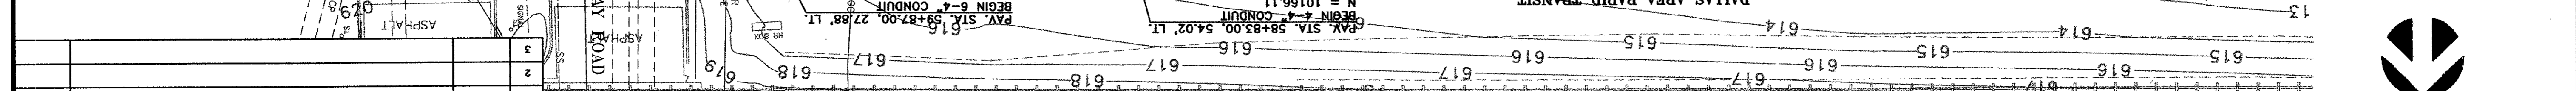

STATION ELEVATION:
STA. 24+47.49 (BRWD)
STA. 24+46.79 (FMV)

STATION ELEVATION:
STA. 24+07.68 LINE 'A'
CONNECTION
CONN. WITH PIPE TO BOX
REMOVE 16 L.F. 30" RCP
N = 10124.54
E = 9242.61
P.L. STA. 24+51.71

STATION ELEVATION:
STA. 24+07.68 LINE 'A'
CONNECTION
CONN. WITH PIPE TO BOX
REMOVE 16 L.F. 30" RCP
N = 10124.54
E = 9242.61
P.L. STA. 24+51.71