



1+00 2+00 3+00 4+00 ALLEY "A" 0+00 1+00 2+00 ALLEY "C"

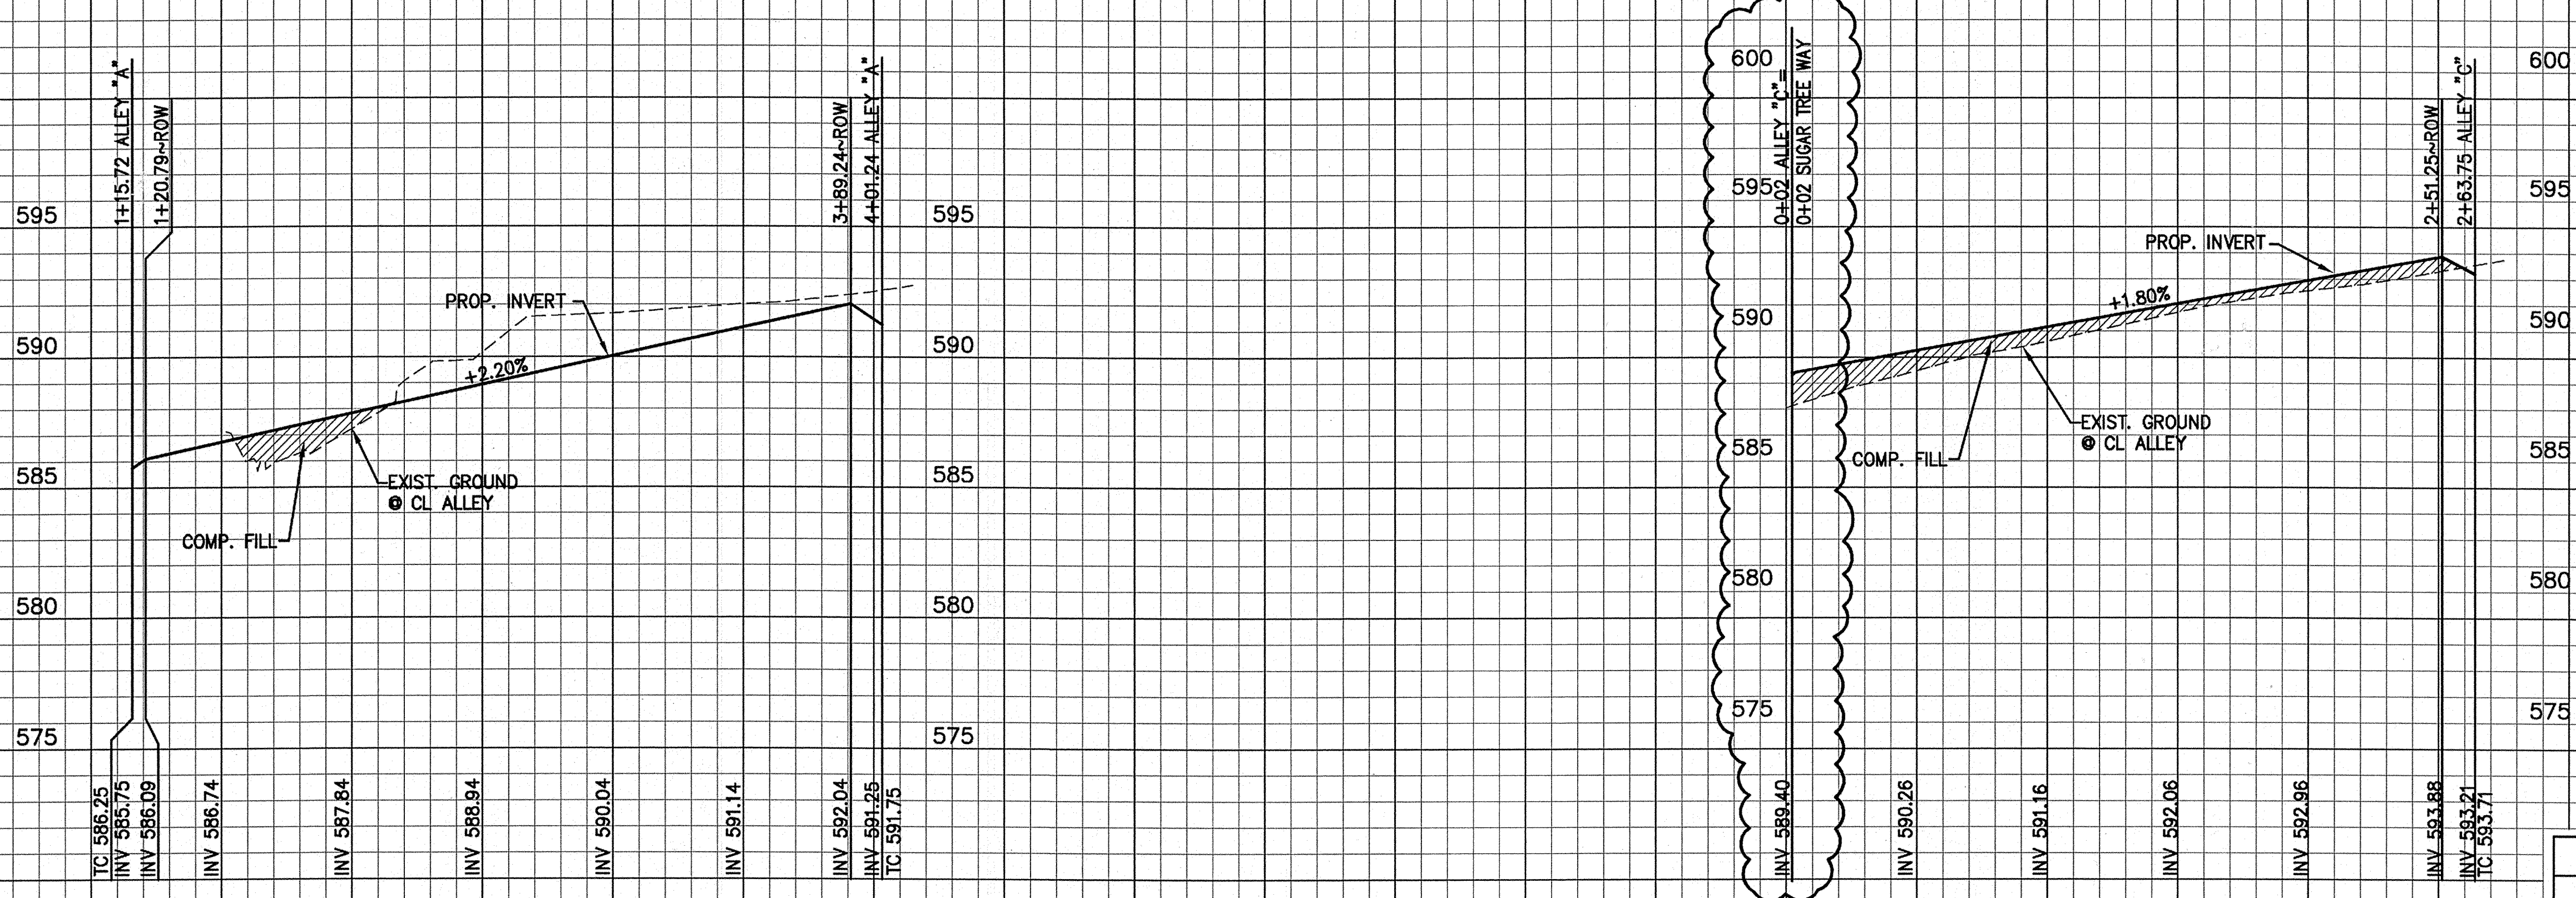

**BENCHMARKS:**  
 CITY OF ADDISON BENCHMARK NO. 13:  
 SQUARE CUT ON THE BACK OF CURB AT THE CENTER OF AN  
 INLET AT THE SOUTHEAST CORNER OF BELTLINE ROAD AND  
 SURVEYOR BOULEVARD.  
 ELEVATION = 594.94'  
 CITY OF ADDISON BENCHMARK NO. 18:  
 SQUARE CUT ON COSERV ELECTRIC VAULT AT THE NORTHEAST  
 CORNER OF BELTLINE ROAD AND MIDWAY ROAD.  
 ELEVATION = 627.93'

THESE CONSTRUCTION PLANS WERE PREPARED  
 UNDER THE RESPONSIBLE SUPERVISION OF J.  
 CASEY ROSS, LICENSED PROFESSIONAL ENGINEER  
 NO. 97272

*J. Casey Ross 3/5/08*

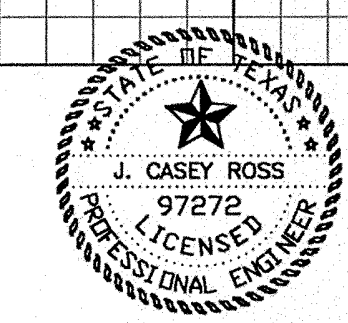

NO.	DATE	BY	REVISION
1	1/21/08	JCR	REVISED CENTERLINE OF SUGAR TREE WAY AT ALLEY C
2	3/03/08	JCR	ADA ACCESSIBLE PATH ACROSS ALLEY

**ALLEY 'A' & ALLEY 'C'**  
**PAVING PLAN & PROFILES**  
**ASBURY CIRCLE**  
 TOWN OF ADDISON  
 DALLAS COUNTY, TEXAS

**DOWDEY, ANDERSON & ASSOCIATES, INC.**  
 5225 Village Creek Drive, Suite 200 Plano, Texas 75093 972-931-0694

DESIGN	DRAWN	CHECKED	DATE	SCALE	JOB	SHEET
JCR	AR	JCR	02-14-07	H: 1"=40' V: 1"=4'	06010	4 / 5