

LINE 'E' & LAT 'E1'
STORM SEWER PLAN & PROFILE
ASBURY CIRCLE

TOWN OF ADDISON
 DALLAS COUNTY, TEXAS

DOWDEY, ANDERSON & ASSOCIATES, INC.
 5225 Village Creek Drive, Suite 200 Plano, Texas 75093 972-931-0694

DESIGN	DRAWN	CHECKED	DATE	SCALE	JOB	SHEET
AR	AR	JCR	8/28/06	H: 1"=40' V: 1"=4'	06010	4


BENCHMARKS:

CITY OF ADDISON BENCHMARK NO. 13:
 SQUARE CUT ON THE BACK OF CURB AT THE CENTER OF AN INLET
 AT THE SOUTHEAST CORNER OF BELTLINE ROAD AND SURVEYOR
 BOULEVARD.
 ELEVATION = 594.94'

CITY OF ADDISON BENCHMARK NO. 18:
 SQUARE CUT ON COSERVY ELECTRIC VAULT AT THE NORTHEAST
 CORNER OF BELTLINE ROAD AND MIDWAY ROAD.
 ELEVATION = 627.93'

THESE CONSTRUCTION PLANS WERE PREPARED
 UNDER THE RESPONSIBLE SUPERVISION OF J.
 CASEY ROSS, LICENSED PROFESSIONAL ENGINEER
 NO. 97272

J. Casey Ross 9/25/07

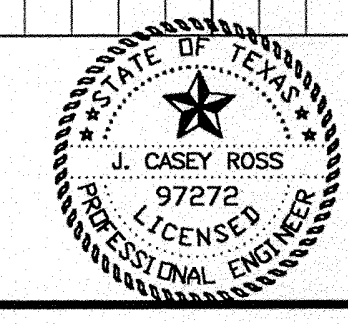

NO.	DATE	BY	REVISION