

Legend

- Prop San. Sewer
- Prop Manhole
- Prop wvac
- San Sewer Flow Direction
- Prop Water
- Prop Fire Hydrant
- - - Exist. San. Sewer
- - - Exist. Manhole
- - - Exist. Clean-out
- - - Exist. Water
- - - Exist. Fire Hydrant
- * Fire Water Service
- ⊠ Electric Transformer

WATER SERVICE SCHEDULE

TYPE	SIZE	NO.
DOM.	1"	73
FIRE	1.5"	73
IRRIG.	2"	2
IRRIG.	1"	1
IRRIG.	1.5"	1

SANITARY SEWER SERVICES

TYPE	SIZE	NO.
PVC	4"	73

CURVE TABLE


CURVE	DELTA	RADIUS	TANGENT	LENGTH	CHORD
C1	111°22'	250.00'	24.67'	49.19'	S35°34'52"E 49.11'
C2	163°04'22"	250.00'	35.30'	70.13'	S56°49'08"W 69.90'
C3	163°04'22"	250.00'	35.30'	70.13'	S56°49'08"W 69.90'

BENCHMARKS:
CITY OF ADDISON BENCHMARK NO. 13:
SQUARE CUT ON THE BACK OF CURB AT THE CENTER OF AN
INLET AT THE SOUTHEAST CORNER OF BELTLINE ROAD AND
SURVEYOR BOULEVARD.
ELEVATION = 594.94'

CITY OF ADDISON BENCHMARK NO. 18:
SQUARE CUT ON COSERV ELECTRIC VAULT AT THE NORTHEAST
CORNER OF BELTLINE ROAD AND MIDWAY ROAD.
ELEVATION = 627.93'

THESE CONSTRUCTION PLANS WERE PREPARED
UNDER THE RESPONSIBLE SUPERVISION OF J.
CASEY ROSS, LICENSED PROFESSIONAL ENGINEER
NO. 97272

J. Casey Ross 2/9/08

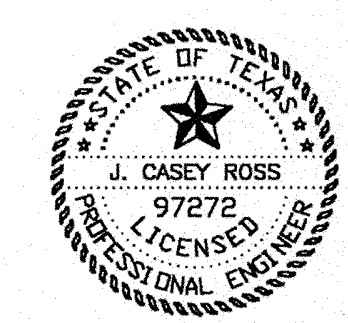

NO.	DATE	BY	REVISION
1	1/24/08	JCR	REVISED FIRE SERVICES TO 1.5"
2	2/04/08	JCR	ADDED WATER LINE LOWERING

WATER & SANITARY SEWER PLAN
ASBURY CIRCLE
TOWN OF ADDISON
DALLAS COUNTY, TEXAS

DOWDEY, ANDERSON & ASSOCIATES, INC.
5225 Village Creek Drive, Suite 200 Plano, Texas 75093 972-931-0694

DESIGN	DRAWN	CHECKED	DATE	SCALE	JOB	SHEET
TMD	TMD	JCR	10/13/2006	1" = 20'	06010	3