


BENCHMARKS:

CITY OF ADDISON BENCHMARK NO. 13:
 SQUARE CUT ON THE BACK OF CURB AT THE CENTER OF AN
 INLET AT THE SOUTHEAST CORNER OF BELTLINE ROAD AND
 SURVEYOR BOULEVARD.
 ELEVATION = 594.94'

CITY OF ADDISON BENCHMARK NO. 18:
 SQUARE CUT ON COSERV ELECTRIC VAULT AT THE NORTHEAST
 CORNER OF BELTLINE ROAD AND MIDWAY ROAD.
 ELEVATION = 627.93'

THESE CONSTRUCTION PLANS WERE PREPARED
 UNDER THE RESPONSIBLE SUPERVISION OF J.
 CASEY ROSS, LICENSED PROFESSIONAL ENGINEER
 NO. 97272.

J. Casey Ross 9/25/07

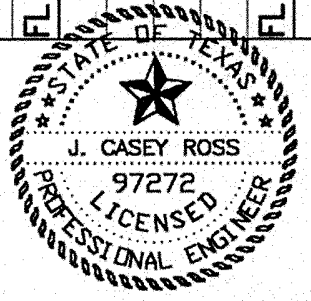

NO.	DATE	BY	REVISION

LINES 'A', 'B', 'C' & 'D'

SANITARY SEWER PROFILES

ASBURY CIRCLE

TOWN OF ADDISON
 DALLAS COUNTY, TEXAS

DOWDEY, ANDERSON & ASSOCIATES, INC.
 5225 Village Creek Drive, Suite 200 Plano, Texas 75093 972-931-0694

DESIGN	DRAWN	CHECKED	DATE	SCALE	JOB	SHEET
TMD	TMD	JCR	10/16/06	H: 1" = 40' V: 1" = 4'	06010	1