

No.	Date	REVISIONS

ASBURY CIRCLE

ADDISON, TX

DAVID C. BALDWIN
INCORPORATED




LANDSCAPE
ARCHITECTURE
PLANNING
730 EAST PARK BOULEVARD
SUITE 100 PLANO, TX 75074

TEL: (972) 509-1266
FAX: (972) 509-1269

Sheet Title:
HARDSCAPE PLAN

Proj. No.:
Date: 1 OCT 07
Drawn: BJL
Checked: RRM
Approved: DCB
sheet number
L1.2
of sheets

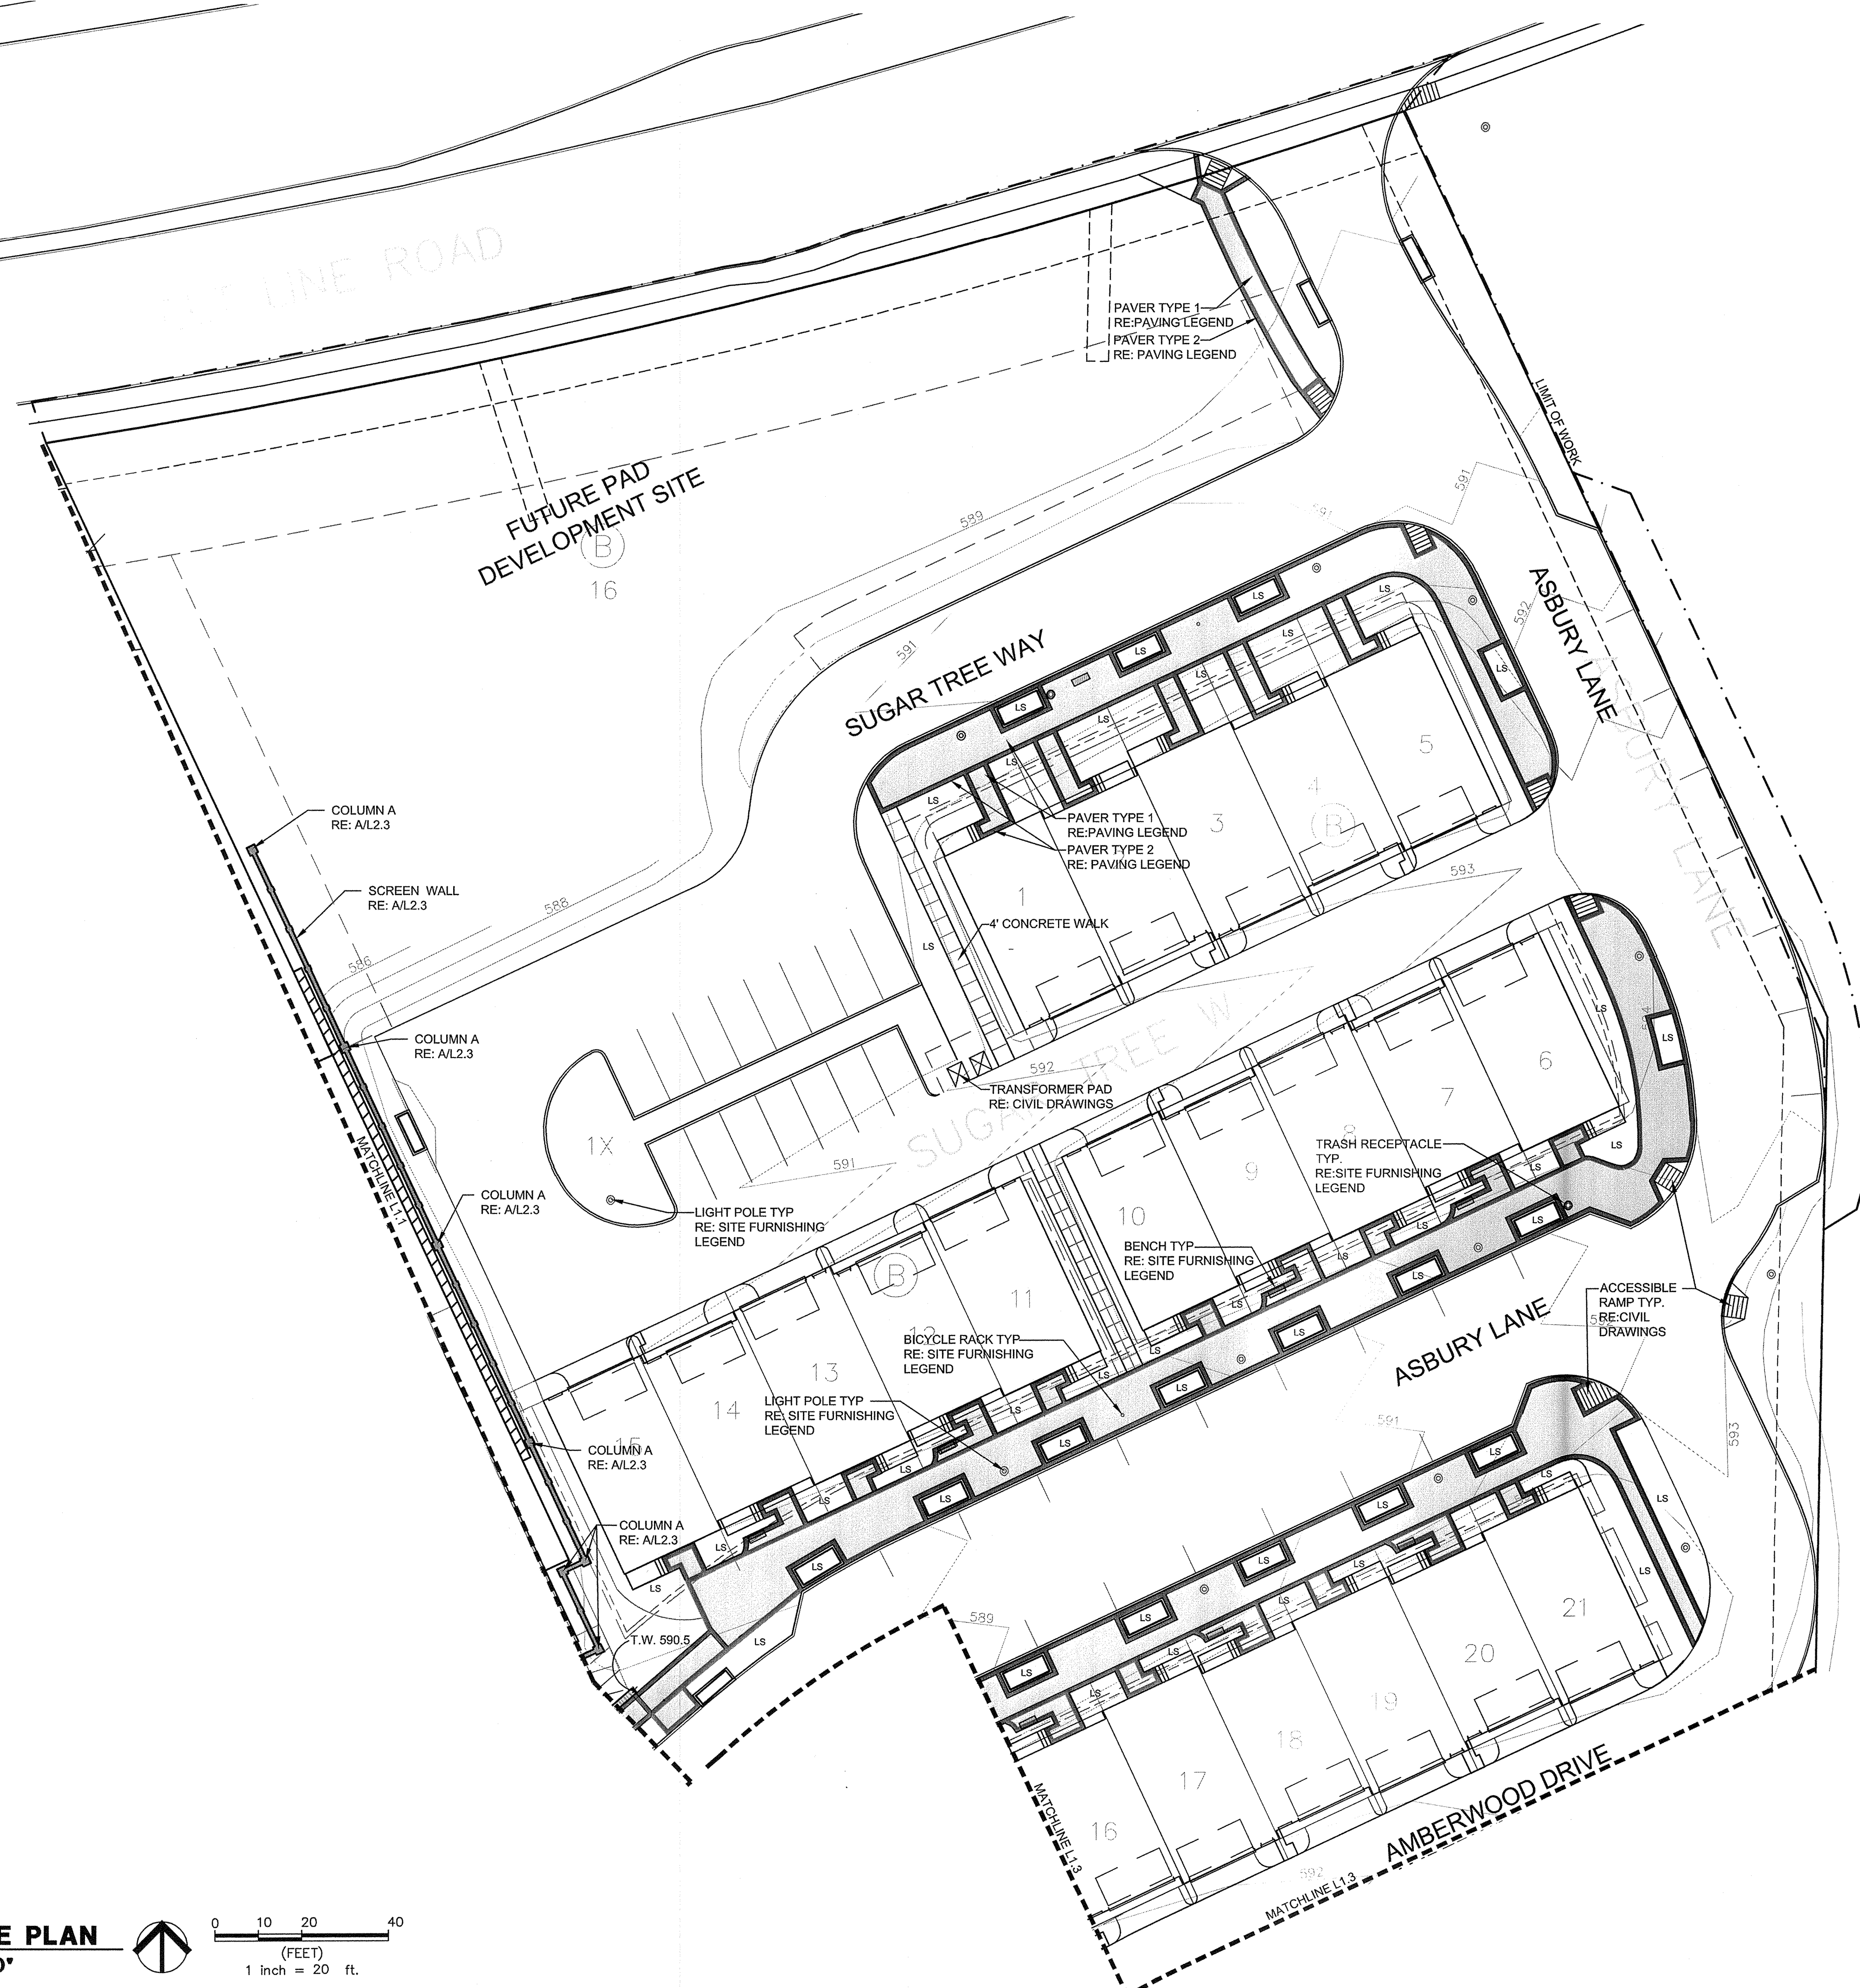

A HARDSCAPE PLAN
SCALE: 1"=20'-0"

LEGEND:

TW	TOP OF WALL
LS	LANDSCAPE AREA
[Pattern]	PAVER TYPE 1
[Pattern]	PAVER TYPE 2
[Pattern]	STANDARD GRAY CONCRETE
[Pattern]	RETAINING WALL
[Pattern]	SEAT WALL