

No.	Date	REVISIONS

ASBURY CIRCLE

ADDISON, TX

DAVID C. BALDWIN
INCORPORATED



LANDSCAPE ARCHITECTURE
PLANNING
730 EAST PARK BOULEVARD
SUITE 100 PLANO, TX 75074


TEL: (972) 231-5151
FAX: (972) 509-1269

IRRI*TECH

12650 SCHROEDER RD.
DALLAS, TEXAS 75243
TEL: (972) 231-5151
FAX: (972) 231-5172

Sheet Title:
IRRIGATION PLAN

Proj. No.: 07087
Date: 1 OCT 07
Drawn: SAH
Checked: SAH
Approved: ITC
sheet number
of **L4.3** sheets

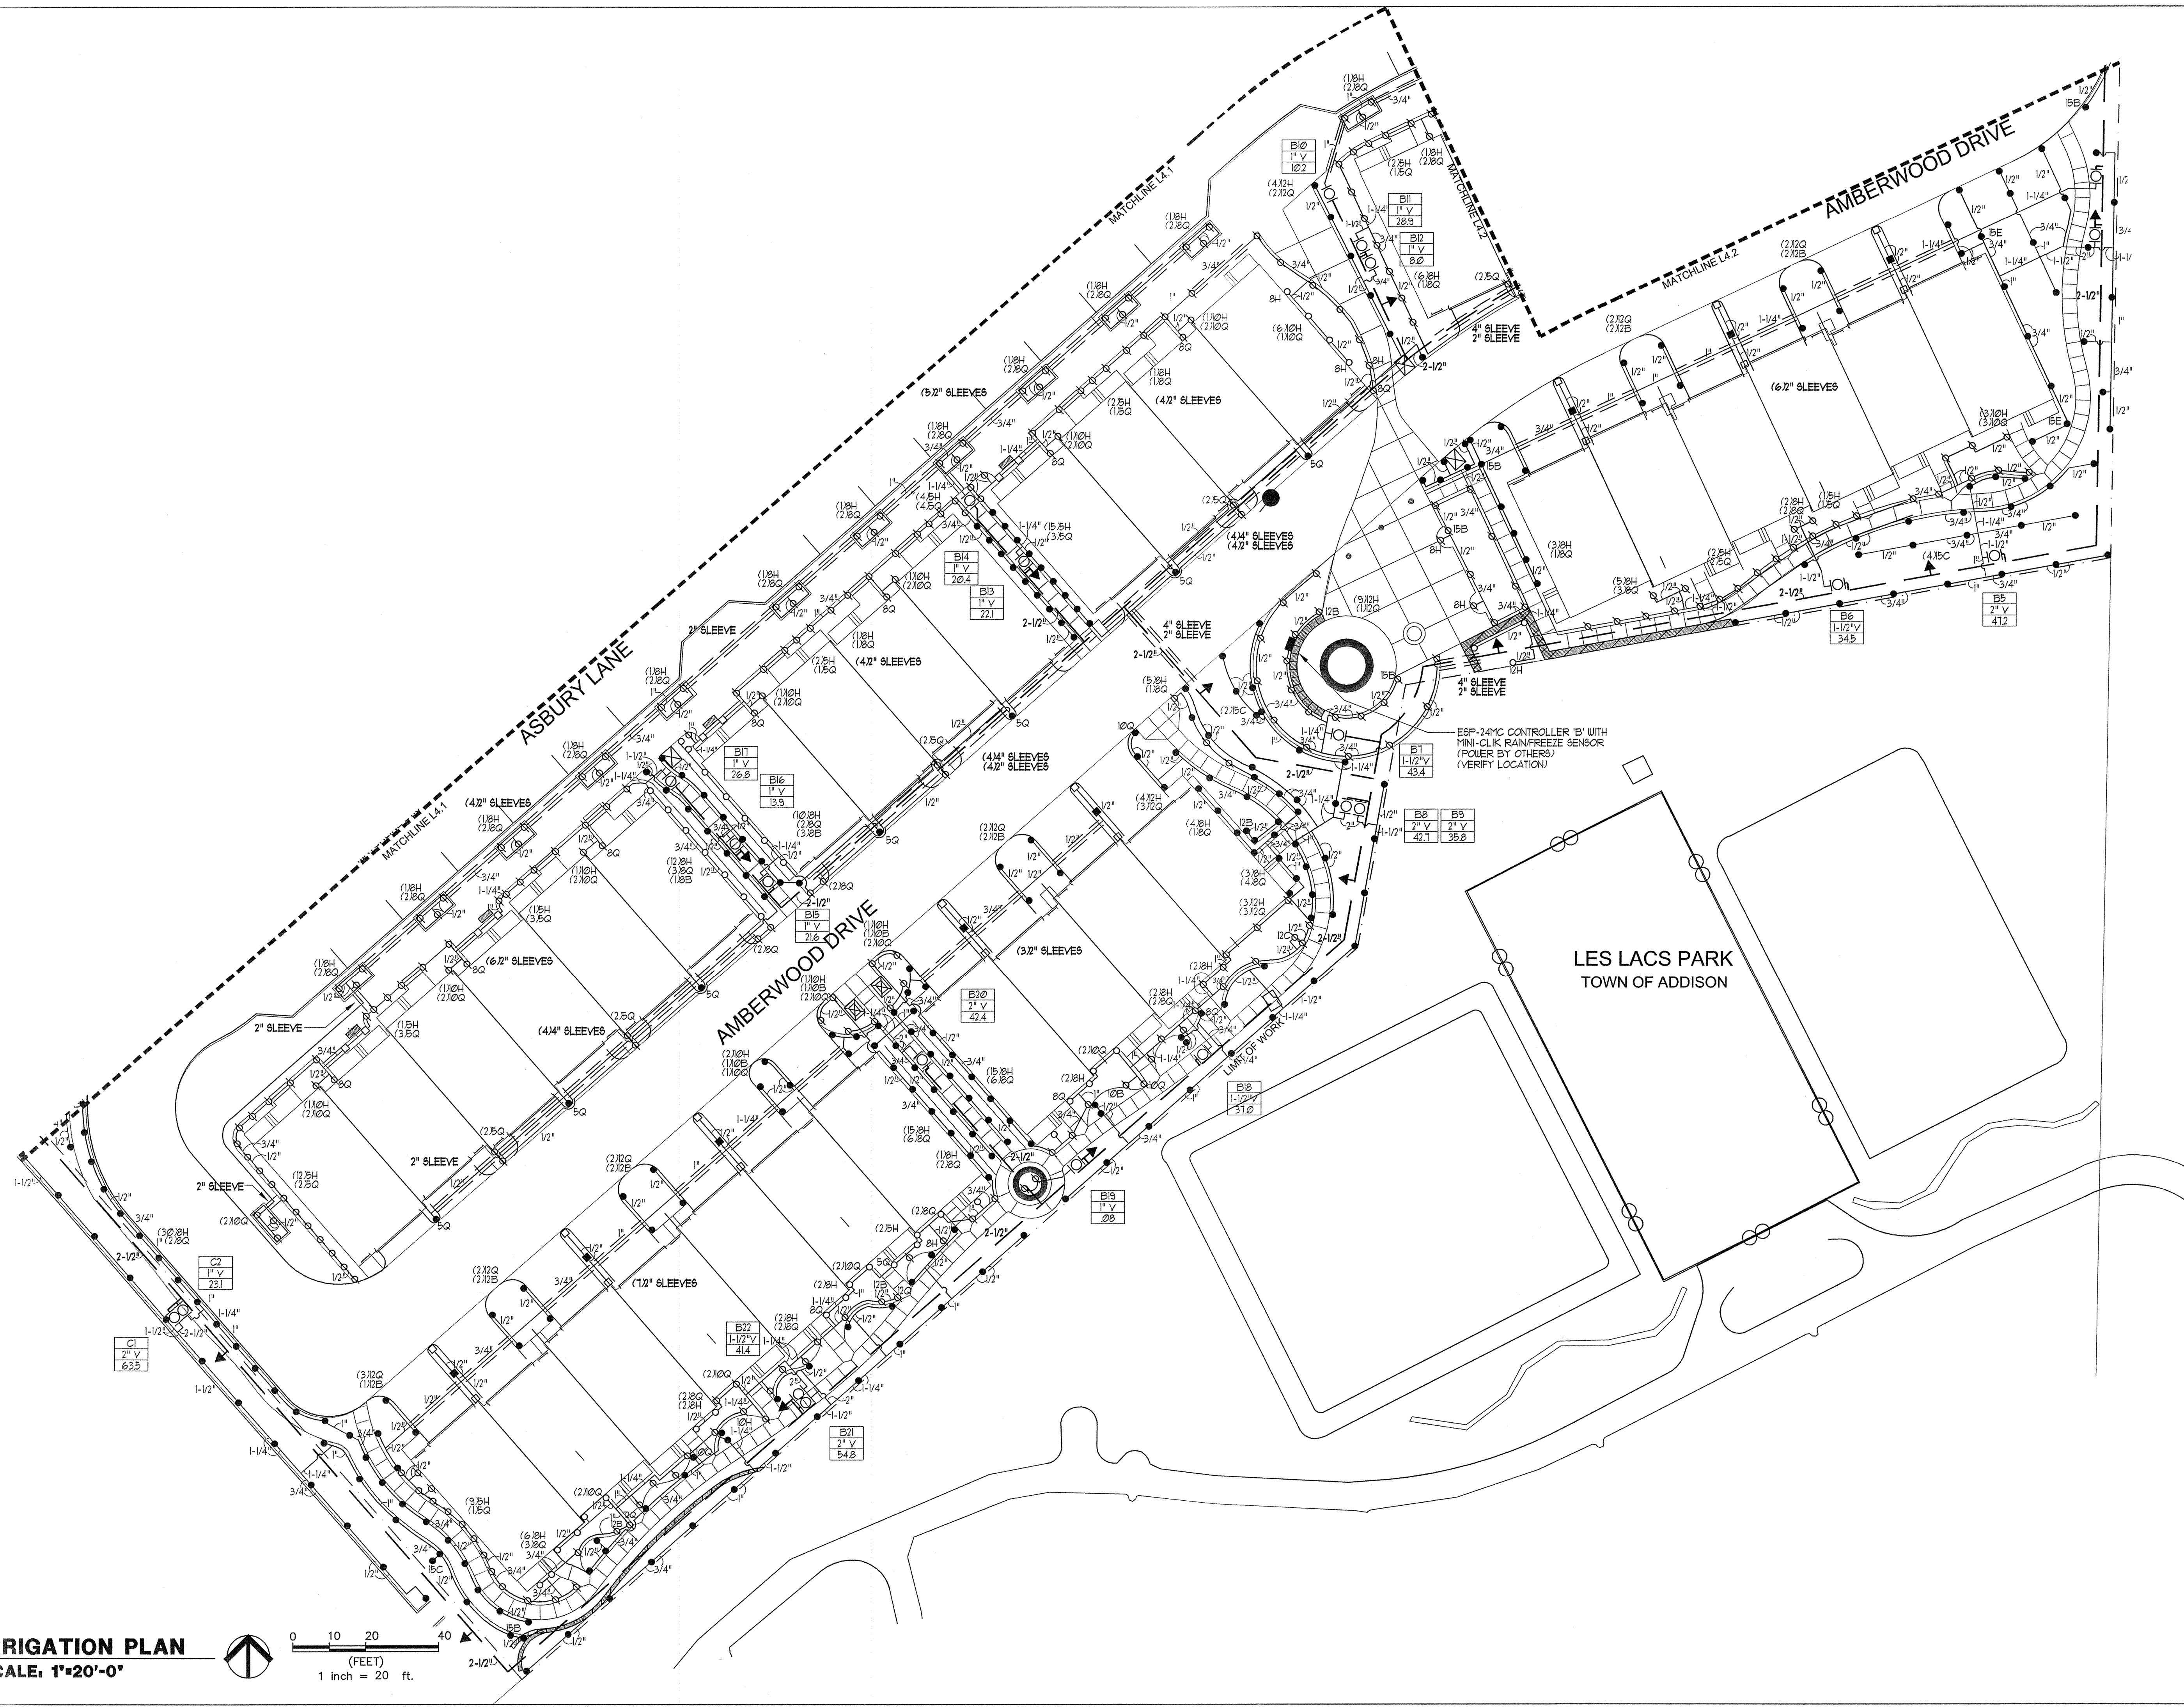

A IRRIGATION PLAN
SCALE: 1"=20'-0"

