


DATE	
BY	
REVISION	
NOTE BOOK	
BY	
DATE	



DATE	
BY	
REVISION	
NOTE BOOK	
BY	
DATE	

- REVISIONS
- △ GENERAL REVISIONS AS PER CITY OF ADDISON - 11/13/81
 - △ STREET NAME CHANGES - 11/20/81
 - △ REVISED PAVING GRADES FROM 11+00 TO 13+33.03 (12/07/81)

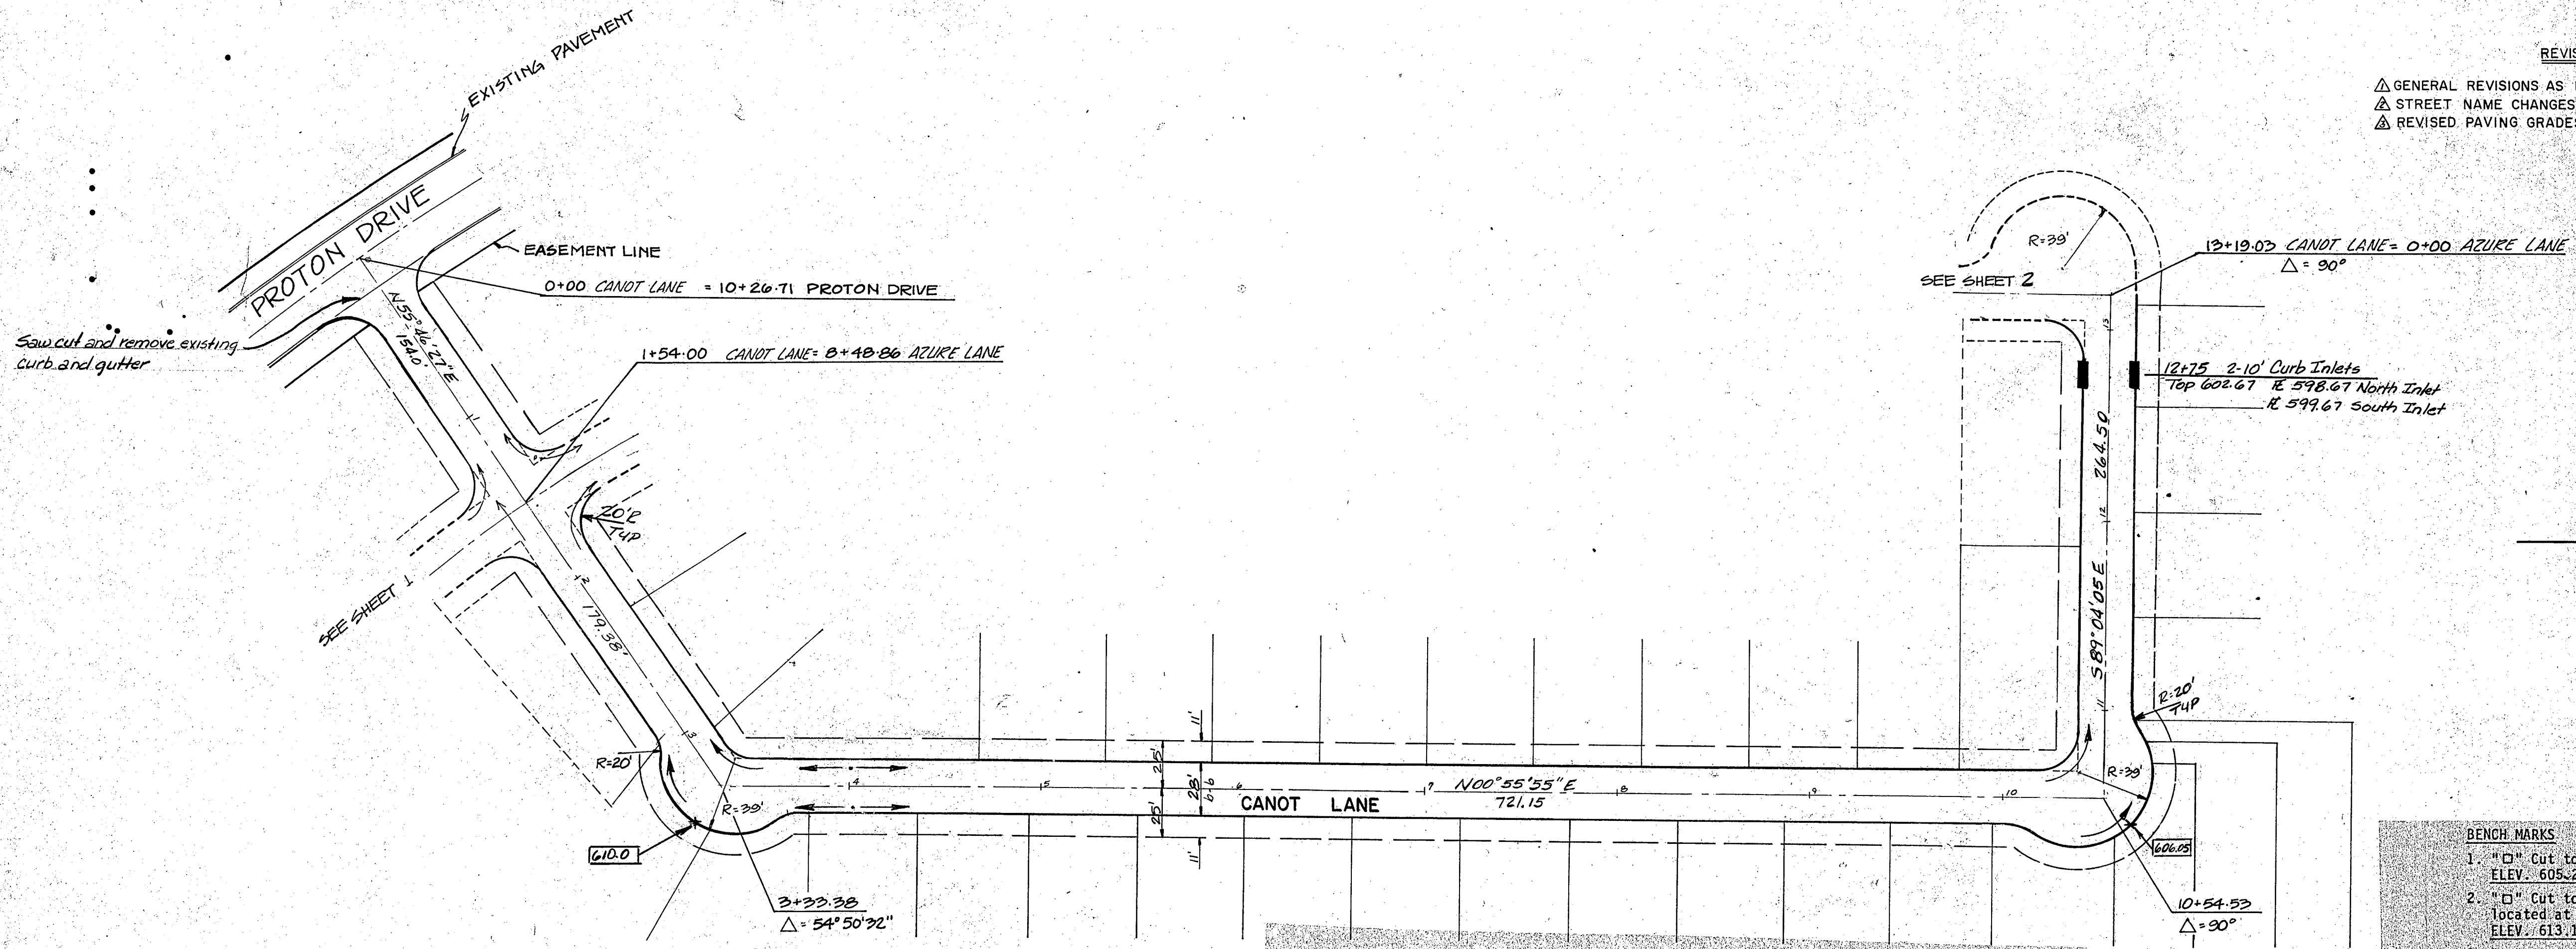

NOTE: ALL DIMENSIONS ARE TO BACK-OF CURB UNLESS OTHERWISE NOTED.

- BENCH MARKS
1. "D" Cut top of conc. footing at Northwest cor. Tower #12N-3W-T288 ELEV. 605.20
 2. "D" Cut top of conc. footing at Northwest cor. Tower #12N-3W-T290 located at the angle point of the 1 line ELEV. 613.16
 3. "D" Cut top of conc. footing at Southwest cor. Tower #12N-3W-T291 ELEV. 619.46

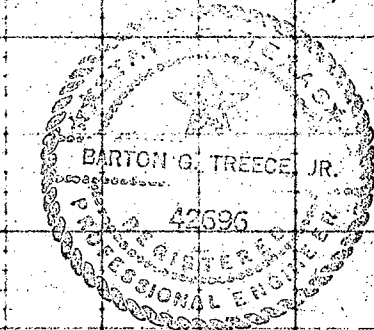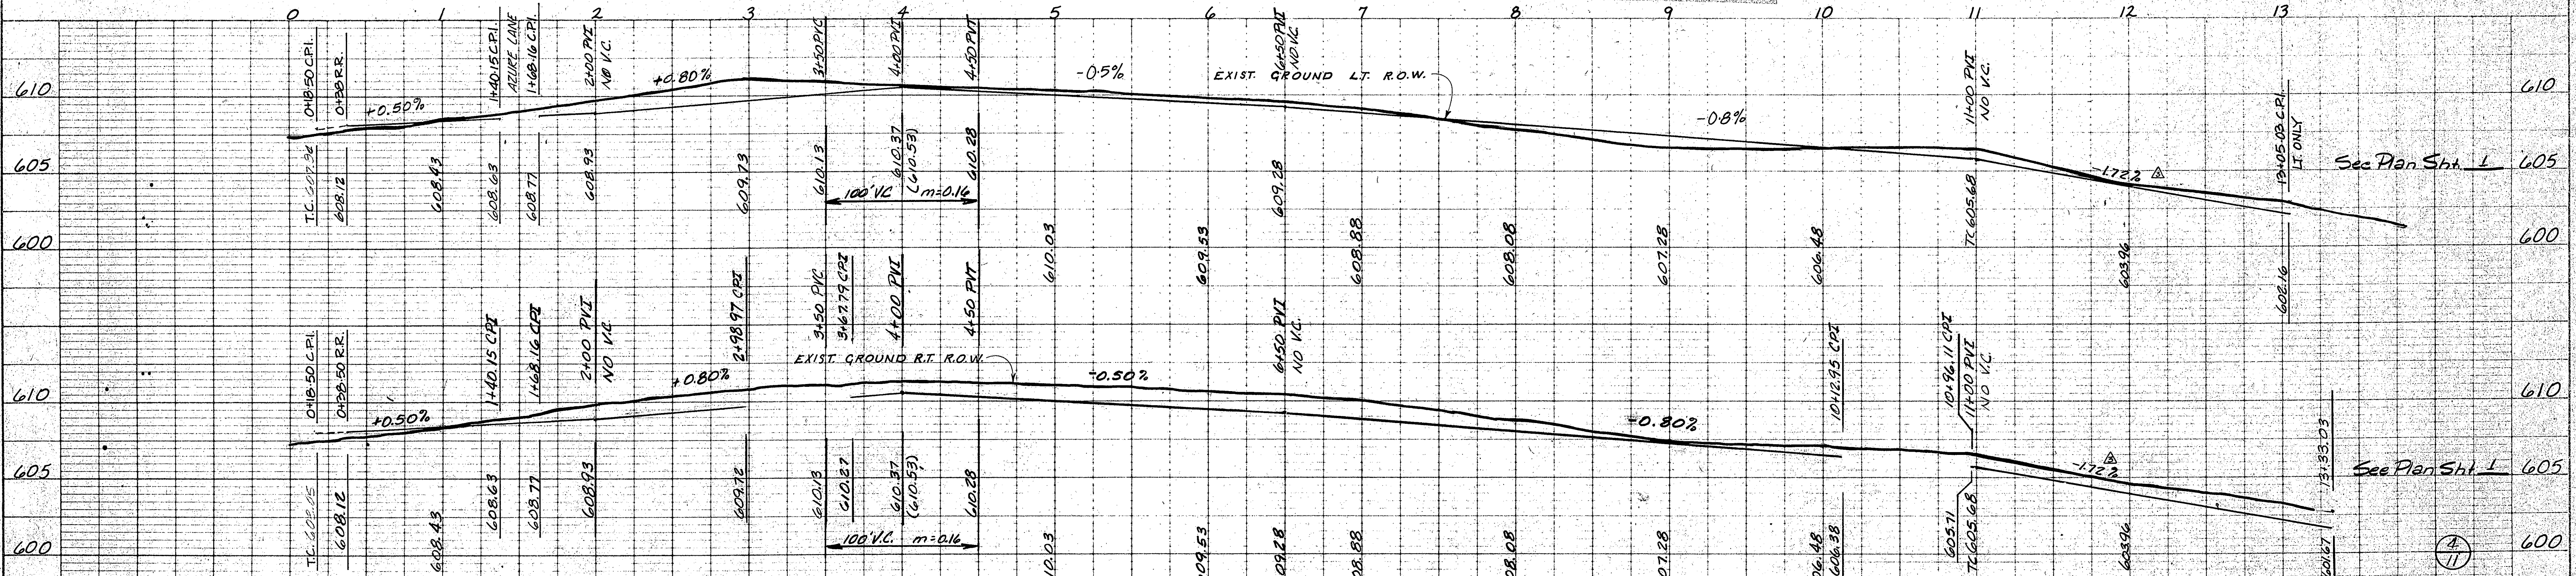

PAVING PLAN						
LES LACS-GARDEN HOMES						
CANOT LANE						
CITY OF ADDISON, TEXAS						
HILL & CO. ENGINEERING SCIENCES INC.						
DESIGN	DRAWN	DATE	SCALE	NOTES	FILE	NO.
HILL & CO.		AUG 81	HOR. 1"=50' VERT. 1"=5'	RLG		