

PLANS FOR THE CONSTRUCTION OF PAVING, DRAINAGE & UTILITY IMPROVEMENTS

BELLA LANE Sta 20+63.50 to Sta 31+74.50

FOR

VITRUVIAN PARK PUBLIC INFRASTRUCTURE - PHASE 2 TOWN OF ADDISON, TEXAS

PUBLIC WORKS # 2010-08

Addison!

JOE CHOW
MAYOR

DON DASEKE
MAYOR PRO TEMPORE

BLAKE CLEMENS
DEPUTY MAYOR PRO TEMPORE

NEIL RESNIK
ROGER MELLOW
KIMBERLY LAY
BIANCA NOBLE
COUNCIL MEMBERS

RON WHITEHEAD
CITY MANAGER

LEA DUNN
DEPUTY CITY MANAGER

NANCY CLINE, P.E.
DIRECTOR OF PUBLIC WORKS

CLAY BARNETT, P.E.
TOWN ENGINEER

CIVIL ENGINEER:


ICON CONSULTING ENGINEERS, INC.
250 W. SOUTHLAKE BLVD., SUITE 117
SOUTHLAKE, TEXAS 76092
PH: (817) 552-6210
FAX: (817) 552-3126
CONTACT: BRUCE F. DUNNE, P.E.

ELECTRICAL ENGINEER

SCARBOROUGH ENGINEERING, INC.
2400 SCOTT AVENUE
FORT WORTH, TEXAS 76103
PH: (817) 451-6687
FAX: (817) 451-0476
CONTACT: JON D. SCARBOROUGH, P.E.

SURVEYOR:

KADLECK & ASSOCIATES
555 REPUBLIC DRIVE, SUITE 115
PLANO, TEXAS, 75074
PH: (972) 881-0771
FAX: (972) 509-1861
CONTACT: LYNN KADLECK, R.P.L.S.

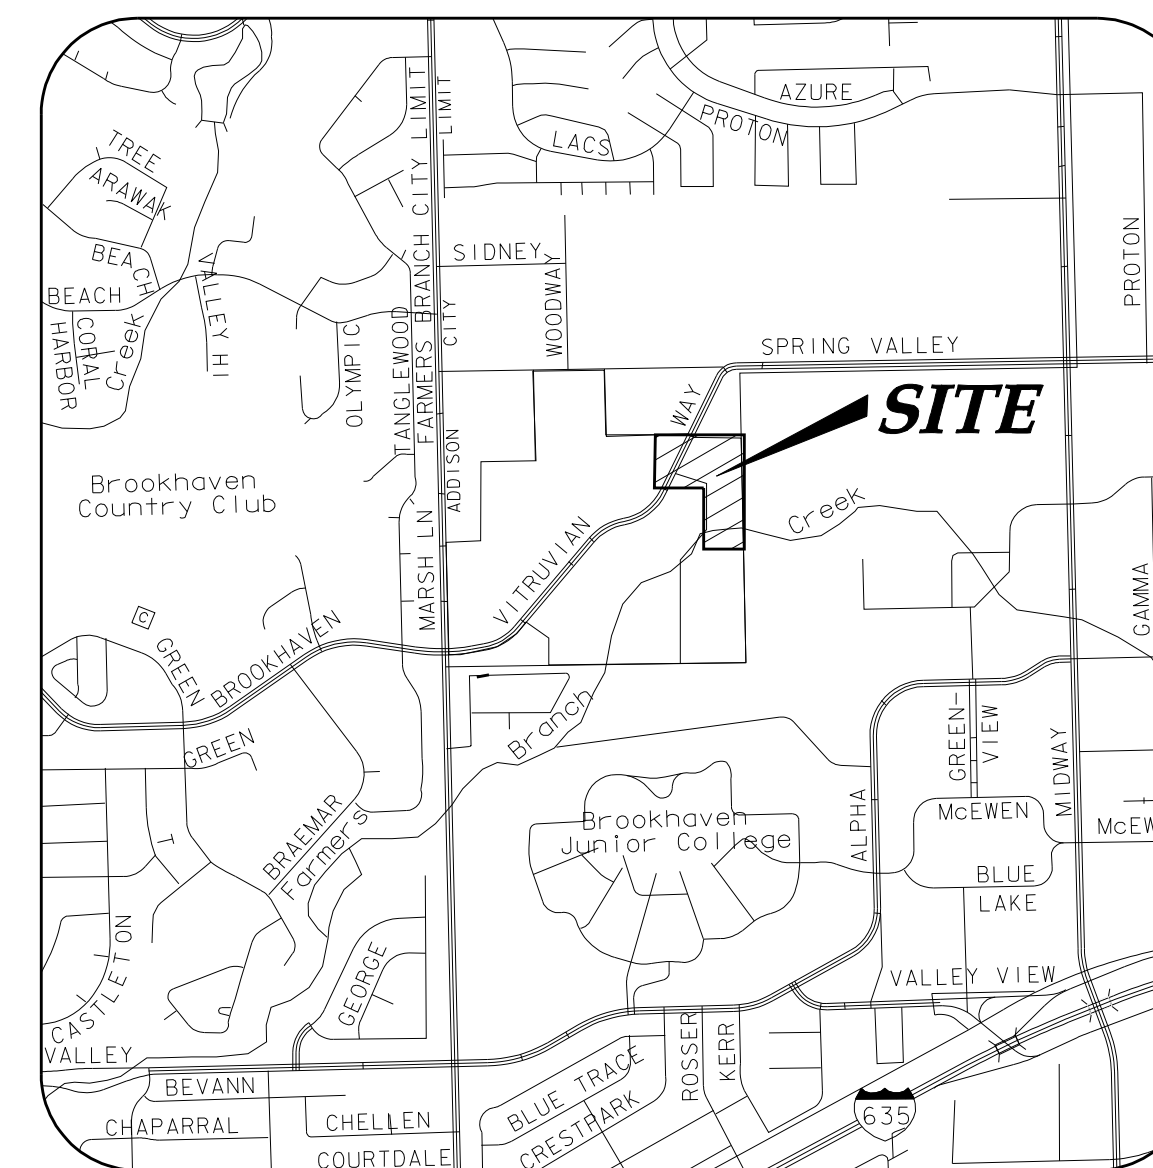

VICINITY MAP


NOT TO SCALE
(MAPSCO GRID 13 & 14)

SHEET INDEX

1	COVER SHEET
2	OVERALL PLAN & PROJECT CONTROL
3	GENERAL CONSTRUCTION NOTES, LEGEND & ABBREVIATIONS
4	DEMOLITION PLAN
5	OVERALL PAVING PLAN & NOTES
6	PAVING PLAN & PROFILE
7	PAVING PLAN & PROFILE
8	PAVEMENT SECTIONS
9	PAVING DETAILS
10	PAVING DETAILS
11	PEDESTRIAN FACILITIES - PED-05 (1)
12	PEDESTRIAN FACILITIES - PED-05 (2)
13	DRAINAGE AREA MAP & CALCULATIONS
14	STORM DRAIN PLAN & PROFILE - LINES A4 & C7
15	STORM DRAIN PLAN & PROFILE - LINES C7 & C13
16	STORM DRAIN LATERAL PROFILES
17	STORM DRAIN DETAILS
18	STORM DRAIN DETAILS & GENERAL NOTES
19	PAVEMENT MARKING & SIGNAGE PLAN
20	PAVEMENT MARKING & SIGNAGE DETAILS
21	STREET LIGHT & CONDUIT PLAN
22	STREET LIGHT DETAILS
23	ELECTRICAL DETAILS - CONDUIT ED(1)-03
24	ELECTRICAL DETAILS - CONDUCTORS ED(2)-03
25	ELECTRICAL DETAILS - GROUND BOXES ED(3)-03
26	ELECTRICAL DETAILS - ELECT SERVICE SUPPORT PEDESTAL TYPE PS ED(8)-03
27	OVERALL WATER & SANITARY SEWER LAYOUT & NOTES
28	WATER LINE PLAN & PROFILE - LINE D
29	WATER LINE PLAN & PROFILE - LINE D
30	WATER LINE CROSSING PROFILES
31	WATER DETAILS
32	WATER DETAILS
33	SANITARY SEWER PLAN & PROFILE - LINE B2
34	SANITARY SEWER DETAILS
35	OVERALL DUCT BANK LAYOUT & NOTES
36	DUCT BANK PLAN & PROFILE - LINE D
37	DUCT BANK PLAN & PROFILE - BELLA LANE CROSSINGS
38	DUCT BANK ELECTRIC DETAILS
39	DUCT BANK ELECTRIC DETAILS
40	EROSION & SEDIMENT CONTROL PLAN
41	EROSION & SEDIMENT CONTROL DETAILS

icon Consulting Engineers, Inc.
Civil Engineers- Designers- Planners
ENGINEERING FIRM REGISTRATION NUMBER F-9007

FEBRUARY 01, 2011

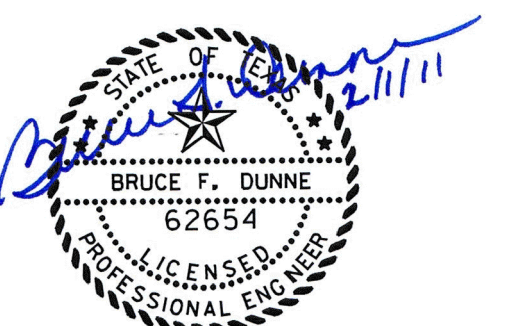

ICON PROJECT #5029-03

RECORD DRAWINGS 06/13/12