STORM DRAIN GENERAL NOTES

- FOR THE GENERAL CONSTRUCTION NOTES FOR THIS PROJECT.
- 2. ALL WORK SHALL BE PERFORMED IN ACCORDANCE WITH STANDARD SPECIFICATIONS FOR STORM DRAINAGE CONSTRUCTION AS PUBLISHED BY NORTH CENTRAL TEXAS COUNCIL OF GOVERNMENTS, AND ANY AND ALL AMENDMENTS BY THE TOWN OF ADDISON, AS WELL AS STANDARD CONSTRUCTION DETAILS OF THE TOWN OF ADDISON.
- 3. PRIOR TO COMMENCING CONSTRUCTION, THE TOWN OF ADDISON, THE CONSULTING ENGINEERS. THE SUCCESSFUL CONTRACTOR, UTILITY COMPANIES, AND ANY OTHER AFFECTED PARTIES, SHALL CONVENE FOR A PRE-CONSTRUCTION CONFERENCE AT 16. THE CONTRACTOR SHALL VERIFY THE SIZE, TYPE, ELEVATION, CONFIGURATION, AND LEAST 48 HOURS PRIOR TO THE BEGINNING OF CONSTRUCTION.
- 4. THE CONTRACTOR SHALL OBTAIN A RIGHT-OF-WAY PERMIT FROM THE TOWN OF ADDISON PRIOR TO WORKING WITHIN THE PUBLIC RIGHT-OF-WAY.
- 5. IT IS THE CONTRACTOR'S RESPONSIBILITY TO CONTACT ANY PUBLIC UTILITY COMPANIES FOR LOCATION OF EXISTING FACILITIES IN OR NEAR THE WORK AREAS. THESE INCLUDE, BUT ARE NOT LIMITED TO THE FOLOWING:

TOWN OF ADDISON (WATER, SEWER, SIGNALS) ATMOS ENERGY (GAS) ONCOR ELECTRIC DELIVERY VERIZON / MCI AT&T (SOUTHWESTERN BELL) TIME-WARNER CABLE


- APPROVAL OF ALL MATERIALS TO BE ADDED TO THE PUBLIC INFRASTRUCTURE, PRIOR TO INCORPORATING MATERIALS INTO THE JOB.
- 7. THE CONTRACTOR SHALL PROVIDE AND SUBMIT TO THE TOWN OF ADDISON (SIX SETS EACH), AN APPROVED TRENCH SAFETY PLAN, SEALED BY A PROFESSIONAL ENGINEER REGISTERED IN THE STATE OF TEXAS, FOR THE INSTALLATION OF STORM DRAINAGE FACILITIES GREATER THAN FIVE (5) FEET IN DEPTH.
- 8. THE CONTRACTOR SHALL FULLY COMPLY WITH, AND SUPPLEMENT AS NECESSARY, THE CONDITIONS OF THE STORM WATER POLLUTION PREVENTION PLAN WHILE CONDUCTING
 22. ALL PIPE ENTERING PUBLIC STORM DRAIN STRUCTURES SHALL BE GROUTED TO ASSURE HIS ACTIVITIES ON THIS PROJECT.
- 9. IT SHALL BE THE RESPONSIBILITY OF THE CONTRACTOR TO IMPLEMENT, AND SUPPLEMENT AS NECESSARY. THE TRAFFIC CONTROL MEASURES ON THIS PROJECT. INCLUDING PROVIDING ADEQUATE FLAGMEN, SIGNAGE, STRIPING AND WARNING DEVICES. ETC., DURING CONSTRUCTION IN ACCORDANCE WITH THE "TEXAS MANUAL OF UNIFORM CONTROL DEVICES". THE CONTRACTOR SHALL MAINTAIN AT LEAST ONE LANE OF TRAFFIC IN EACH DIRECTION DURING WORKING HOURS OR PROVIDE AN ALL-WEATHER

 24. FINISH BACKFILL SHALL BE NATIVE SOIL FREE OF ALL ROCKS AND CLODS GREATER THAN DETOUR AROUND THE CONSTRUCTION SITE, INCLUDING PUBLIC NOTIFICATION AND
- 10. THE TOWN OF ADDISON PUBLIC WORKS DEPARTMENT WILL APPROVE AND/OR 25. CONCRETE COLLARS SHALL BE INSTALLED AT ALL CHANGES IN CONDUIT SIZE AND AT ALL DETERMINE THE TRAFFIC CONTROL PLAN AND WORKING HOURS. CONTACT THE ASSISTANT CITY ENGINEER OR THE PUBLIC WORKS INSPECTOR AT (972) 450-2871.
- 11. TEMPORARY OR PERMANENT BARRICADES SHALL REMAIN AT ALL POINTS OF INGRESS OR 26. THE CONTRACTOR SHALL COMPLETELY REMOVE AND DISPOSE OF EXISTING STORM EGRESS TO PREVENT PUBLIC USE UNTIL THE WORK RECEIVES FINAL ACCEPTANCE.
- 12. THE CONTRACTOR SHALL BE RESPONSIBLE FOR MAINTAINING ADEQUATE DRAINAGE AT STRUCTURES OR IMPROVEMENTS AS NESCESSARY FOR THE SAFETY OF THE PUBLIC.
- PLATING, DURING NON-WORKING HOURS, ALONG EXISTING ROADWAYS AND TRAFFIC
- 14. THE TOWN OF ADDISON WILL PROVIDE A GEOTECHNICAL LABORATORY TO PERFORM APPROPRIATE TESTING DURING CONSTRUCTION ACTIVITIES. ANY TEST THAT FAILS TO MEET CITY REQUIREMENTS SHALL BE RETESTED AT THE CONTRACTORS EXPENSE.


- 1. REFER TO SHEET 3 "GENERAL CONSTRUCTION NOTES, LEGEND AND ABBREVIATIONS" 15. THE CONTRACTOR SHALL PROVIDE A MAINTENANCE BOND FOR PUBLIC INFRASTRUCTURE WORK IN THE FOLLOWING AMOUNTS:
 - 100% FOR VALUATIONS LESS THAN OR EQUAL TO \$5,000.
 - \$5,000 FOR VALUATION GREATER THAN \$5,000. AND LESS THAN \$50,000. 10% FOR VALUATIONS GREATER THAN \$50,000.
 - BONDS SHALL BE FOR A PERIOD OF TWO YEARS BEGINNING WITH THE DATE OF FINAL
 - ANGULATION OF EXISTING STORM DRAIN LINES PRIOR TO CONSTRUCTION OF TIE-IN MATERIALS. THE CONTRACTOR SHALL ASSUME RESPONSIBILITY FOR REPAIRS TO EXISTING FACILITIES DAMAGED BY HIS ACTIVITIES.
 - 17. THE CONTRACTOR SHALL MAKE NECESSARY PROVISIONS FOR THE SUPPORT AND PROTECTION OF ALL UTILITY POLES, FENCES, TREES, SHRUBS, GAS MAINS, TELEPHONE CABLES, ELECTRIC CABLES, DRAINAGE PIPES, UTILITY SERVICES, AND ALL OTHER UTILITIES AND STRUCTURES BOTH ABOVE AND BELOW THE GROUND, THE COST OF WHICH SHALL BE INCLUDED IN THE CONTRACT AMOUNT.
 - 18. ROUGH GRADING SHALL BE COMPLETED PRIOR TO CONSTRUCTION OF STORM DRAIN
- 6. THE CONTRACTOR SHALL PROVIDE SUBMITTALS TO THE ENGINEER (SIX SETS EACH), FOR 19. ALL STORM DRAIN STRUCTURES INCLUDING MANHOLES, INLETS AND CLEANOUTS MUST BE ADJUSTED TO FINAL FINISHED GRADE BY THE CONTRACTOR.
 - 20. ALL PIPE FOR PUBLIC STORM DRAIN IMPROVEMENTS SHALL BE REINFORCED CONCRETE PIPE (RCP), CLASS III, UNLESS OTHERWISE NOTED. REINFORCED CONCRETE PIPE JOINTS SHALL BE SEALED WITH RAMNECK OR APPROVED EQUAL.
 - 21. ALL STORM SEWER SYSTEMS WITH RADII LESS THAN 100' SHALL UTILIZE 4' LONG PIPE JOINTS WITH BEVELED ENDS (B-2 RADIUS PIPE). ALL JOINTS MUST BE TIGHT AND SHALL NOT GAP MORE THAN ¼ THE TOUNGE LENGTH.
 - WATERTIGHT CONNECTIONS.
 - 23. EMBEDMENT FOR STORM DRAIN PIPING SHALL CONSIST OF GRADE 4 CRUSHED STONE (3* BELOW PIPE FOR 27" AND SMALLER PIPES, AND 4" BELOW PIPE FOR 30" PIPES AND LARGER) TO THE CRADLE OF THE PIPE, WITH SELECT NATIVE SOIL LESS THAN 3" IN DIAMETER OR GRANULAR MATERIAL TO 6" OVER THE TOP OF PIPE.
 - THREE INCHES IN DIAMETER, COMPACTED TO 95% STANDARD PROCTOR DENSITY, IN SIX (6) INCH MAXIMUM LOOSE LIFTS, WITH ZERO TO PLUS THREE, OPTIMUM MOISTURE.
 - JOINTS THAT ARE PULLED IN EXCESS OF THAT RECOMMENDED BY THE CONDUIT
 - DRAIN FACILITIES, DESIGNATED TO BE REMOVED, UPON COMPLETION AND ACCEPTANCE OF NEW STORM DRAINAGE FACILITIES.
- ALL TIMES DURING CONSTRUCTION, INCLUDING PROVIDING ALL TEMPORARY 27. ALL STORM DRAIN PIPE SHALL BE CAMERA INSPECTED BY THE CONTRACTOR AFTER THE INSTALLATION OF ALL UTILITIES AND PRIOR TO FINAL ACCEPTANCE OF THE PROJECT.
- 13. THE CONTRACTOR SHALL COVER ALL OPEN EXCAVATIONS WITH ANCHORED STEEL 28. THE CONTRACTOR SHALL CALL (972) 450-2847 TO REQUEST A FINAL WALK-THROUGH INSPECTION OF THE PUBLIC INFRASTRUCTURE WORK.
 - 29. ANY ADJACENT PROPERTIES AFFECTED BY THE CONSTRUCTION SHALL BE RESTORED TO PRE-CONSTRUCTION CONDITIONS, OR BETTER.

							TEEL S						
INLET LENGTH	BAR TYPE	BAR DIA. (1/8")	NO. REQ'D.	BAR DIMENSIONS			INLET	BAR	BAR	NO.	BAR DIMENSIONS		
				A	В	С	LENGTH	TÝPĚ	ĎĺÄ. (1/8")	REQ'D.	A	В	С
6'	Α	3	15	3'-2"	0'-6"	_	8'	Α	3	19	3'-2"	0'-6"	_
	В	3	2	11'-6"	_	_		В	3	2	15'-6"	_	_
	С	4	16	13'-4"	0'-6"	_		С	4	16	17'-4"	0'-6"	_
	D	4	9	4'-8"	_	_		D	4	9	4'-8"	_	_
	E	5	6	13'-4"	_	_		E	5	6	17'-4"	_	_
	F	4	5	1'-2"	_	_		F	4	5	1'-2"	_	_
	G	3	12	2'-0"	1'-3"	_		G	3	12	2'-0"	1'-3"	_
	Н	3	26	*	*	*		Н	3	26	*	*	*
	I	4	12	4'-8"	3'-2"	3'-2"		ı	4	16	4'-8"	3'-2"	3'-2"
	J	5	1	*	*	*		J	5	1	*	*	*
	K	5	6	3'-2"	0'-6"	_		K	5	6	3'-2"	0'-6"	_
	L	4	11	3'-2"	0'-6"	_		L	4	11	3'-2"	0'-6"	_
	М	4	2	3'-0"**	_	_		М	4	2	3'-0"**	_	_
	N	4	2	4'-8"	3'-2"	4'-8"		N	4	2	4'-8"	3'-2"	4'-8"
7'	Α	3	17	3'-2"	0'-6"	_	10'	Α	3	23	3'-2"	0'-6"	_
	В	3	2	13'-6"	_	_		В	3	2	19'-6"	-	_
	С	4	16	15'-4"	0'-6"	_		С	4	16	21'-4"	0'-6"	_
	D	4	9	4'-8"	_	_		D	4	9	4'-8"	_	_
	Е	5	6	15'-4"	_	_		Е	5	6	21'-4"	_	_
	F	4	5	1'-2"	_	_		F	4	5	1'-2"	_	_
	G	3	15	2'-0"	1'-3"	_		G	3	15	2'-0"	1'-3"	_
	Н	3	32	*	*	*		Н	3	32	*	*	*
	I	4	14	4'-8"	3'-2"	3'-2"		I	4	20	4'-8"	3'-2"	3'-2"
	J	5	1	*	*	*		J	5	1	*	*	*
	K	5	6	3'-2"	0'-6"	_		K	5	6	3'-2"	0'-6"	-
	L	4	11	3'-2"	0'-6"	_		L	4	11	3'-2"	0'-6"	_
	М	4	2	3'-0"**	_	_		М	4	2	3'-0"**	_	_
	N	4	2	4'-8"	3'-2"	4'-8"		N	4	2	4'-8"	3'-2"	4'-8"

* SEE DIAGRAM FOR DIMENSION
** FIELD CUT AS REQUIRED TO ACCOMMODATE DRAIN PIPE

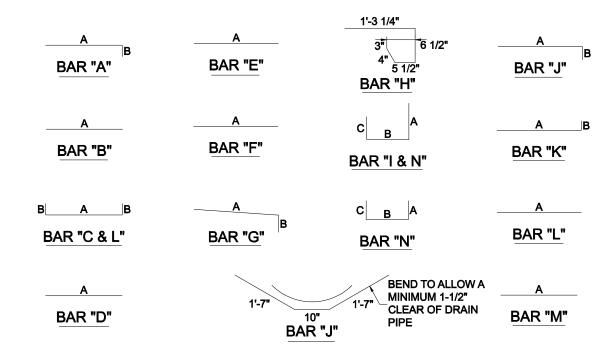

STANDARD CURB INLET

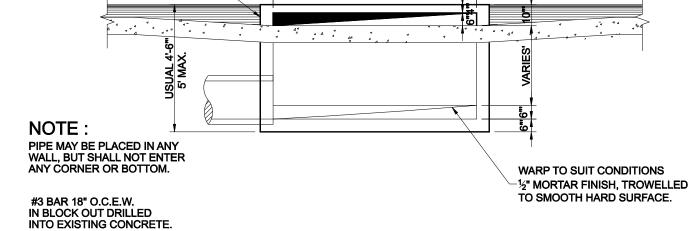

LIMITS OF BLOCKOUT'

FACE OF CURB

VARIABLE HEIGHT CURE

EXPANSION JOINT

LIMITS OF BLOCKOUT'

INLET FRAME (LOCATION ON

END OF PIPE)

VARIABLE HEIGHT CURI

BAR DIAGRAMS

1/2" LETTERING $^{\circ}$ -SPECIAL LOGO KEYED LOCK AREA 1/2" LETTERING (changed annually) LETTERING **BOTTOM VIEW** 18 7/8" **COVER SECTION** 3 13/16" 18 3/4" **RING SECTION**

♦ DESIGNATES MACHINE SURFACE

DIPPED

LOAD RATING

LIGHT DUTY

INLET COVER

NON-TRAFFIC

INLET RING

INLET FRAME AND COVER

COVER: 60 LBS

FRAME: 151 LBS

MATERIAL SPECIFICATION **COVER - GRAY IRON**

FRAME - GRAY IRON


ASTM A48 CL35B

ASTM A48 CL35B

GENERAL NOTES

- 1. ALL CONCRETE DRAINAGE STRUCTURES SHALL HAVE A MINIMUM COMPRESSED STRENGTH OF 3600 P.S.I.
- 2. ALL CRUSHED STONE SHALL BE 3/4", PASSING #4 SIEVE.
- 3. ALL FIELD JOINTS WILL BE APPROVED BY THE CITY ENGINEER IF NECESSARY. FIELD JOINTS SHALL BE WIPED ON THE INSIDE AND OUTSIDE TO PROVIDE FOR SMOOTH FLOW OF WATER.
- 4. RAMNECK COMPOUND OR APPROVED EQUAL SHALL BE USED FOR JOINT SEALS.
- 5. ALL STORM SEWER PIPE SHALL BE CAMERA INSPECTED AFTER THE INSTALLATION OF ALL PAVING, UTILITIES, AND PRIOR TO FINAL ACCEPTANCE OF THE PROJECT.



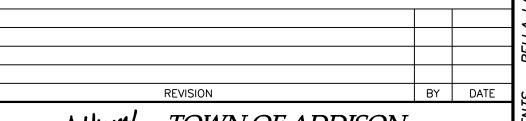



TOWN OF ADDISON DALLAS COUNTY, TEXAS

PAVING, DRAINAGE & UTILITY IMPROVEMENTS BELLA LANE

STORM DRAIN DETAILS & **GENERAL NOTES**

Consulting Engineers, Inc. Civil Engineers - Designers - Planners 250 W. Southlake Blvd., Suite 1 Southlake, Tx 76092 (817) 552-62								
PROJECT	DESIGN	DRAWN	DATE	FILE	SHEET			
029-03	ICE	ICE	FEB 01, 2011	PW# 2010-08	18			

RECORD DRAWINGS 06/13/12