
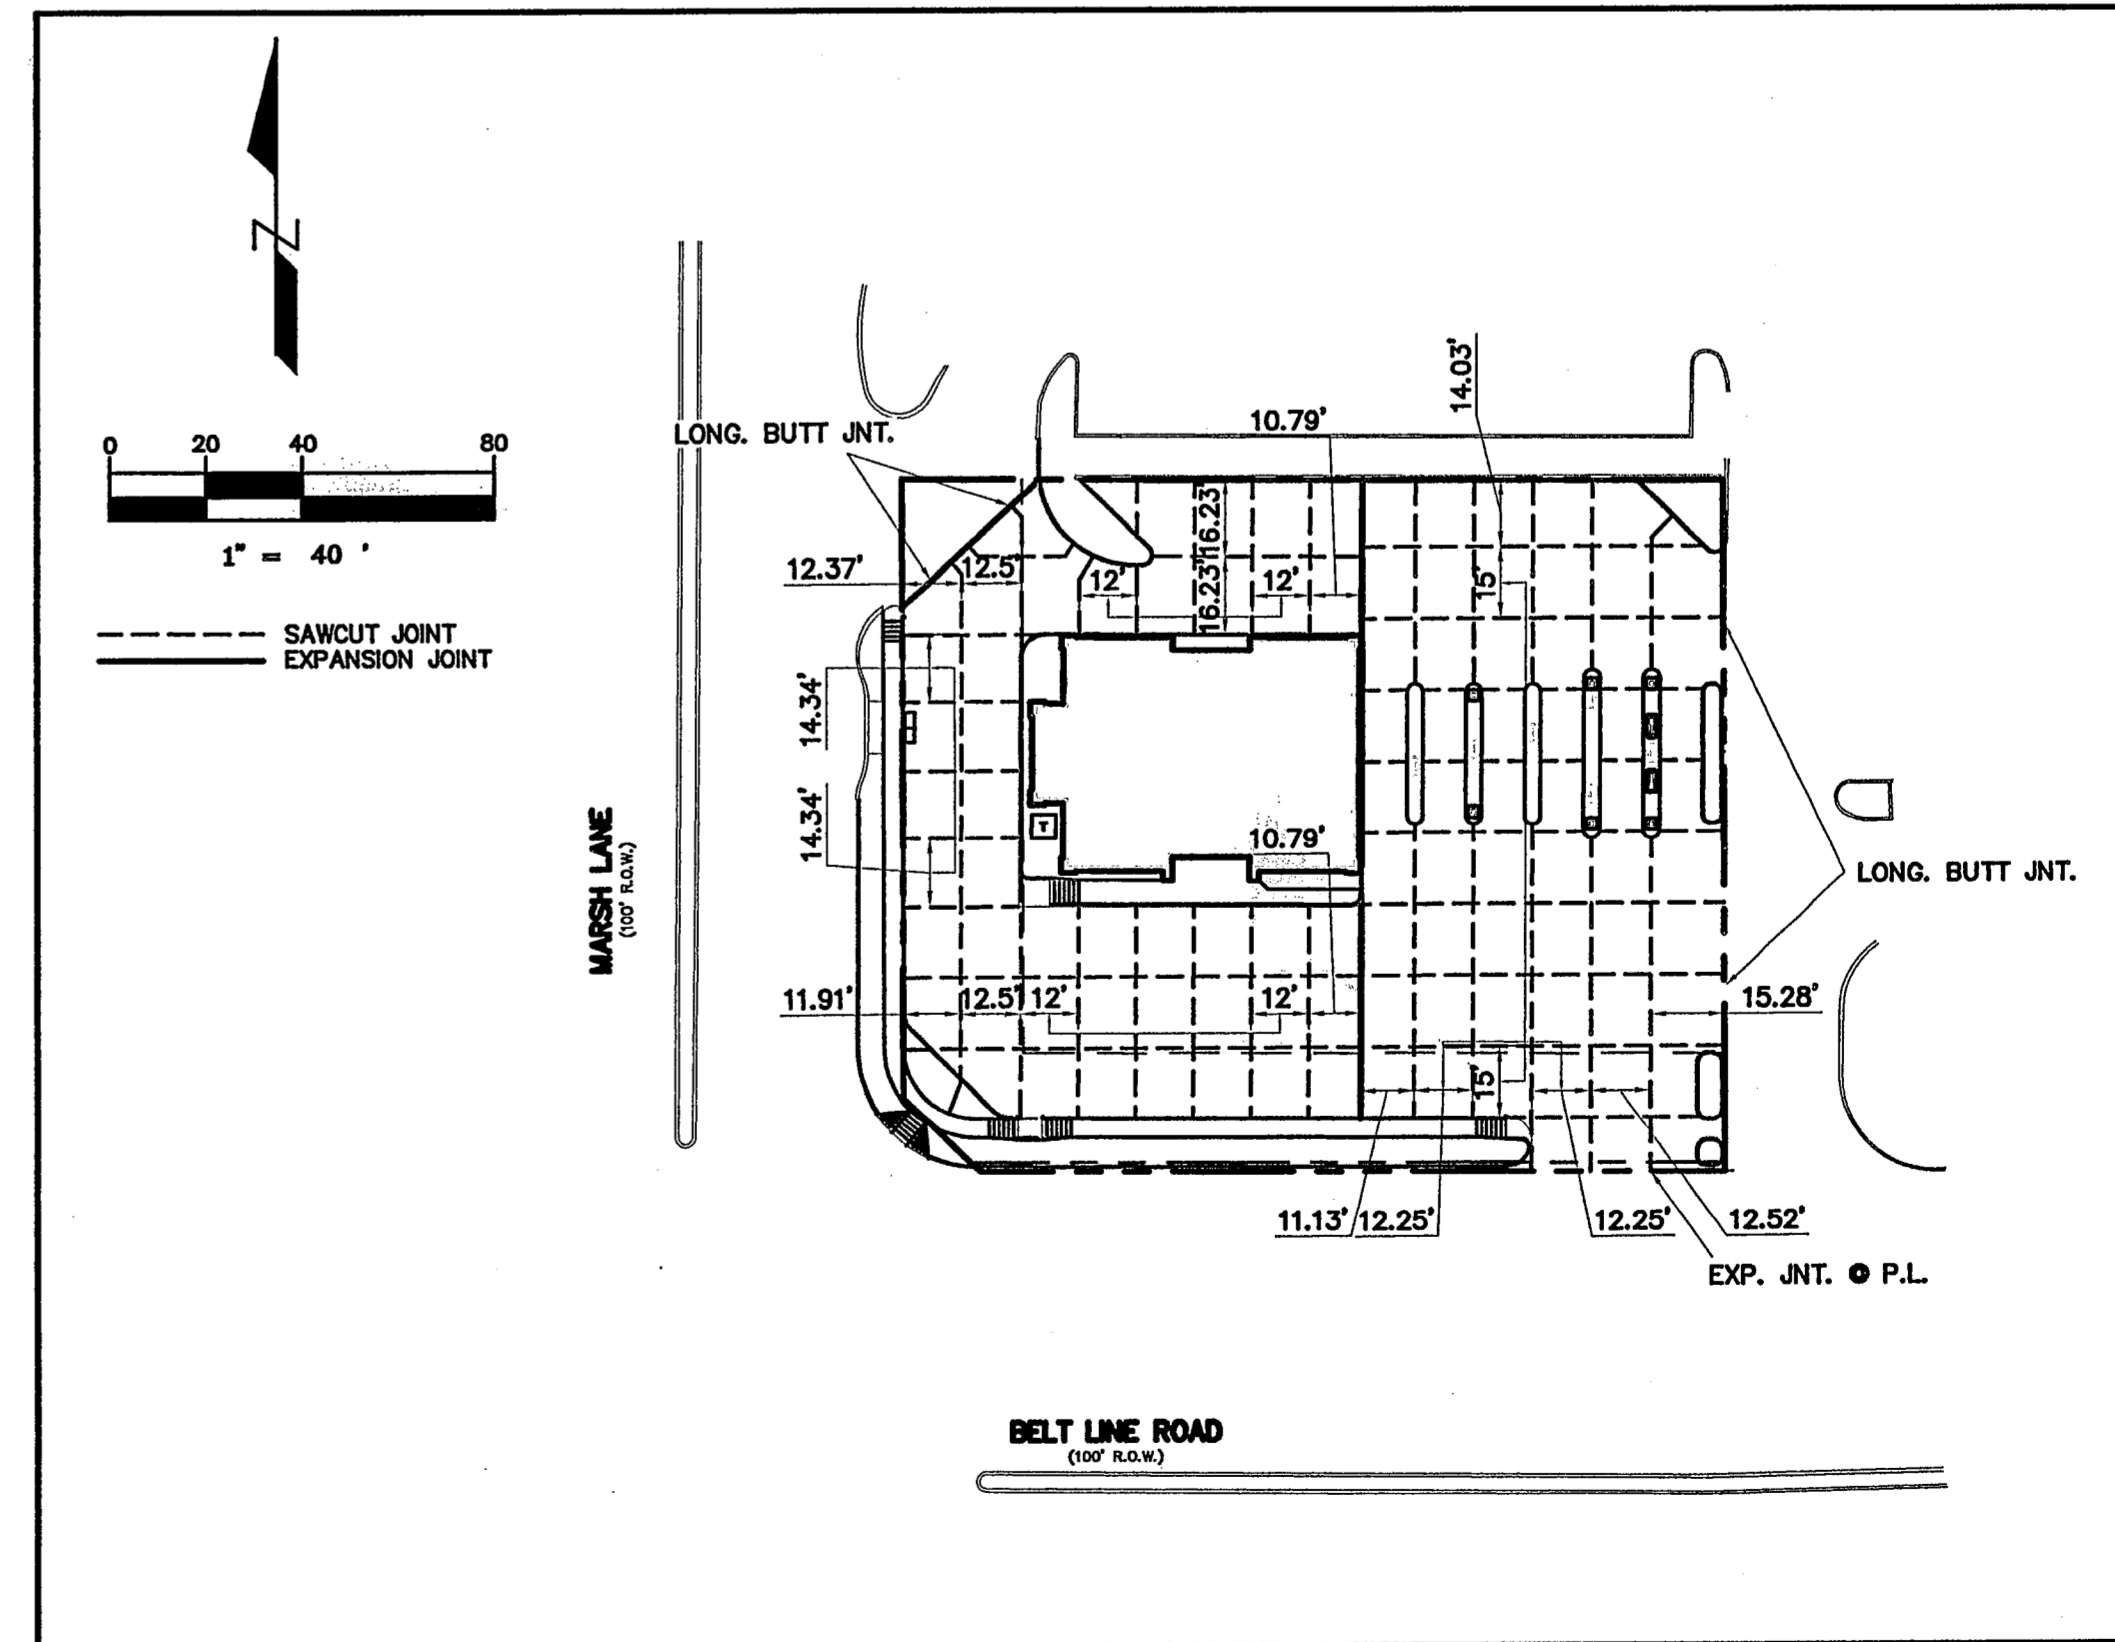
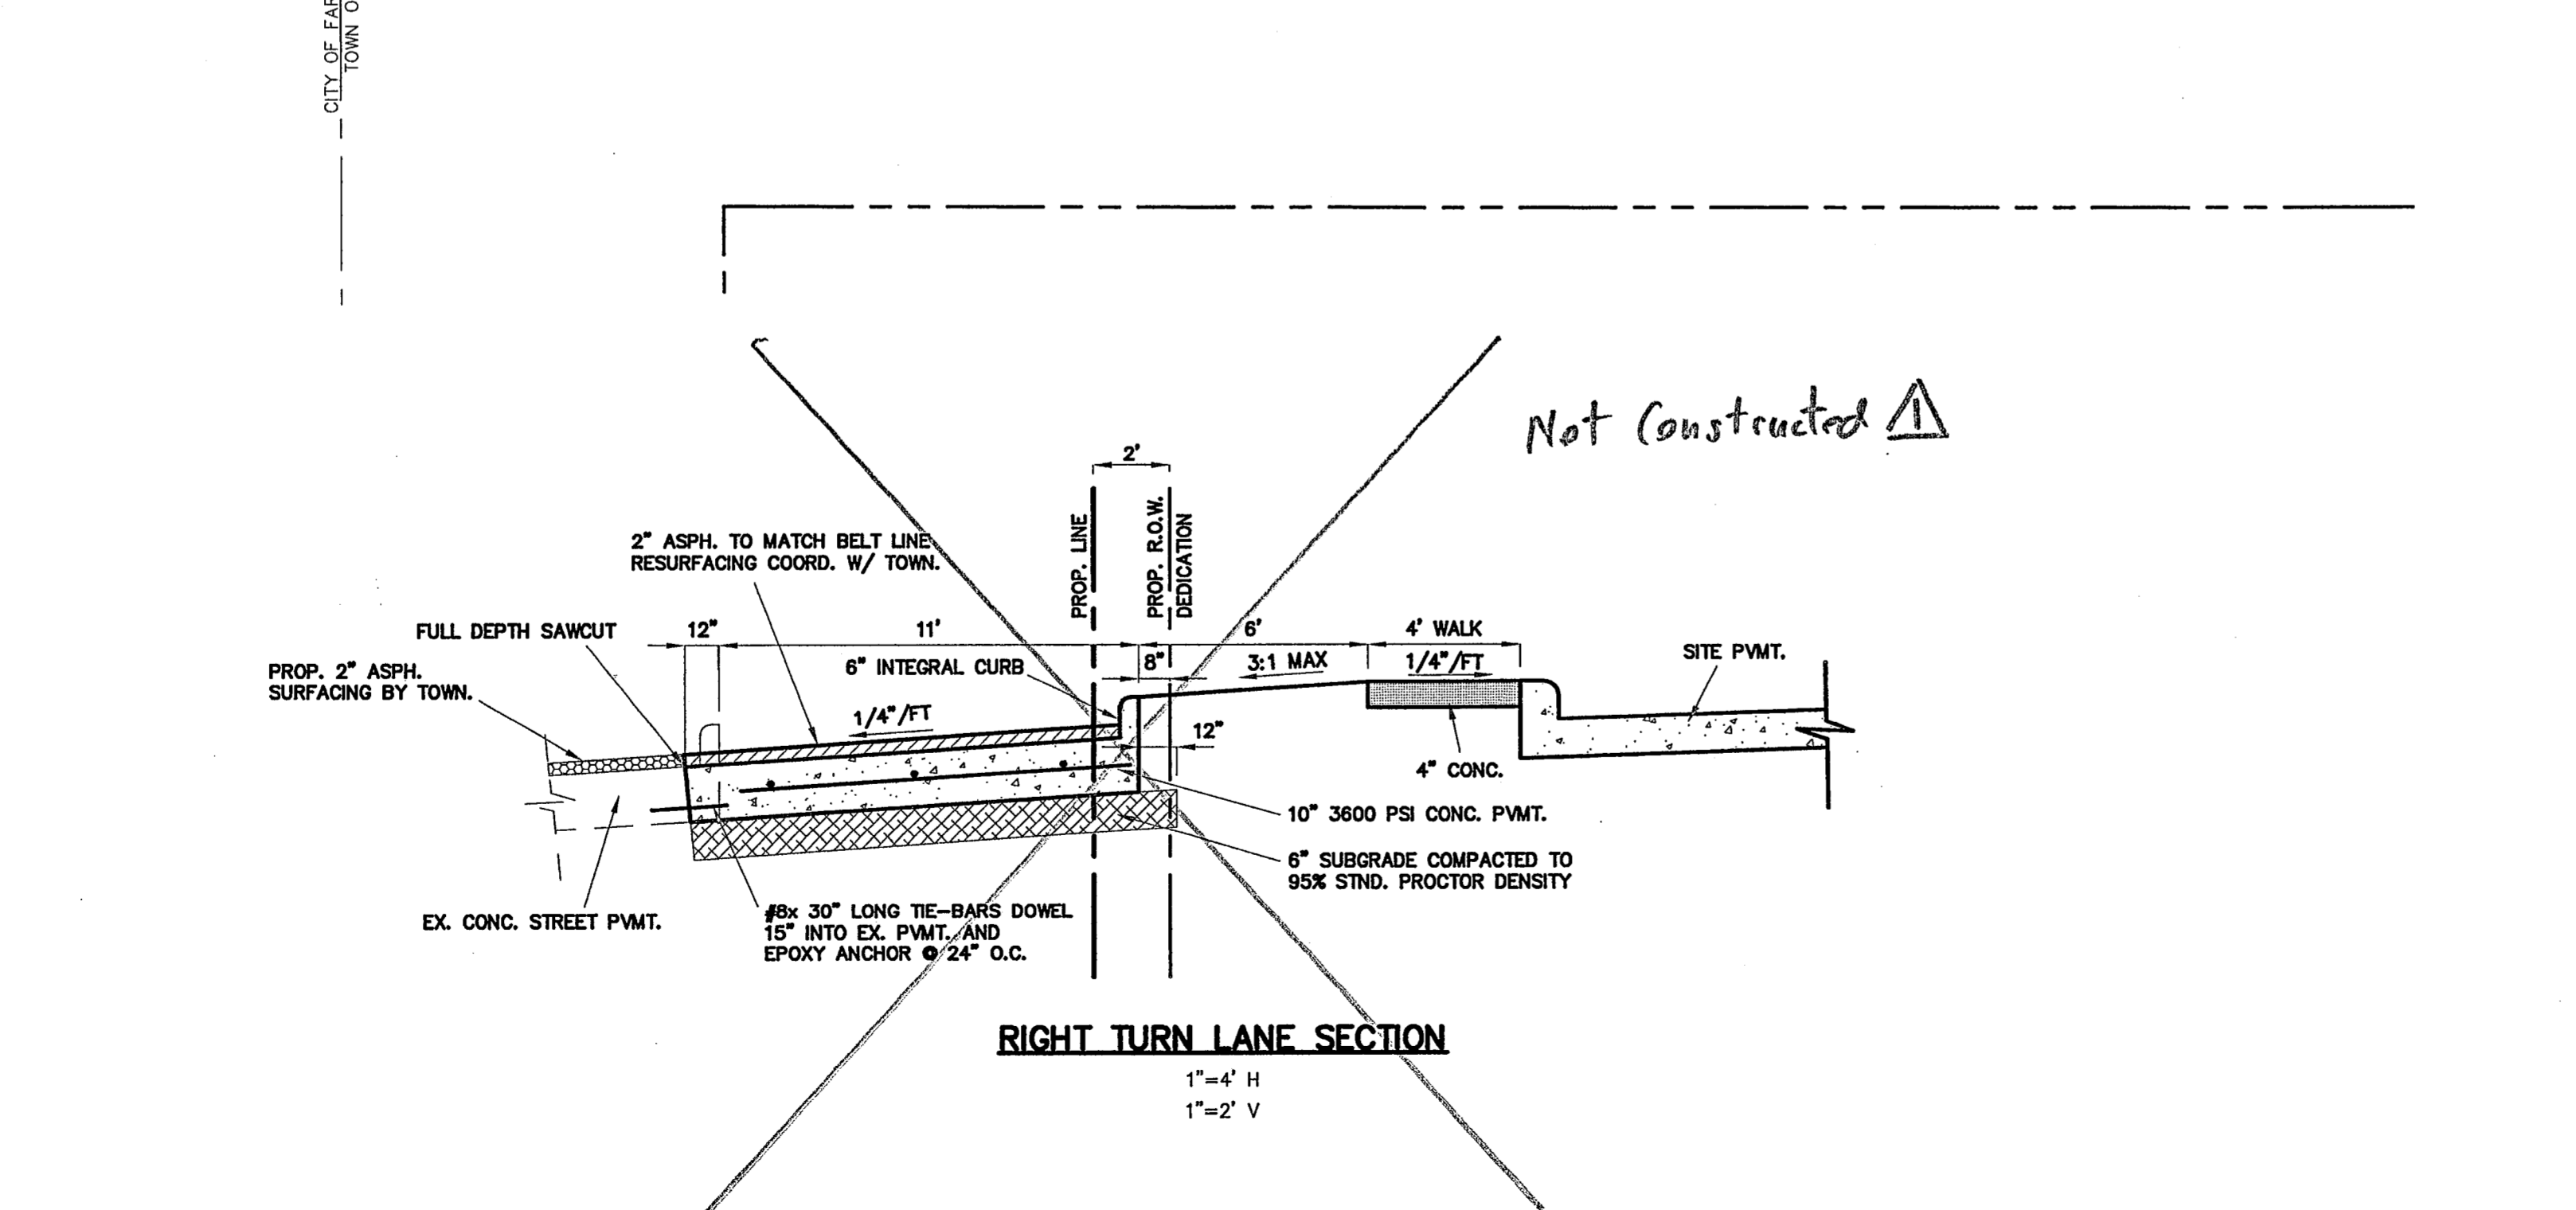




\\Snap-a-drawings\Land Projects\2004\310-03.dwg\01C02PAV.dwg 11/9/2004 9:48:20 AM CST

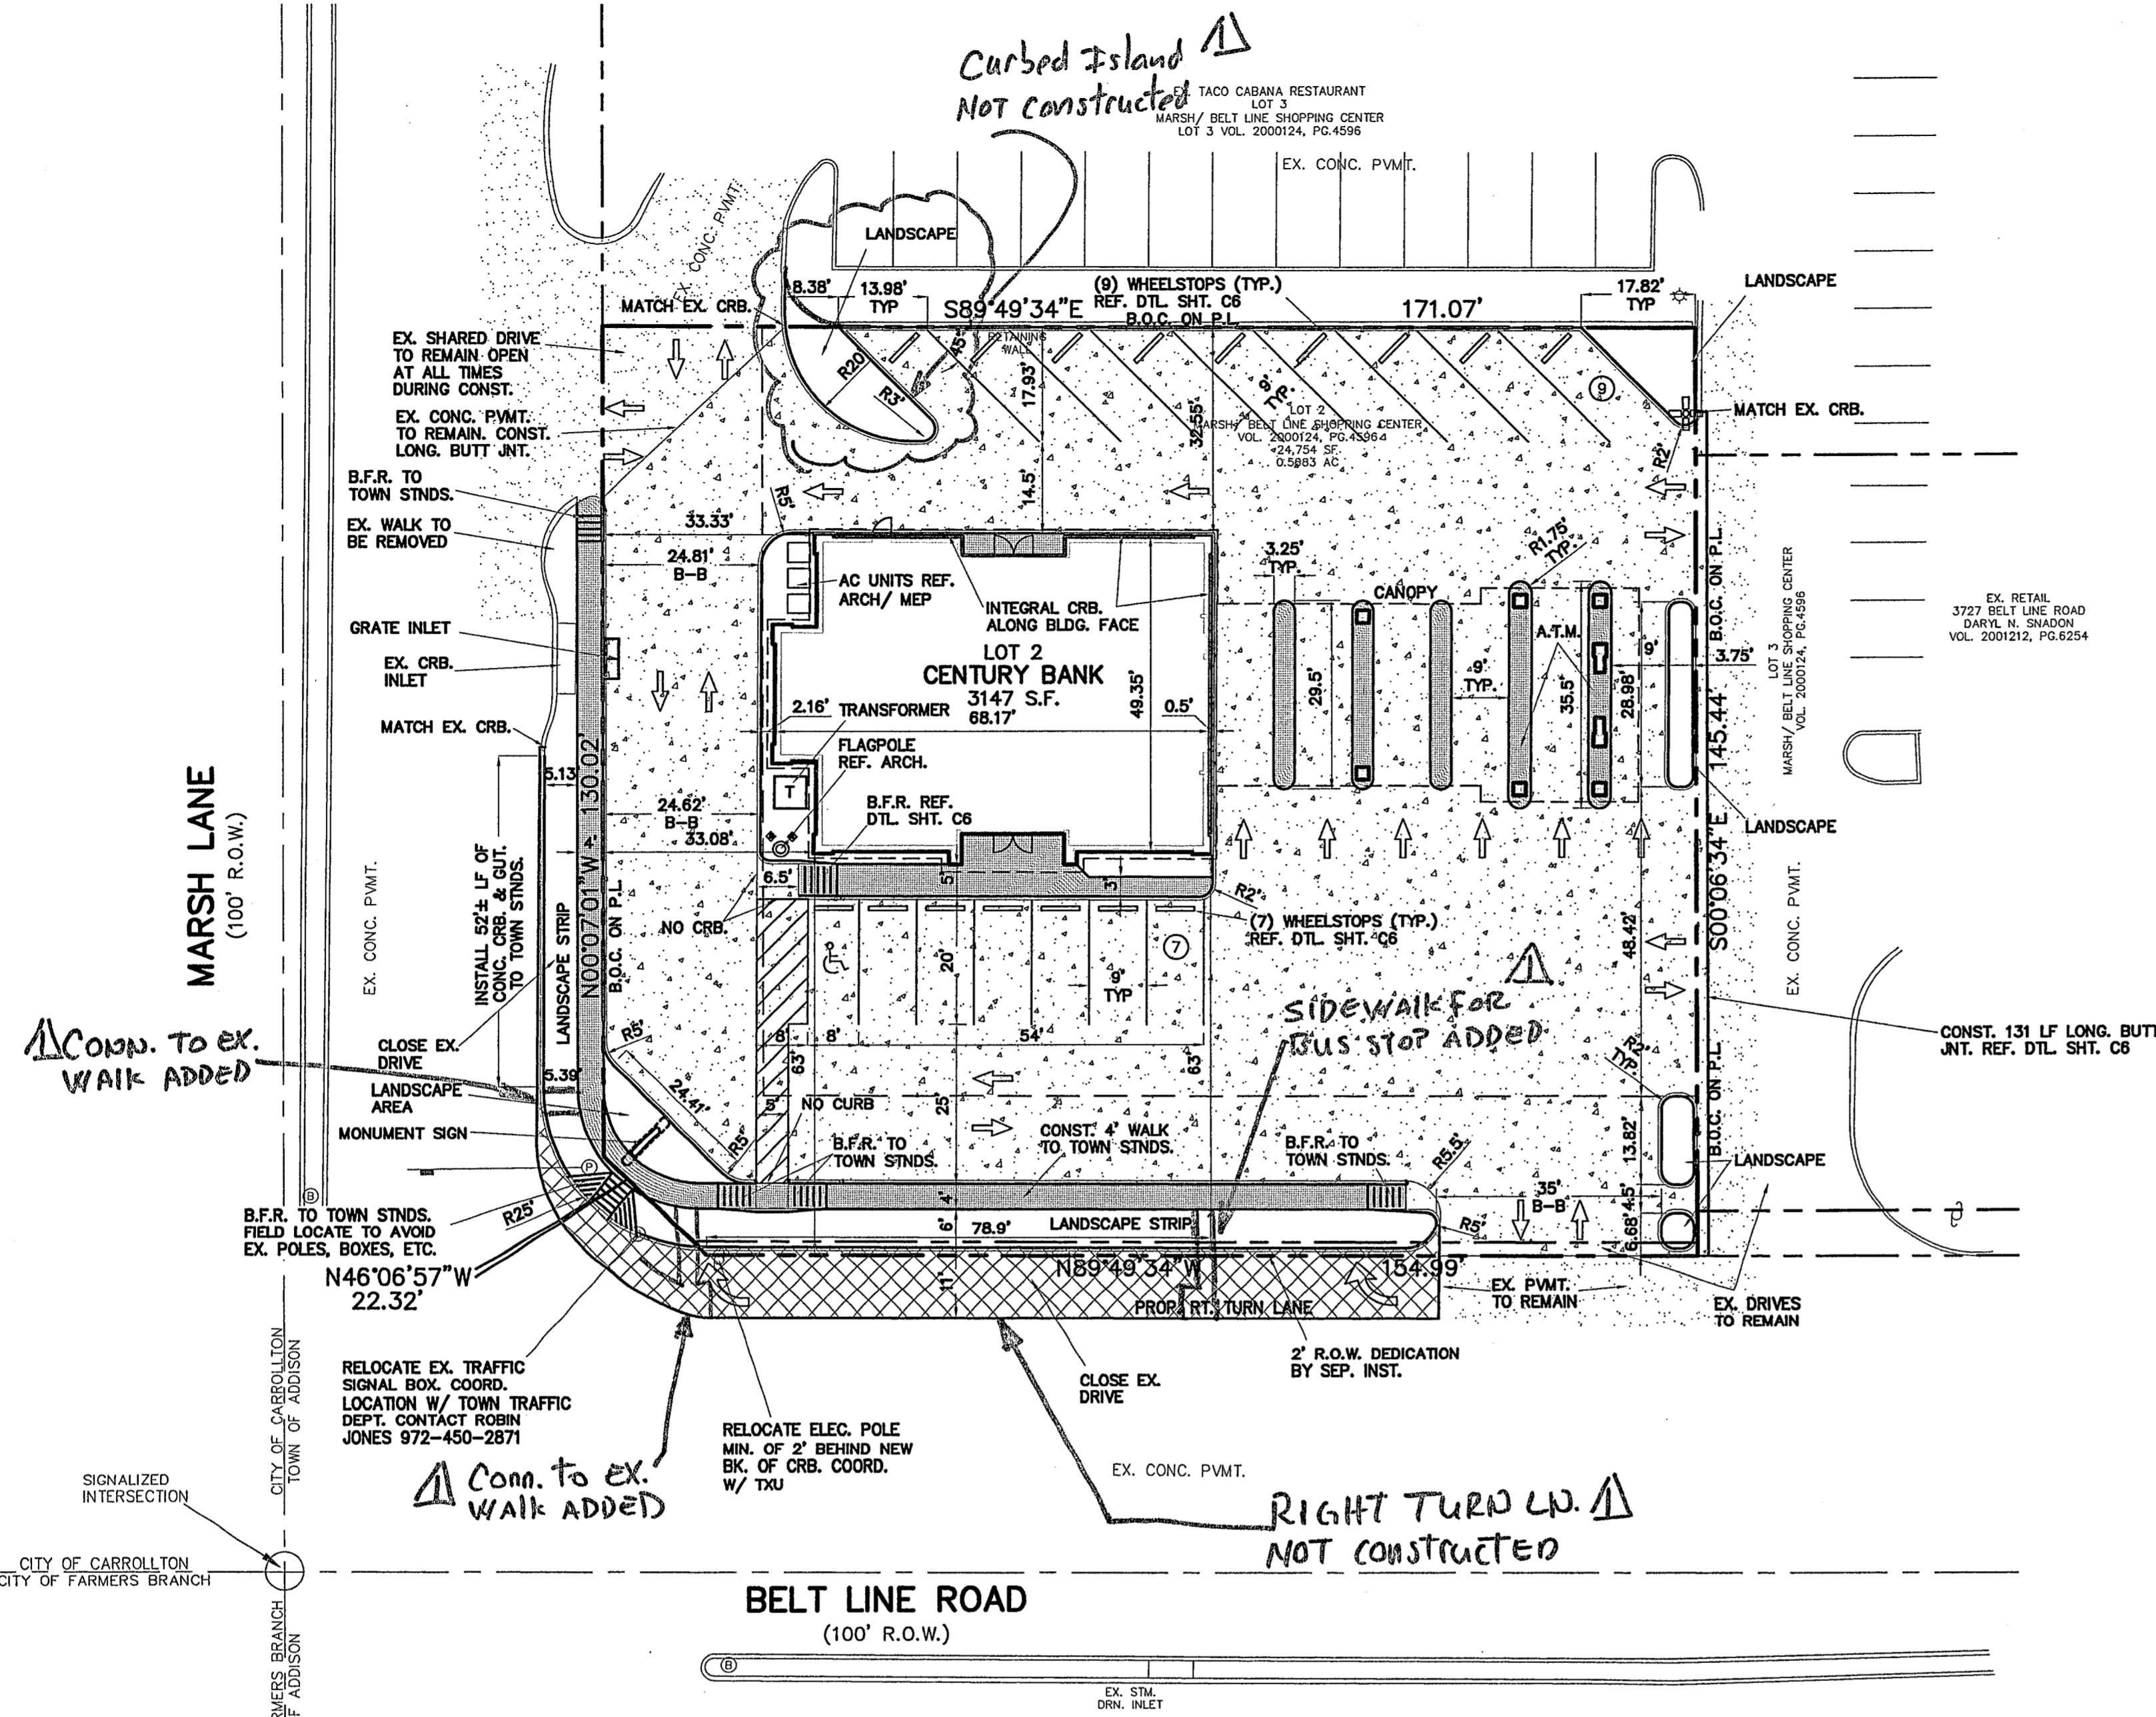

BENCHMARK
 SQUARE CUT ON THE CENTERLINE OF AN INLET AT THE INTERSECTION OF MARSH LANE AND BELT LINE ROAD.
 ELEVATION = 585.21

- LEGEND**
- PROP. 4" SIDEWALK
 - PROP. 6" PAVEMENT
 - PROP. STREET P.W.M.T. (REF. DTL. THIS SHT.)
 - PROPOSED 6" INTEGRAL CURB
 - PROPOSED SITE LIGHT POLE
 - EXISTING PAVEMENT

- GENERAL NOTES**
1. Boundary Survey by Peiser Survey dated 10/15/04.
 2. All dimensions are to edge of pavement, face of building or back of curb, unless otherwise noted.
 3. Building and new parking layout is parallel and perpendicular to the south property line.
 4. All curb radii not called out are 2' measured at back of curb.
 5. See sheet C6 for General Notes, Paving Notes and details.
 6. Refer to Architectural plans for building dimensions.
 7. Install all handicap striping, signage, markings and ramp finishes in accordance with the latest ADA and TAS standards.
 8. See Architectural Plans for flag pole and site light details.

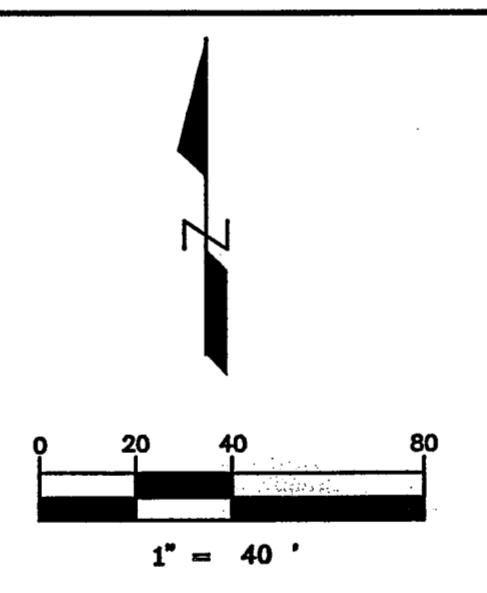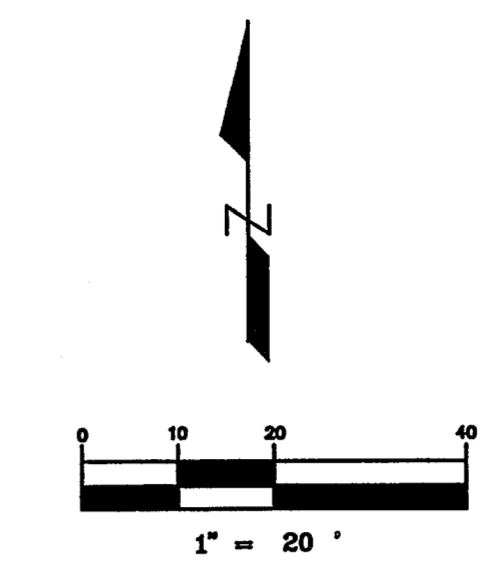

CONSTRUCTION RECORDS
 DATE: 4/15/05 BY: J.J.V.
 THIS DRAWING INDICATES THE WORK COMPLETED PER INFORMATION SUPPLIED BY THE CONTRACTOR, ACTUAL ON THE GROUND SURVEY VERIFICATION WAS NOT PERFORMED EXCEPT AS SPECIFICALLY NOTED.

JOINT LAYOUT
 1"=40'

NO.	DATE	NOTE
1		
2		
3		
4		
5		

APPROVED
 J.J.V.
 DATE: 11/9/04

TOMDEN ENGINEERING, L.L.P.
 12655 N. Central Expy., Suite 1016
 Dallas, Texas 75243
 Ph: 972.386.6446 Fax: 972.386.6409
 mail@tomden.com

DESIGNED BY
 MR. BILL PATTON
 ARCHITECT
 8810 LIVE OAK LANE
 TEARARKANA, AR 71854

CHECKED BY
 MR. MICHAEL DR.
 CENTURY BANK
 2900 ST. MICHAEL DR.
 TARRANT, TX 76178

LAYOUT & PAVING PLAN

Scale: 1" = 20'
 Designed by: J.J.V.
 Drawn by: J.K.A.
 Checked by: J.J.V.
 S:\LP\2004\310-03.dwg\01C02PAV
 Date: 11/09/04 09:48

SHEET
C2
 OF
6