


**AS-BUILT**

NOTE:  
THESE PLANS HAVE BEEN REVISED  
TO CONFORM WITH CONSTRUCTION  
RECORDS PROVIDED BY CONTRACTOR.

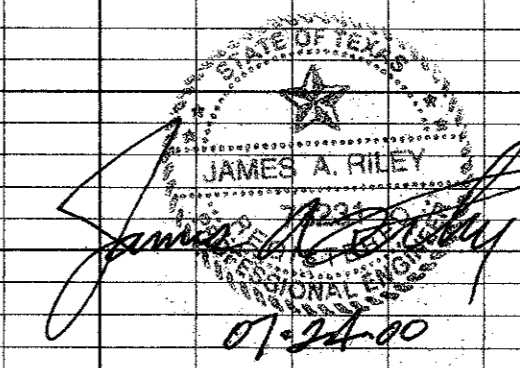

<b>PROFILES</b>						
MARSH / BELT LINE SHOPPING CENTER						
TOWN OF ADDISON						
DALLAS COUNTY, TEXAS						
<input type="checkbox"/> BROCKETTE · DAVIS · DRAKE, inc. <input type="checkbox"/> consulting engineers						
Civil & Structural Engineering Surveying 4144 North Central Expressway, Suite 1100 Dallas, Texas 75204 Tel. (214) 824-3647 Fax (214) 824-7064						
DESIGN	DRAWN	DATE	SCALE	NOTES	FILE	NO.
JAR	FG	7/24/00	H: 1"=20' V: 1"=6'	BDD	C99158	C-8