


# SWP-CI "Big Red" <sup>TM</sup>

## Curb Inlet Protector

By ASP Enterprises and Storm Water Products

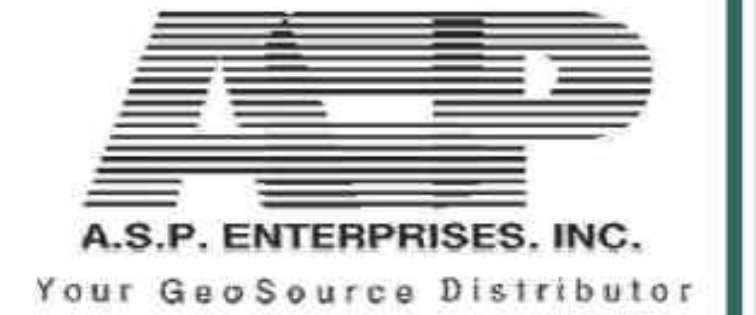

### Specifications:

1. Infill Material: shredded recycled rubber tires
2. Weight: approx. 10 lbs per linear foot
3. Diameter: approx. 8"

Geotextile fabric made of durable high flow fabric with the following properties:


Property	Test Method	Units	Typical Value
Weight	ASTM D5261	oz/sq. yd	9.3
Grab Tensile Strength	ASTM D4632	lb	warp 250
			fill 290
Tear Strength (Trapezoid)	ASTM D4533	lb	warp 60
			fill 50
Burst	ASTM D3786	psi	440

(Efforts were made to determine flow rate-the fabric exceeded all capacities of the testing equipment)



ASP Enterprises and Storm Water Products assumes no liability for the accuracy or completeness of this information or for the ultimate use by the purchaser. ASP and SWP disclaims any and all express, implied, or statutory standards, warranties or guarantees, including without limitation any implied warranty as to merchantability or fitness for a particular purpose or arising from a course of dealing or usage of trade as to any equipment, materials or information furnished herewith. This document should not be construed as engineering advice.

AS-BUILT DRAWING BASED SOLELY ON A SKETCH PROVIDED BY COYOTE CONTRACTORS DATED 7-19-2017. CEI ENGINEERING ASSUMES NO RESPONSIBILITY FOR THE ACCURACY OR COMPLETENESS OF THIS PLAN

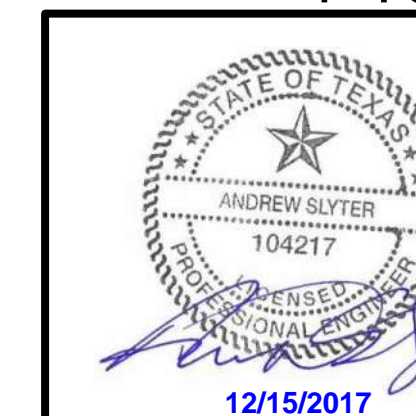

26873	7/24/17	ADS	JEE	JPS	JPS
CEI PROJECT NO.	INITIAL DATE	DPOR	PM	DES	DRW
<b>CEI Engineering Associates, Inc.</b>					
ENGINEERS • PLANNERS • SURVEYORS LANDSCAPE ARCHITECTS • ENVIRONMENTAL SCIENTISTS					
4800 Sugar Grove Blvd, Suite 316 (281)494-0309 Stafford, TX 77477 (281)494-0360					
<b>KROGER SW870 FUEL CENTER</b>					
3770 BELTLINE RD TX					
ADDISON TX					
DETAIL SHEET 2				REV DATE 7/24/17	SHEET NO. C9