



AS BUILT  
DATE 11/17/94

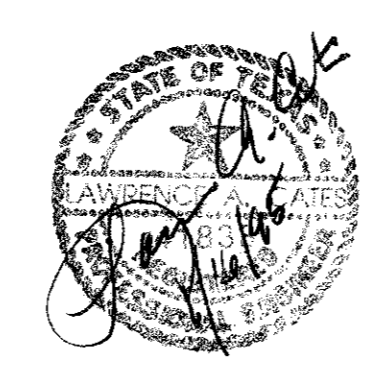

AS-BUILTS  
I CERTIFY THIS PROJECT WAS CONSTRUCTED IN GENERAL CONFORMANCE WITH THESE CONSTRUCTION PLANS AND WILL FUNCTION AS DESIGNED.

BENCHMARK:  
"□" ON TOP OF CURB OF CENTERLINE OF INLET  
NORTHEAST CORNER OF APPLEBEE'S PARKING LOT  
100' MORE OR LESS WEST OF THE WEST CURB OF  
BUSINESS AVENUE. ELEVATION = 605.65

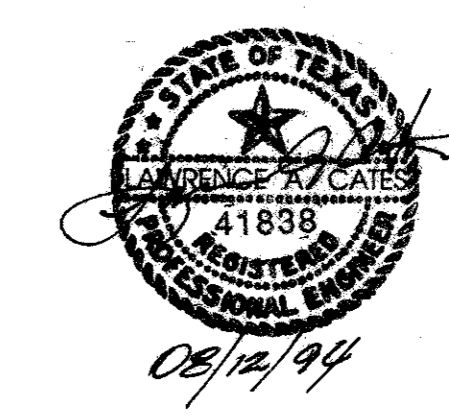

STORM SEWER PROFILE						
CHICK-FIL-A						
BELTLINE RD. // MARSH LN.						
THE CITY OF ADDISON, TEXAS						
LAWRENCE A. GATES & ASSOC. ENGINEERS						
DESIGN	DRAWN	DATE	SCALE	NOTES	FILE	NO.
LAC	LAC	8/12/94	H: 1/8" = 20' V: 1" = 6'	D.P.	94062	