


SITE DEVELOPMENT PLANS FOR
CAPITAL ONE
 LOCATED AT THE INTERSECTION OF
3790 BELT LINE ROAD & BUSINESS AVENUE
ADDISON, TEXAS


NOVEMBER 8, 2006

C&B PROJECT NO. 293070.020

GREATER DALLAS/FORT WORTH

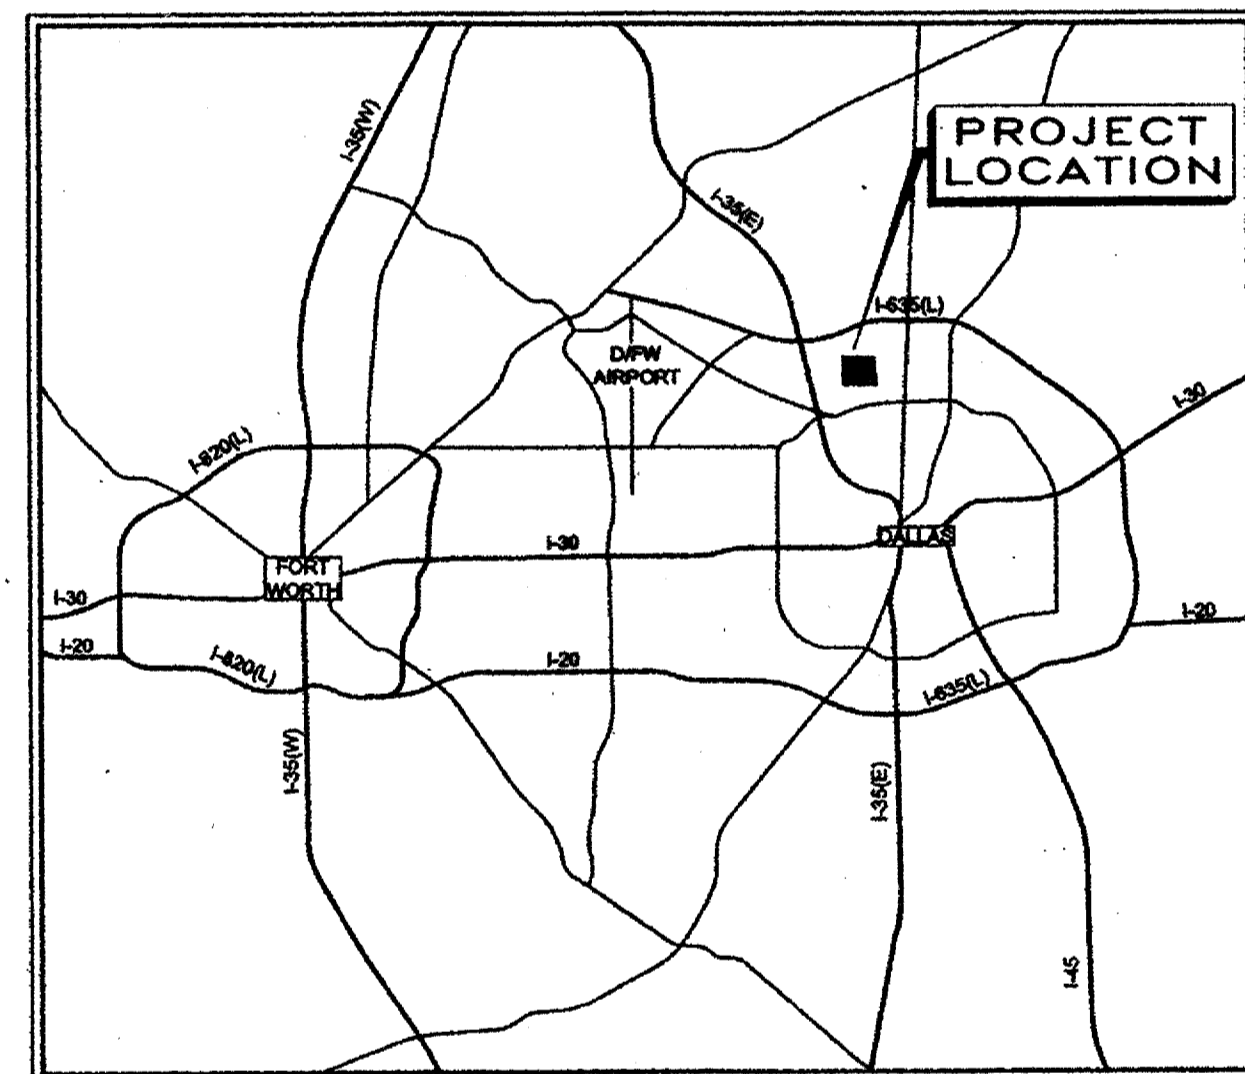

VICINITY MAP

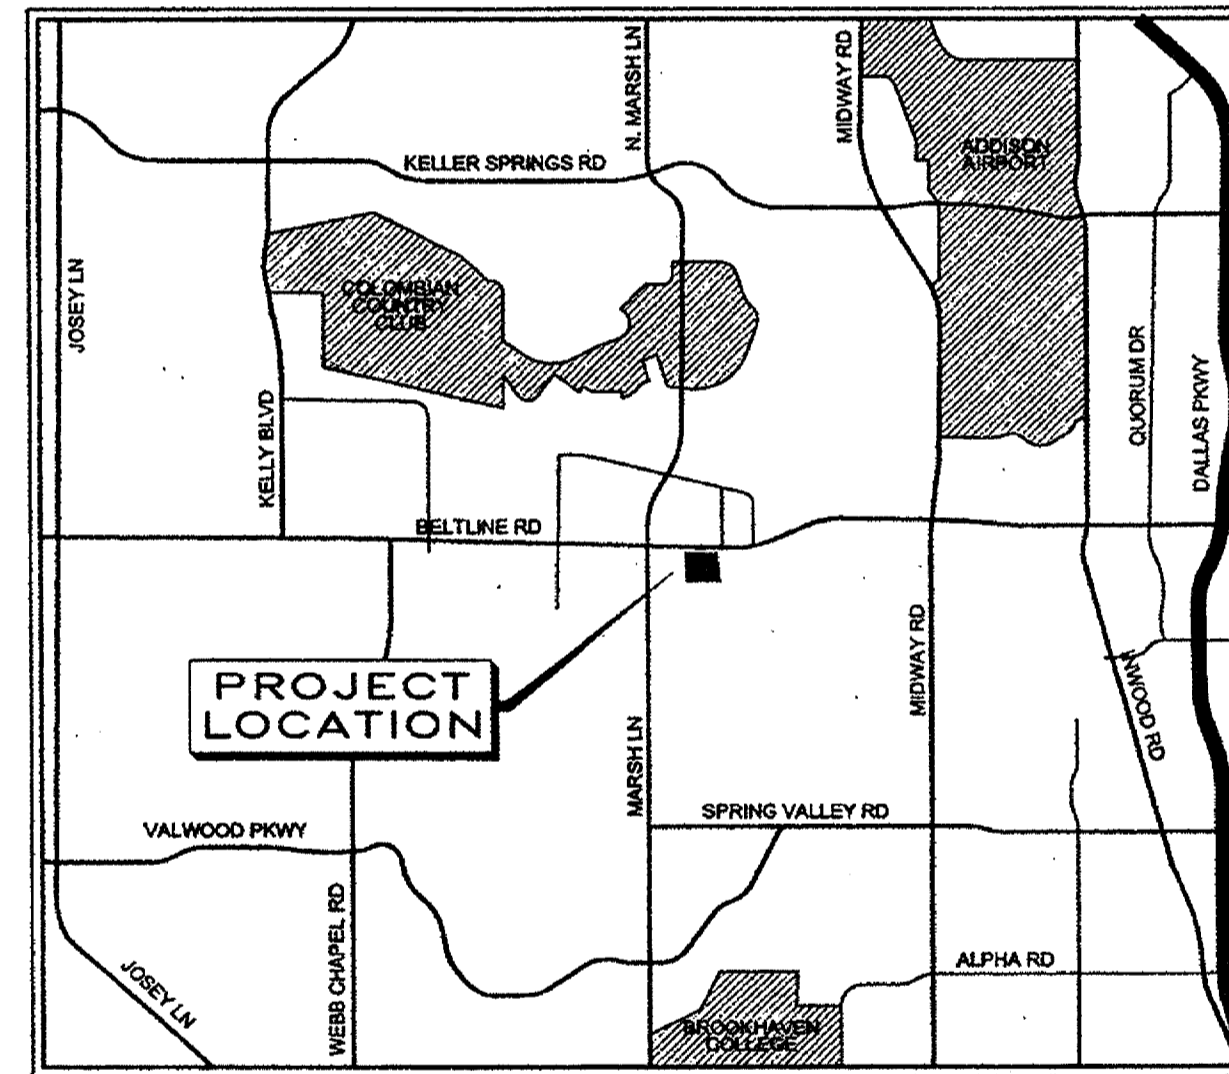


LEGAL DESCRIPTION

BEING all of Lot 2, Block D of Addison Town Center, an addition to the Town of Addison, Dallas County, Texas, according to the plat thereof recorded in Volume 93237, Page 3840, Deed Records, Dallas County, Texas.

SHEET INDEX


SHEET	SHEET DESCRIPTION
C-0	COVER SHEET
C-1	GENERAL NOTES
C-2	DEMOLITION PLAN
C-3	SITE PLAN
C-3.1	JOINT LAYOUT PLAN
C-4	STORM DRAIN PLAN
C-5	DRAINAGE MAP
C-6	EROSION CONTROL PLAN
C-7	SITE UTILITY PLAN
C-8	DETAILS
C-9	DETAILS

THE SEAL APPEARING IN THIS DOCUMENT WAS AUTHORIZED BY MATHEW THOMAS, P.E. 81576 ON 11/8/2006 FOR RECORD DRAWING PURPOSES ONLY.

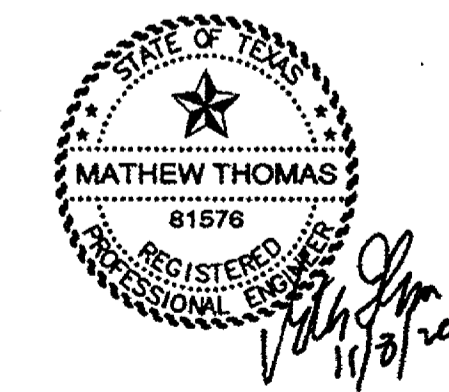

Capital One

Capital One
 Corp. Design & Construction
 201 St. Charles Ave., Suite 220
 New Orleans, LA 70170

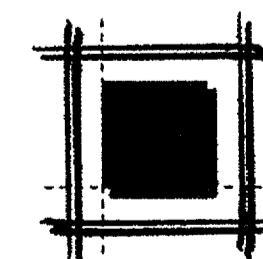

LEVINSON
 ASSOCIATES, L.P.
 6117 Richmond Ave., Suite 200 Houston, Texas 77057
 Tel 713.787.0000 fax 713.850.8250
 ARCHITECTURE PLANNING INTERIOR DESIGN

Carter & Burgess

Consultants In Planning, Engineering, Architecture,
 Construction Management, and Related Services
CARTER & BURGESS, INC.
 BUILDING PROGRAMS DIVISION
 777 MAIN STREET,
 FORT WORTH, TEXAS 76102
 TEL (817) 222-8500
 FAX (817) 222-8550

COPYRIGHT © 2006 CARTER AND BURGESS