

SITE VICINITY MAP

LEGEND CONSTRUCTION ENTRANCE **BLOCK & GRAVEL INLET PROTECTION** EXISTING OVER HEAD ELECTRIC EXISTING WATER LINE

GENERAL NOTES:


- 1. CONTRACTOR TO UTILIZE ONLY TOWN OF ADDISON APPROVED BMPS FOR STORM WATER POLLUTION AND PREVENTION MEASURES ONSITE.
- 2. RE-SEED ALL DISTURBED, NON-IMPERVIOUS AREAS UPON COMPLETION OF FINAL GRADING PER MANUFACTURER'S RECOMMENDATION.
- 3. CONTRACTOR TO MAINTAIN SILT FENCING AND INLET PROTECTION DURING CONSTRUCTION AND INSPECT AFTER EACH RAINSTORM.
- 4. CONTRACTOR TO MAINTAIN SILT FENCING ONSITE UNTIL DISTURBED AREAS HAVE STABILIZED FROM RE-VEGETATION, RE-SEEDING OR BY MEANS OF LANDSCAPING.
- 5. INSTALL ENVIRONMENTAL BLANKET WITH LANDSCAPE STAKES ON ALL 3:1 SLOPES FOR STABILIZATION PER MANUFACTURER'S RECOMMENDATION.
- 6. REFER TO SHEET C-1 GENERAL NOTES FOR ADDITIONAL EROSION CONTROL CONSTRUCTION NOTES NOT COVERED IN

SEQUENCE OF CONSTRUCTION

- INSTALL TEMPORARY CONSTRUCTION ENTRANCE IN THE LOCATION SHOWN. SEE SHEET C-8 FOR DETAIL.
- INSTALL INLET PROTECTION MEASURES AND SILT FENCE. SEE SHEET C-8 FOR
- 3. STRIP TOPSOIL AND OTHER ORGANIC MATERIALS. ALL SUCH TOPSOIL REMOVED SHALL BE STOCKPILED FOR LATER USE. ALL STOCKPILES SHALL BE SEEDED AND MULCHED TO PREVENT LOSS DUE TO EROSION, AND ENCIRCLED WITH
- 4. CONSTRUCT GRAVEL BASE FOR TRAILER PARKING, EMPLOYEE PARKING, AND CONSTRUCTION STAGING AREAS.
- 5. GRADE REMAINDER OF SITE TO BRING BUILDING PAD AND PARKING AREAS TO FINISHED GRADE.
- 6. CONSTRUCT UNDERGROUND UTILITIES.
- 7. CONSTRUCT FOUNDATION AND BUILDING.
- 8. CONSTRUCT PAVED AREAS.
- 9. FINISH GRADING OF ALL AREAS.
- 10. COMPLETE PERMANENT SEEDING AND MULCHING OF ALL DISTURBED AREAS. EROSION CONTROL MEASURES ARE TO REMAIN IN PLACE UNTIL A FULL VEGETATIVE COVER HAS BEEN ESTABLISHED.

NOTES BY SYMBOL


- STABILIZED CONSTRUCTION ENTRANCE, SEE DETAIL,
- 2) SILT FENCE, SEE DETAIL, SHEET C-8.
- (3) FILTER FABRIC INLET PROTECTION, SEE DETAIL, SHEET C-8.
- PROTECT EXISTING TREES PER LANDSCAPE PLAN. REFER TO LANDSCAPE PLAN.

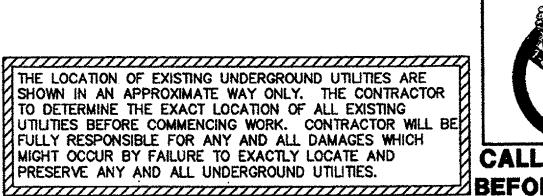



THE SEAL APPEARING IN THIS DOCUMENT WAS AUTHORIZED BY MATHEW THOMAS, P.E. 81576 ON 11/8/2006 FOR RECORD DRAWING PURPOSES ONLY.



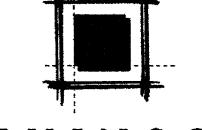

ASSOCIATES, L.P.

6117 Richmond Ave., Suite 200 Houston, Texas 77057 tel 713.787.0000 fax 713.850.8250 ARCHITECTURE PLANNING INTERIOR DESIGN DRAWN BY: RAL CHECKED BY: MT REVISED BY: 1 CITY REVIEW COMMENTS 4/7/06 RAL CITY SUBMITTAL 4/28/06 RAL 2) CITY REVIEW COMMENTS 5/19/06 GRM

Carter :: Burgess

Consultants in Planning, Engineering, Architecture, Construction Management, and Related Services CARTER & BURGESS, INC. BUILDING PROGRAMS DIVISION 777 MAIN STREET, FORT WORTH, TEXAS 76102 TEL (817) 222-8500 FAX (817) 222-8550

COPYRIGHT © 2006 CARTER AND BURGESS

Issued For:

25271.000 LALP Project Number: AS-BUILT

EROSION CONTROL PLAN

NOVEMBER 8, 2006 Issue Date:

C&B Project Number: 293070.020