


REV 5/12/94 ADD BABY STONE CHANGE INLET FROM 8" TO 10" ON LN 5.1

BENCHMARK:
 □ CUT ON STORM SEWER INLET ON SOUTH SIDE OF BELTLINE ROAD 70± WEST OF COMMERCIAL DRIVE.
 ELEV. = 580.56

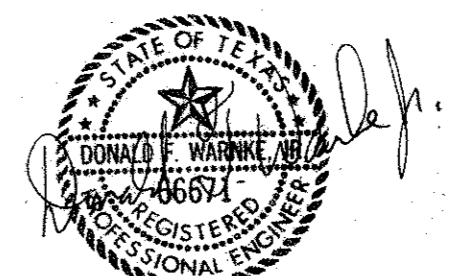

01-26-94

STORM SEWER PROFILES						
COMP U.S.A.						
ADDISON TOWN CENTER						
CITY OF ADDISON, TEXAS						
LAWRENCE A. CATES & ASSOC.						CONSULTING ENGINEERS DALLAS, TEXAS
DESIGN	DRAWN	DATE	SCALE	NOTES	FILE	NO.
DFW	DFW	01/11/94	H:1"=40' V:1"=6'	D.P.	93059	C-II

DRAWN BY: L.A.C. CHECKED BY: L.A.C. DATE: 01/11/94