


REV 5/12/94 ADD BARY STORE CHANGE INLET FROM 8" TO 12" ON LN 5.1

BENCHMARK:  
 "T" CUT ON STORM SEWER  
 INLET ON SOUTH SIDE OF  
 BELTLINE ROAD 70'± WEST  
 OF COMMERCIAL DRIVE.  
 ELEV. = 580.56

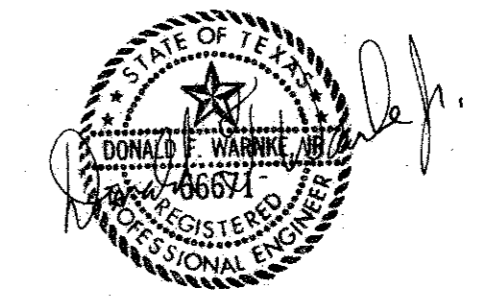

01-26-94

STORM SEWER PROFILES						
COMP U.S.A.						
ADDISON TOWN CENTER						
CITY OF ADDISON, TEXAS						
LAWRENCE A. CATES & ASSOC.						CONSULTING ENGINEERS DALLAS, TEXAS
DESIGN	DRAWN	DATE	SCALE	NOTES	FILE	NO.
DFW	DFW	01/11/94	H:1"=40' V:1"=6'	D.P.	93059	C-11