



AS-BUILTS
 I CERTIFY THIS PROJECT WAS CONSTRUCTED IN GENERAL CONFORMANCE WITH THESE CONSTRUCTION PLANS AND WILL FUNCTION AS DESIGNED.

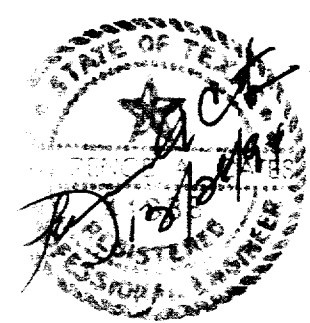

BENCHMARK:
 □ CUT ON STORM SEWER INLET ON SOUTH SIDE OF BELTLINE ROAD 70± WEST OF COMMERCIAL DRIVE.
 ELEV. = 550.56

REV. 5/12/94 VOID LN 5.0
 REV. 02/07/94 ADDED TYPE A.M.H. LN. SD 1.0

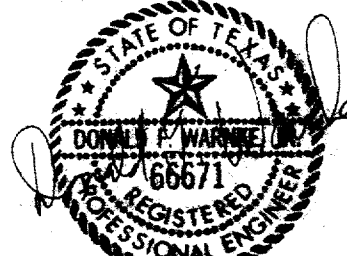

01-26-94

STORM SEWER PROFILES						
COMP U.S.A.						
ADDISON TOWN CENTER						
CITY OF ADDISON, TEXAS						
LAWRENCE A. CATES & ASSOC. CONSULTING ENGINEERS DALLAS, TEXAS						
DESIGN	DRAWN	DATE	SCALE	NOTES	FILE	NO.
LAC	LAC	01/11/94	H: 1"=40' V: 1"=6'	D.P.	93059	C-10