


BENCH MARK:
 N.W. CORNER OF EXISTING CURB
 SOUTH SIDE OF BELT LINE ROAD
 575' WEST OF THE INTERSECT.
 ROAD AND BUSINESS AVENUE.
 ELEV. 573.06'


LET LOCATED ON
 SOUTH SIDE OF BELT LINE ROAD 70'±
 WEST OF THE INTERSECT.
 OF BELT LINE

BENCH MARK:
 " " CUT ON STORM SEWER INLET ON
 SOUTH SIDE OF BELT LINE ROAD 70'±
 WEST OF COMMERCIAL DRIVE.
 ELEV. 580.56'

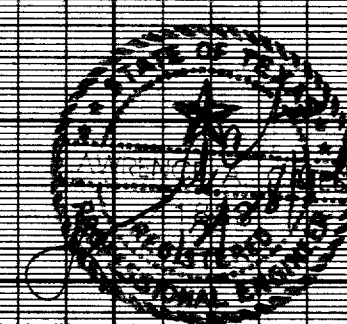

AS-BUILTS
 I CERTIFY THIS PROJECT WAS CONSTRUCTED IN GENERAL
 CONFORMANCE WITH THESE CONSTRUCTION PLANS AND WILL
 FUNCTION AS DESIGNED.

REV. 04-20-93 BY DELETED SAWN-DUR KING

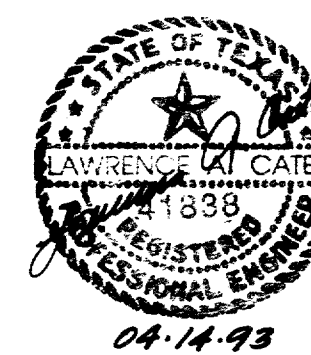

12" WATER LINE PROFILE						
K MART NO. 4885						
BELTLINE & MARSH						
ADDISON, TEXAS						
LAWRENCE A. CATES & ASSOC.						CONSULTING ENGINEERS DALLAS, TEXAS
DESIGN	DRAWN	DATE	SCALE	NOTES	FILE	NO.
LAC	LAC	4/12/93	H:1"=40' V:1"=6'	D.P.	91012	C-11

ARCHIVE SURPLUS 148855