


HUNTER SURVEY SERVICE, DALLAS FULL PROFILE SHEET

BENCHMARK:
 1" CUT ON STORM SEWER
 INLET ON SOUTH SIDE OF
 BELTLINE ROAD 70'± WEST
 OF COMMERCIAL DRIVE.
 ELEV. = 580.56

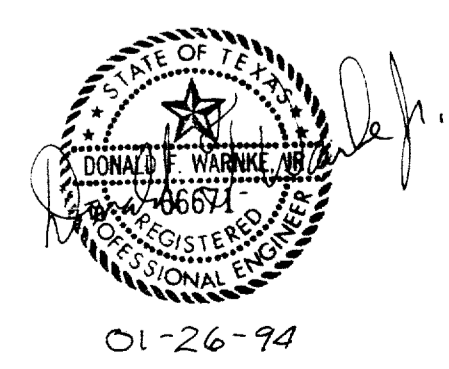

AS-BUILTS
 I CERTIFY THIS PROJECT WAS CONSTRUCTED IN GENERAL
 CONFORMANCE WITH THESE CONSTRUCTION PLANS AND WILL
 FUNCTION AS DESIGNED.

REV. 5/12/94 ADD BABY STORE CHANGE INLET
 FROM 8" TO 10" ON LN 5.1

STORM SEWER PROFILES					
COMP U.S.A.					
ADDISON TOWN CENTER					
CITY OF ADDISON, TEXAS					
LAWRENCE A. CATES & ASSOC.				CONSULTING ENGINEERS DALLAS, TEXAS	
DESIGN	DRAWN	DATE	SCALE	NOTES	FILE NO.
DFW	DFW	01/11/94	H:1"=40' V:1"=6'	D.P.	93059 C-11