

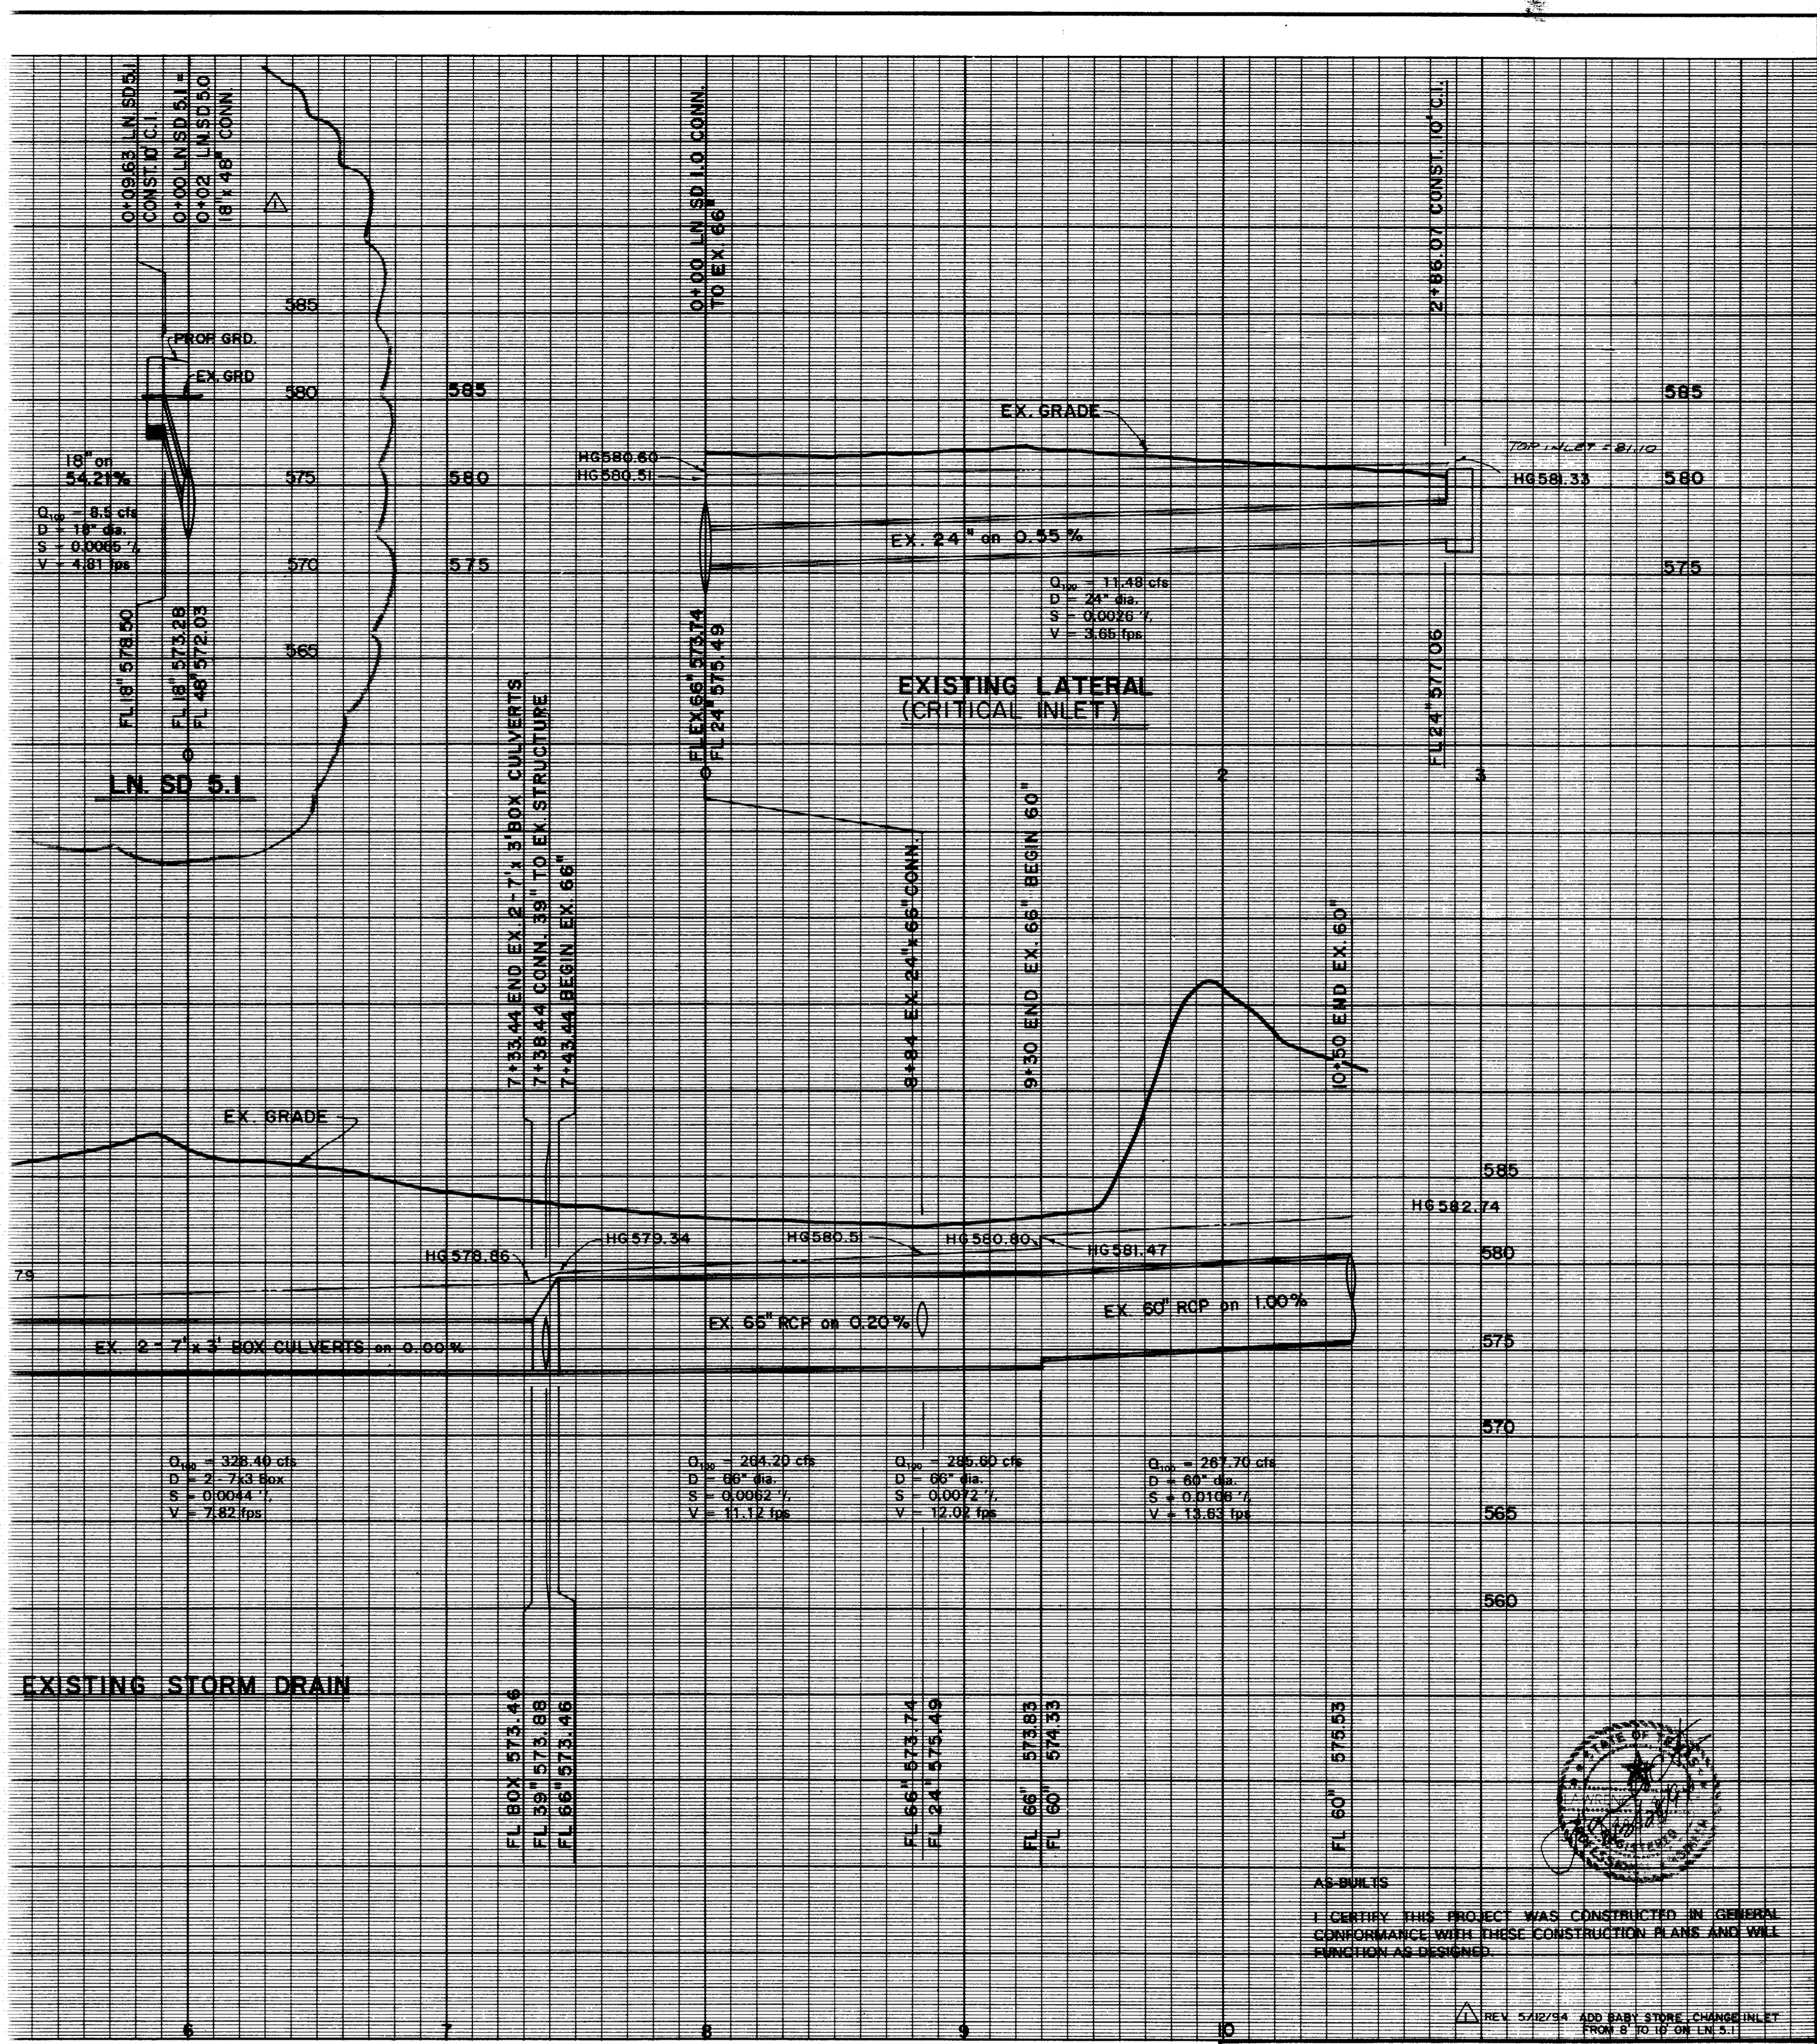


HUBBARD SURVEYING SERVICE - DALLAS FULL PROFILE SHEET

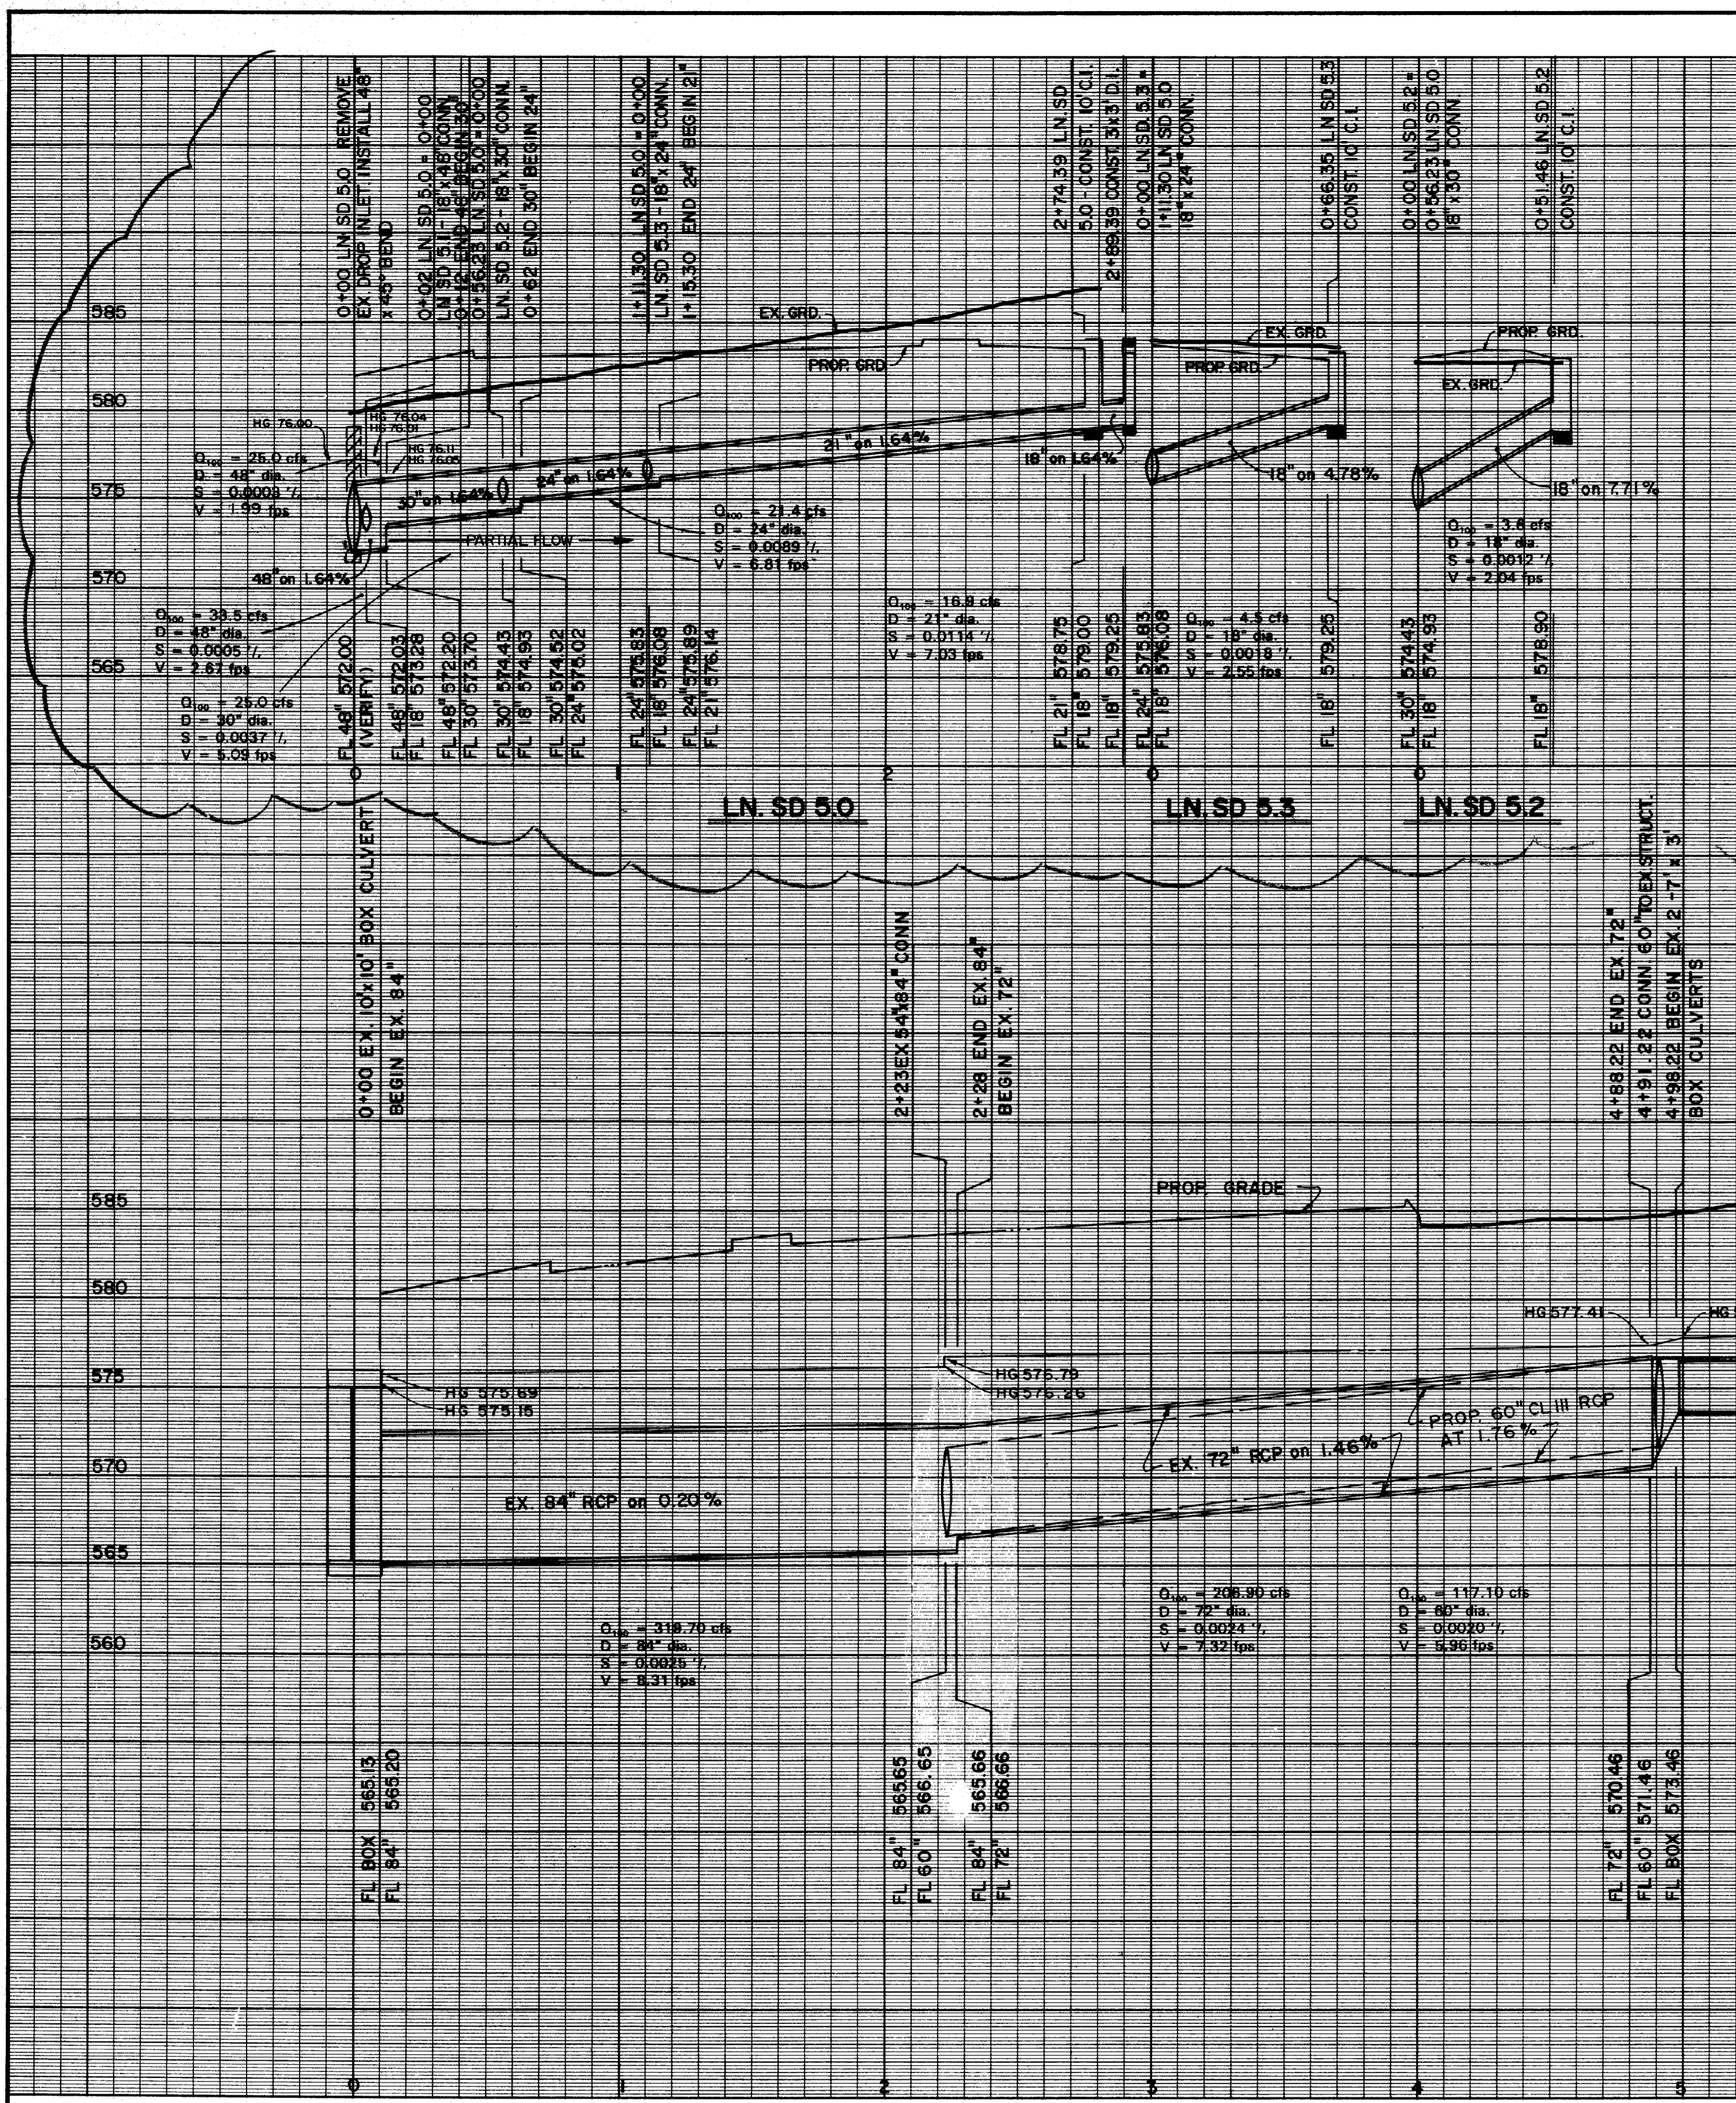

BENCHMARK:
 "C" CUT ON STORM SEWER
 INLET ON SOUTH SIDE OF
 BELTLINE ROAD 70'± WEST
 OF COMMERCIAL DRIVE.
 ELEV. = 580.56

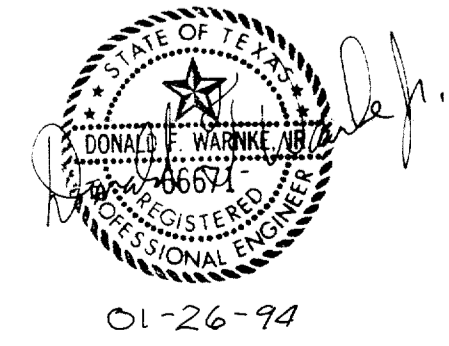

STORM SEWER PROFILES

COMP U.S.A.	
ADDISON TOWN CENTER	
CITY OF ADDISON, TEXAS	
LAWRENCE A. CATES & ASSOC. CONSULTING ENGINEERS DALLAS, TEXAS	
DESIGN	DFW
DRAWN	DFW
DATE	01/11/94
SCALE	H:1"=40' V:1"=6'
NOTES	D.P.
FILE	93059
NO.	C-11

AS-BUILTS
 I CERTIFY THIS PROJECT WAS CONSTRUCTED IN GENERAL CONFORMANCE WITH THESE CONSTRUCTION PLANS AND WILL FUNCTION AS DESIGNED.

REV. 5/12/94 ADD BABY STORE CHANGE INLET FROM 8" TO 10" ON LN 5.1