


I CERTIFY THIS PROJECT WAS CONSTRUCTED IN GENERAL CONFORMANCE WITH THESE CONSTRUCTION PLANS AND WILL FUNCTION AS DESIGNED.

REV 01/11/94 LN B - ADD LINES  
 REV 02/07/94 M.H. 15 & 20A

BENCHMARK:  
 CUT ON STORM SEWER  
 INLET ON SOUTH SIDE OF  
 BELTLINE ROAD 70'± WEST  
 OF COMMERCIAL DRIVE.  
 ELEV. = 580.56

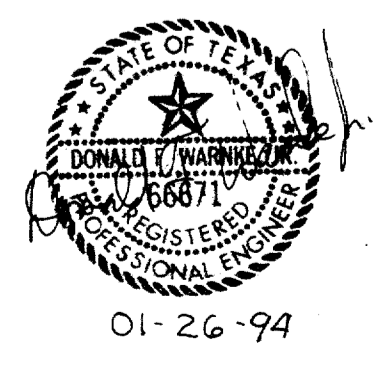

SANITARY SEWER PROFILES						
COMP. U.S.A.						
ADDISON TOWN CENTER						
CITY OF ADDISON, TEXAS						
LAWRENCE A. CATES & ASSOC. CONSULTING ENGINEERS DALLAS, TEXAS						
DESIGN	DRAWN	DATE	SCALE	NOTES	FILE	NO.
LAC	LAC	01/11/94	H: 1"=40' V: 1"=6'	D.P.	93059	C-12