



ABSTRACT

I CERTIFY THIS PROJECT WAS CONSTRUCTED TO GENERAL CONFORMANCE WITH THESE SPECIFICATIONS PLANS AND ALL PUNCTURE AS INDICATED.

REV. 07/27/94 LN. B - 300 LN. A  
REV. 02/07/94 M.H. TO 6" DIA.

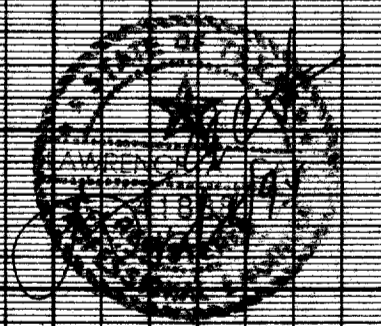

BENCHMARK:  
 1" CUT ON STORM SEWER INLET ON SOUTH SIDE OF BELTLINE ROAD 70'± WEST OF COMMERCIAL DRIVE.  
 ELEV. = 580.56

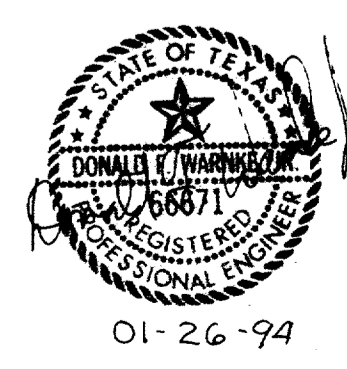

SANITARY SEWER PROFILES							
COMP U.S.A.							
ADDISON TOWN CENTER							
CITY OF ADDISON, TEXAS							
LAWRENCE A. CATES & ASSOC. CONSULTING ENGINEERS DALLAS, TEXAS							
DESIGN	DRAWN	DATE	SCALE	NOTES	FILE	NO.	
LAC	LAC	01/11/94	H: 1"=40' V: 1"=6'	D.P.	93059	C-12	