

HYDRAULIC CALCULATIONS FOR STORM SEWER AND LATERALS

STORM DRAIN CALCULATIONS

| RUNOFF COLLECTION POINT | | DISTANCE BETWEEN | INCREMENTAL DRAINAGE AREA | | | | TIME AT UPSTREAM | DESIGN STORM FREQUENCY | TIME OF CONCENTRATION | INTENSITY | ACCUMULATED STORM WATER RUNOFF | SLOPE OF HYDRAULIC GRADIENT | SELECTED STORM DRAIN SIZE | VELOCITY IN DRAIN | FLOW IN DRAIN | TIME AT DOWNSTREAM | REMARKS |
|-----------------------------|--------------------|-------------------|---------------------------|-----------------------|-------------------|-------------------|-------------------------|------------------------|-----------------------|-----------|--------------------------------|-----------------------------|---------------------------|-------------------|---------------|--------------------|-----------------------------|
| UPSTREAM STATION | DOWNSTREAM STATION | COLLECTION POINTS | AREA No. | DRAINAGE AREA *ACRES* | RUNOFF COEFF. *C* | INCRE-MENTAL *CA* | TIME AT UPSTREAM (MIN.) | (YEARS) | (MIN) | (IN/HR) | (CFS) | (FT/FT) | (IN) | (FPS) | (MIN) | (MIN) | |
| EXISTING STORM DRAIN SYSTEM | | | | | | | | | | | | | | | | | |
| 10+50 | 9+30 | 120 | | 68.41 | 0.51 | 35.22 | 35.22 | 15.50 | 100 | 15 | 7.60 | 267.65 | 0.0106 | 13.63 | 0.15 | 15.65 | |
| 9+30 | 8+84 | 46 | | 0.00 | 0.51 | 0.00 | 35.22 | 15.65 | 100 | 15 | 7.50 | 264.13 | 0.0062 | 11.12 | 0.07 | 15.72 | |
| 8+84 | 8+53 | 31 | | 0.00 | 0.51 | 0.00 | 35.22 | 15.72 | 100 | 15 | 7.50 | 264.13 | 0.0062 | 11.12 | 0.05 | 15.76 | |
| 8+53 | 8+34 | 19 | | 0.00 | 0.51 | 0.00 | 35.22 | 15.76 | 100 | 15 | 7.50 | 264.13 | 0.0062 | 11.12 | 0.03 | 15.79 | |
| 8+34 | 7+33 | 101 | | 3.18 | 0.90 | 2.86 | 38.08 | 15.79 | 100 | 15 | 7.50 | 285.60 | 0.0072 | 12.02 | 0.14 | 15.93 | |
| 7+33 | 4+88 | 245 | | 6.34 | 0.90 | 5.71 | 43.79 | 15.93 | 100 | 10 | 7.50 | 328.39 | 0.0044 | 10.29 | 0.40 | 16.33 | EQUIVALENT CONDUIT DIAMETER |
| 4+88 | 2+28 | 260 | | 0.00 | 0.90 | 0.00 | 43.79 | 16.33 | 100 | 10 | 7.40 | 324.01 | 0.0024 | 8.22 | 0.52 | 16.85 | EQUIVALENT CONDUIT DIAMETER |
| 2+28 | 0+00 | 228 | | 0.00 | 0.90 | 0.00 | 43.79 | 16.85 | 100 | 10 | 7.30 | 319.63 | 0.0025 | 6.31 | 0.46 | 17.31 | |
| STORM DRAIN 1.0 | | | | | | | | | | | | | | | | | |
| 7+10 | 3+60 | 349.91 | | 1.51 | 0.90 | 1.36 | 1.36 | 10.00 | 100 | 10 | 8.74 | 11.88 | 0.0128 | 6.72 | 0.27 | 10.87 | |
| 3+60 | 1+61 | 199.15 | | 1.98 | 0.90 | 1.78 | 3.14 | 10.87 | 100 | 10 | 8.50 | 26.70 | 0.0074 | 6.71 | 0.49 | 11.36 | |
| 1+61 | 0+00 | 160.78 | | 2.81 | 0.90 | 2.53 | 5.67 | 11.36 | 100 | 10 | 8.35 | 47.34 | 0.0033 | 5.71 | 0.47 | 11.83 | |

HYDRAULIC ANALYSIS OF EXISTING STORM DRAIN SYSTEM

| STATION | SECTION | PIPE DIA. | AREA | R | R 2/3 | N | Q CFS | VEL FPS | V2/2g | Sf | PIPE LENGTH | PIPE FRICTION | Kj | PIPE BENDS | Kj | WYES | MANHOL | Kj | DIA CHANGE | TOTAL LOSSES | WATER SURFACE | ENERGY GRADIENT | COMMENTS | STATION | |
|---------|---------|-----------|-------|-------|-------|--------|-------|---------|--------|--------|-------------|---------------|------|------------|------|------|--------|------|------------|--------------|---------------|-----------------|------------|---------|--|
| 0+00 | 84 | 38.485 | 1.750 | 1.452 | 0.013 | 319.70 | 8.31 | 1.07 | 0.0025 | 0.00 | 0.00 | 0.00 | 0.00 | 0.00 | 0.00 | 0 | 0 | 0.50 | 0.54 | 0.54 | 575.15 | 576.75 | BOX TO 84' | 0+00 | |
| 2+28 | 84 | 38.485 | 1.750 | 1.452 | 0.013 | 319.70 | 8.31 | 1.07 | 0.0025 | 228.00 | 0.57 | 0.00 | 0.00 | 0.00 | 0.00 | 0 | 0 | 0.50 | 0.54 | 1.11 | 576.75 | 577.86 | 84' TO 72' | 2+28 | |
| 4+88 | 72 | 28.274 | 1.500 | 1.310 | 0.013 | 206.90 | 7.32 | 0.83 | 0.0024 | 260.00 | 0.62 | 0.00 | 0.00 | 0.00 | 0.00 | 0 | 0 | 0.45 | 0.37 | 0.96 | 577.79 | 578.62 | 72' TO BOX | 4+88 | |
| 4+88 | 60 | 19.635 | 1.250 | 1.160 | 0.013 | 117.10 | 5.96 | 0.55 | 0.0020 | 273.00 | 0.55 | 0.35 | 0.19 | 0.00 | 0.00 | 0 | 0 | 0.45 | 0.25 | 0.99 | 577.79 | 578.34 | 60' TO BOX | 4+88 | |
| 7+33 | 72/54 | 47.909 | | | | | | | | | | | | | | | | | | | | | | | |
| 7+33 | 2-7X3 | 42.000 | 1.050 | 1.033 | 0.013 | 328.40 | 7.82 | 0.95 | 0.0044 | 245.00 | 1.07 | 0.00 | 0.00 | 0.00 | 0.00 | 0 | 0 | 0.50 | 0.47 | 1.55 | 579.34 | 580.28 | BOX TO 66' | 7+33 | |
| 8+34 | 66 | 23.758 | 1.375 | 1.237 | 0.013 | 285.60 | 12.02 | 2.24 | 0.0072 | 101.00 | 0.73 | 0.00 | 0.00 | 0.00 | 0.00 | 0 | 0 | 0.00 | 0.00 | 0.73 | 580.07 | 582.31 | | 8+34 | |
| 8+53 | 66 | 23.758 | 1.375 | 1.237 | 0.013 | 285.60 | 12.02 | 2.24 | 0.0072 | 19.00 | 0.14 | 0.00 | 0.00 | 0.00 | 0.00 | 0 | 0 | 0.00 | 0.00 | 0.14 | 580.20 | 582.45 | | 8+53 | |
| 8+84 | 66 | 23.758 | 1.375 | 1.237 | 0.013 | 264.20 | 11.12 | 1.92 | 0.0062 | 50.00 | 0.31 | 0.00 | 0.00 | 0.00 | 0.00 | 0 | 0 | 0.00 | 0.00 | 0.31 | 580.51 | 582.43 | 24x66 CONN | 8+84 | |
| 9+30 | 66 | 23.758 | 1.375 | 1.237 | 0.013 | 264.20 | 11.12 | 1.92 | 0.0062 | 46.00 | 0.28 | 0.00 | 0.00 | 0.00 | 0.00 | 0 | 0 | 0.35 | 0.67 | 0.96 | 581.47 | 583.35 | 66' TO 60' | 9+30 | |
| 10+50 | 60 | 19.635 | 1.250 | 1.160 | 0.013 | 267.70 | 13.63 | 2.89 | 0.0106 | 120.00 | 1.27 | 0.00 | 0.00 | 0.00 | 0.00 | 0 | 0 | 0.00 | 0.00 | 1.27 | 582.74 | 585.62 | | 10+50 | |
| 0+00 | 24 | 3.142 | 0.500 | 0.630 | 0.013 | 11.48 | 3.65 | 0.21 | 0.0026 | 0.00 | 0.00 | 0.00 | 0.00 | 0.00 | 0.40 | 0 | 0 | 0.00 | 0.00 | 0.00 | 580.51 | 580.80 | 24x66 CONN | 0+00 | |
| 2+86 | 24 | 3.142 | 0.500 | 0.630 | 0.013 | 11.48 | 3.65 | 0.21 | 0.0026 | 286.07 | 0.74 | 0.00 | 0.00 | 0.00 | 0.00 | 0 | 0 | 0.00 | 0.00 | 0.74 | 581.33 | 581.54 | 10' INLET | 2+86 | |


07-Feb-94

COMP USA ADDISON / JOB NO. 93059 / FILE NAME STM1012B

HYDRAULIC CALCULATIONS FOR STORM SEWER AND LATERALS

| STATION | SECTION | PIPE DIA. | AREA | R | R 2/3 | N | Q CFS | VEL FPS | V2/2g | Sf | PIPE LENGTH | PIPE FRICTION | Kj | PIPE BENDS | Kj | WYES | MANHOL | Kj | DIA CHANGE | TOTAL LOSSES | WATER SURFACE | ENERGY GRADIENT | COMMENTS | STATION | |
|-----------------|---------|-----------|--------|-------|-------|-------|--------|---------|--------|--------|-------------|---------------|------|------------|------|------|--------|------|------------|--------------|---------------|-----------------|------------|------------|------|
| STORM DRAIN 1.0 | | | | | | | | | | | | | | | | | | | | | | | | | |
| 0+00 | 39 | 8.296 | 0.813 | 0.871 | 0.013 | 47.34 | 5.71 | 0.51 | 0.0033 | 0.00 | 0.00 | 0.35 | 0.18 | 0.00 | 0.00 | 0 | 0 | 1.00 | 0.51 | 0.68 | 579.34 | 580.02 | 39' CONN | 0+00 | |
| 1+61 | 39 | 8.296 | 0.813 | 0.871 | 0.013 | 47.34 | 5.71 | 0.51 | 0.0033 | 160.78 | 0.53 | 0.00 | 0.00 | 0.50 | 0.00 | 0 | 0 | 0.00 | 0.00 | 0.78 | 580.80 | 581.31 | 27x39 CONN | 1+61 | |
| 1+65 | 39 | 8.296 | 0.813 | 0.871 | 0.013 | 26.70 | 3.22 | 0.16 | 0.0010 | 4.00 | 0.00 | 0.00 | 0.00 | 0.00 | 0.00 | 0 | 0 | 1.00 | 0.16 | 0.17 | 580.97 | 581.13 | 39' TO 27' | 1+65 | |
| 3+60 | 27 | 3.976 | 0.563 | 0.681 | 0.013 | 26.70 | 6.72 | 0.70 | 0.0074 | 195.15 | 1.45 | 0.00 | 0.00 | 0.50 | 0.00 | 0 | 0 | 1.00 | 0.70 | 2.50 | 583.47 | 584.17 | TYPE A MH | 3+60 | |
| 7+10 | 18 | 1.767 | 0.375 | 0.520 | 0.013 | 11.88 | 6.72 | 0.70 | 0.0128 | 349.91 | 4.48 | 0.00 | 0.00 | 0.00 | 0.00 | 0 | 0 | 0.00 | 0.00 | 4.48 | 587.95 | 588.65 | 10' C I | 7+10 | |
| 0+00 | 1.1 | 27 | 3.976 | 0.563 | 0.681 | 0.013 | 22.12 | 5.56 | 0.48 | 0.0051 | 0.00 | 0.00 | 0.00 | 0.00 | 0.50 | 0 | 0 | 1.00 | 0.48 | 0.72 | 580.80 | 582.00 | 27x39 CONN | 0+00 | |
| 0+78 | 1.1 | 27 | 3.976 | 0.563 | 0.681 | 0.013 | 22.12 | 5.56 | 0.48 | 0.0051 | 78.00 | 0.40 | 0.00 | 0.00 | 0.00 | 0.00 | 0 | 0.00 | 0.00 | 0.40 | 581.92 | 582.40 | 2-10 C I | 0+78 | |
| 0+00 | 1.2 | 18 | 1.767 | 0.375 | 0.520 | 0.013 | 15.55 | 8.80 | 1.20 | 0.0219 | 0.00 | 0.00 | 0.00 | 0.00 | 0.50 | 0 | 0 | 1.00 | 1.20 | 1.60 | 585.27 | 586.48 | 18x27 CONN | 0+00 | |
| 2+08 | 1.2 | 18 | 1.767 | 0.375 | 0.520 | 0.013 | 15.55 | 8.80 | 1.20 | 0.0219 | 208.00 | 4.56 | 0.00 | 0.00 | 0.00 | 0.00 | 0 | 0.00 | 0.00 | 4.61 | 589.88 | 591.08 | 3'x3' D I | 2+08 | |
| 3+24 | 1.2 | 18 | 1.767 | 0.375 | 0.520 | 0.013 | 6.29 | 3.56 | 0.20 | 0.0036 | 115.87 | 0.42 | 0.00 | 0.00 | 0.00 | 0.00 | 0 | 0.00 | 0.00 | 0.42 | 590.30 | 590.49 | 8' INLET | 3+24 | |
| 0+00 | 2.0 | 60 | 19.635 | 1.250 | 1.160 | 0.013 | 117.10 | 5.96 | 0.55 | 0.0020 | 0.00 | 0.00 | 0.00 | 0.00 | 0.00 | 0 | 0 | 0.00 | 0.00 | 0.00 | 576.79 | 577.34 | 60x84 CONN | 0+00 | |
| 2+73 | 2.0 | 60 | 19.635 | 1.250 | 1.160 | 0.013 | 117.10 | 5.96 | 0.55 | 0.0020 | 273.00 | 0.55 | 0.35 | 0.19 | 0.00 | 0.00 | 0 | 0 | 0.45 | 0.25 | 0.99 | 577.79 | 578.34 | 60' TO BOX | 2+73 |


THE SEAL APPEARING ON THIS DOCUMENT WAS AUTHORIZED BY DONALD F. WARNKE JR., P.E. 66671 ON 01/21/94

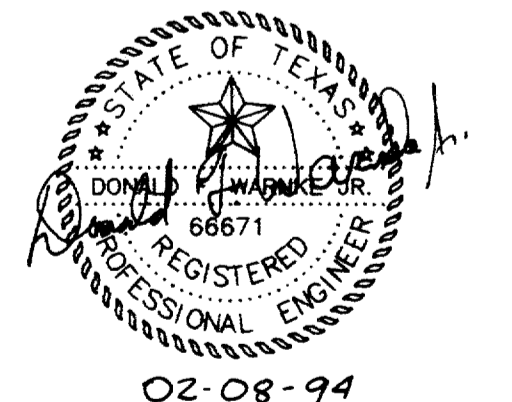

02-08-94

AS-BUILTS

I CERTIFY THIS PROJECT WAS CONSTRUCTED IN GENERAL CONFORMANCE WITH THESE CONSTRUCTION PLANS AND WILL FUNCTION AS DESIGNED.

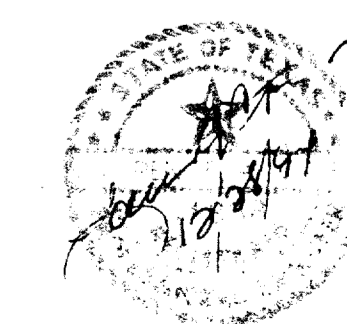

HYDRAULIC CALCULATIONS

COMP USA

ADDISON TOWN CENTER

TOWN OF ADDISON, TEXAS

LAWRENCE A. CATES & ASSOC.

CONSULTING ENGINEERS DALLAS, TEXAS

| DESIGN | DRAWN | DATE | SCALE | NOTES | FILE | NO. |
|--------|-------|----------|-------|-------|--------------------|------|
| LAC | LAC | 01/21/94 | N/A | D.P. | 93059 HYD-CALC.DWG | C-9A |