

C:\04812\0481260 Tue Nov 28 16:49:17 1995 PLOTTED BY MJT

DELTA = 102°07'23"
RADIUS = 50.08'
TANGENT = 61.98'
LENGTH = 89.27'
CHORD = 77.91'
CHD BRG = N 51°08'20" E

BELT LINE/MARSH BUSINESS PARK
BLOCK 2
VOL. 79252, PG. 0215

BUSINESS AVENUE
(60' ROW)


BLOCK 1

REALTY ROAD
(72' ROW)

TRIANGLE
48,967 SF.
(30 LANES)
FF=587.59

FF=589.00

LOCATION MAP
N.T.S.

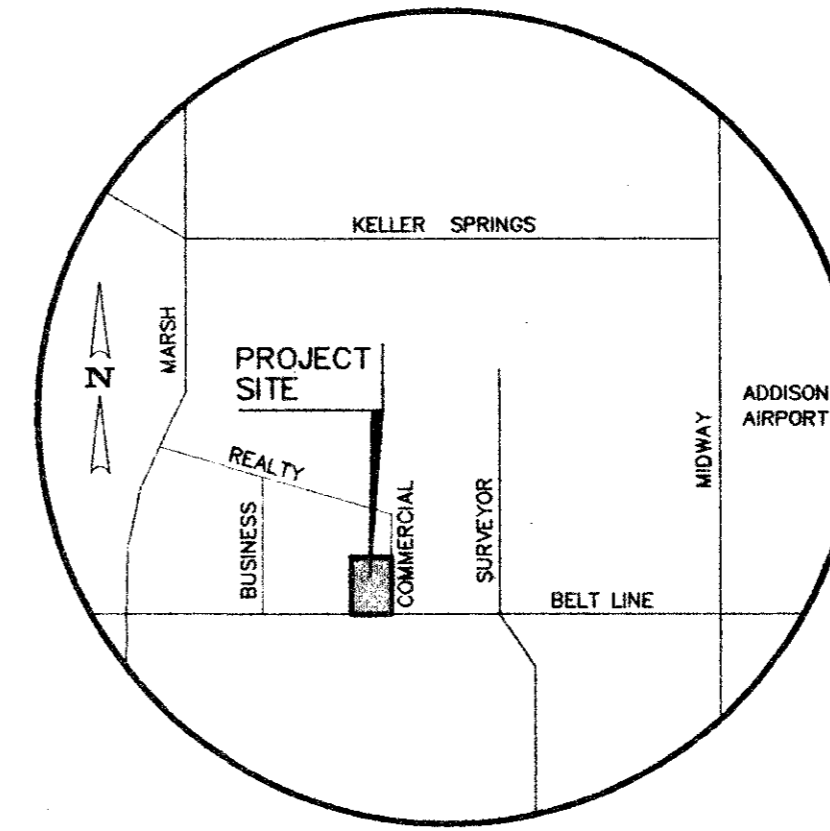

STORM DRAIN INLET PROTECTION CONSTRUCTION SPECIFICATIONS

- WOODEN FRAME IS TO BE CONSTRUCTED OF 2" X 4" CONSTRUCTION GRADE LUMBER.
- WIRE MESH MUST BE OF SUFFICIENT STRENGTH TO SUPPORT FILTER FABRIC AND STONE FOR CURB INLETS WITH WATER FULLY IMPROVED AGAINST IT.
- FILTER CLOTH MUST BE OF A TYPE APPROVED FOR THIS PURPOSE, RESISTANT TO SUBLIMATION WITH SEVERE SIZE EDS. 40-50 TO ALLOW SUFFICIENT PASSAGE OF WATER AND REMOVAL OF SEDIMENT.
- STONE IS TO BE 2" IN SIZE AND CLEAN SINCE FINES WOULD CLOG THE CLOTH.
- THE ASSEMBLY SHALL BE PLACED SO THAT THE END SPACERS ARE A MINIMUM 1" BEYOND BOTH ENDS OF THE THROAT OPENING.
- FROM THE WIRE MESH AND FILTER TO THE CONCRETE CURB AND AGAINST THE FACE OF CURB ON BOTH SIDES OF THE INLET. PLACE 1/2" OF STONE OVER THE WIRE MESH AND FILTER FABRIC IN SUCH A MANNER AS TO PREVENT WATER FROM ENTERING THE INLET UNDER OR THROUGH THE FILTER CLOTH.
- THIS TYPE OF PROTECTION MUST BE INSPECTED FREQUENTLY AND THE FILTER CLOTH AND STONE REPLACED WHEN CLOGGED WITH SEDIMENT.
- ASSURE THAT STORM FLOW DOES NOT BYPASS INLET BY OBTAINING TEMPORARY EARTH OR ASPHALT DICES DIRECTING FLOW INTO INLET.

A SWALE, DITCHLINE OR YARD INLET PROTECTION

- EXCAVATE COMPLETELY AROUND INLET TO A DEPTH OF 18" BELOW NOTCH ELEVATION.
- DRIVE 2" X 4" POST 1' INTO GROUND AT FOUR CORNERS OF INLET. PLACE NAIL STRIPS BETWEEN POSTS ON ENDS OF INLET. ASSEMBLE TOP PORTION OF 2" X 4" FRAME USING OVERLAP JOINT METHOD. TOP OF FRAME OVER INLET MUST BE 6" BELOW EDGE OF ROADWAY ADJACENT TO INLET.
- STRETCH WIRE MESH TIGHTLY AROUND FRAME AND FASTEN SECURELY. ENDS MUST MEET AT POST.
- STRETCH FILTER CLOTH TIGHTLY OVER WIRE MESH. THE CLOTH MUST EXTEND FROM TOP OF FRAME TO 18" BELOW INLET NOTCH ELEV. FASTEN SECURELY TO FRAME. ENDS MUST MEET AT POST. BE OVERLAPPED AND BUNDLED, THEN FASTENED DOWN.
- BACKFILL AROUND INLET IN COMPACTED 6" LAYERS UNTIL LAYER OF EARTH IS EVEN WITH NOTCH ELEVATION ON ENDS AND TOP ELEVATION ON SIDES.
- IF THE INLET IS NOT IN A LOW POINT CONSTRUCT A COMPACTED EARTH DIKE IN THE DITCHLINE BELOW IT. THE TOP OF THIS DIKE IS TO BE AT LEAST 6" HIGHER THAN THE TOP OF FRAME OVER INLET.
- THIS STRUCTURE MUST BE INSPECTED FREQUENTLY AND THE FILTER FABRIC REPLACED WHEN CLOGGED.

CURB INLET PROTECTION

- ATTACH A CONTINUOUS PIECE OF WIRE MESH 30" HIGH WIDTH BY THROAT LENGTH PLUS 4" TO THE 2" X 4" VEIL MEASURING THROAT LENGTH PLUS 2" AS SHOWN ON THE STANDARD DRAWING.
- PLACE A PIECE OF APPROVED FILTER CLOTH (40-50) SIEVED OF THE SAME DIMENSIONS AS THE WIRE MESH OVER THE WIRE MESH AND SECURELY ATTACH TO THE WIRE MESH.
- SECURELY NAIL THE 2" X 4" VEIL TO 3" LONG VERTICAL SPACERS TO BE LOCATED BETWEEN THE VEIL AND INLET FACE (MAX 4" APART).
- PLACE THE ASSEMBLY AGAINST THE INLET THROAT AND NAIL OVERHUNG 2" LENGTH OF 2" X 4" TO THE TOP OF THE VEIL AT SPACER LOCATIONS. THESE 2" X 4" ANCHORS SHALL EXTEND ACROSS THE INLET TOP AND BE HELD IN PLACE BY SANDBAGS OR ALTERNATE WEIGHT.

STRAW BALE DIKE CONSTRUCTION SPECIFICATIONS





- BALES SHALL BE PLACED AT THE TOE OF A SLOPE OR ON THE CONTOUR AND IN A ROW WITH ENDS TIGHTLY ADJUTING THE ADJACENT BALES.
- EACH BALE SHALL BE EMBEDDED IN THE SOIL A MINIMUM OF 40 INCHES AND PLACED SO THE JOINTS ARE HORIZONTAL.
- BALES SHALL BE SECURELY ANCHORED IN PLACE BY EITHER TWO STAKES OR RE-BARS DRIVEN THROUGH THE BALE. THE FIRST STAKE IN EACH BALE SHALL BE DRIVEN TOWARD THE PREVIOUSLY LAID BALE AT AN ANGLE TO FORCE THE BALES TOGETHER. STAKES SHALL BE DRIVEN FLUSH WITH THE BALE.
- INSPECTION SHALL BE FREQUENT AND REPAIR REPLACEMENT SHALL BE MADE PROMPTLY AS NEEDED.
- BALES SHALL BE REMOVED WHEN THEY HAVE SERVED THEIR USEFULNESS SO AS NOT TO BLOCK OR IMPERE STORM FLOW OR DRAINAGE.

STABILIZED CONSTRUCTION ENTRANCE CONSTRUCTION SPECIFICATIONS

- STONE SIZE - USE 2" STONE OR RECLAIMED OR RECYCLED CONCRETE EQUIVALENT.
- LENGTH - AS REQUIRED, BUT NOT LESS THAN 50 FEET EXCEPT ON A SINGLE RESIDENCE LOT WHERE A 30 FEET MINIMUM LENGTH WOULD APPLY.
- THICKNESS - NOT LESS THAN 24 INCHES.
- WIDTH - TEN (10) FEET MINIMUM BUT NOT LESS THAN THE FULL WIDTH AT POINTS WHERE INGRESS OR EGRESS OCCURS.
- FILTER CLOTH - WILL BE PLACED OVER THE ENTIRE AREA PRIOR TO PLACING OF STONE. FILTER WILL NOT BE REQUIRED ON A SINGLE FAMILY RESIDENCE LOT.
- ENTRANCES TO THE ENTRANCE SHALL BE MAINTAINED IN A CONDITION WHICH WILL PREVENT TRACKING OR FLOWING OF SEDIMENT ONTO RIGHTS-OF-WAY. THIS MAY REQUIRE PERIODIC TOP DRESSING WITH ADDITIONAL STONE AS CONDITIONS DEMAND REPAIR. ANCHOR CLEANOUT OF ANY MEASURES USED TO TRAP SEDIMENT. ALL SEDIMENT SPILLED, SPOILED, WASHED OR TRACKED ONTO PUBLIC RIGHTS-OF-WAY MUST BE REMOVED IMMEDIATELY.
- WASHING - WHEELS SHALL BE CLEANED TO REMOVE SEDIMENT PRIOR TO ENTRANCE ONTO PUBLIC RIGHTS-OF-WAY. WHEN WASHING IS REQUIRED, IT SHALL BE DONE ON AN AREA STABILIZED WITH STONE AND WHICH DRAINS INTO AN APPROVED SEDIMENT TRAPPING.
- PERIODIC INSPECTION AND NEEDED MAINTENANCE SHALL BE PROVIDED AFTER EACH

AS-BUILT DRAWINGS
TO THE BEST OF MY KNOWLEDGE THIS PROJECT WAS CONSTRUCTED IN SUBSTANTIAL ACCORDANCE WITH THE TOWN OF ADDISON STANDARDS AND SPECIFICATIONS, AND FUNCTIONS AS DESIGNED. WINKELMANN & ASSOCIATES, INC. DOES NOT CERTIFY AS TO THE QUALITY OR CORRECTNESS OF CONSTRUCTION, AS NO FIELD INSPECTION WAS PERFORMED.

Winkelmann 11-29-94
WINKELMANN & ASSOCIATES, INC.

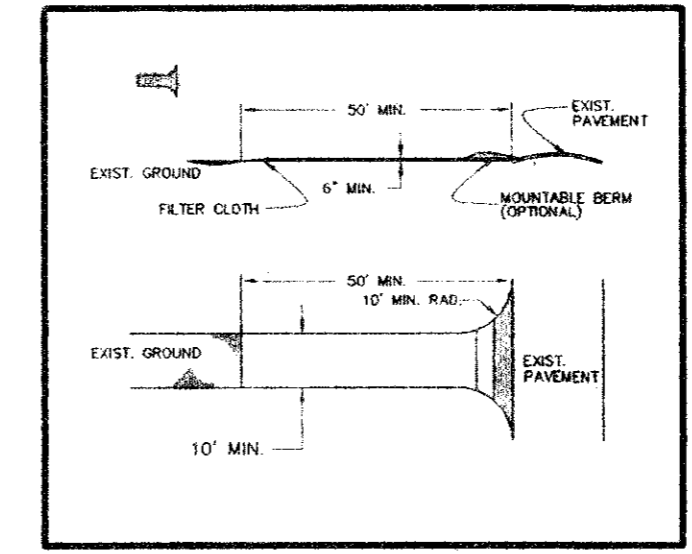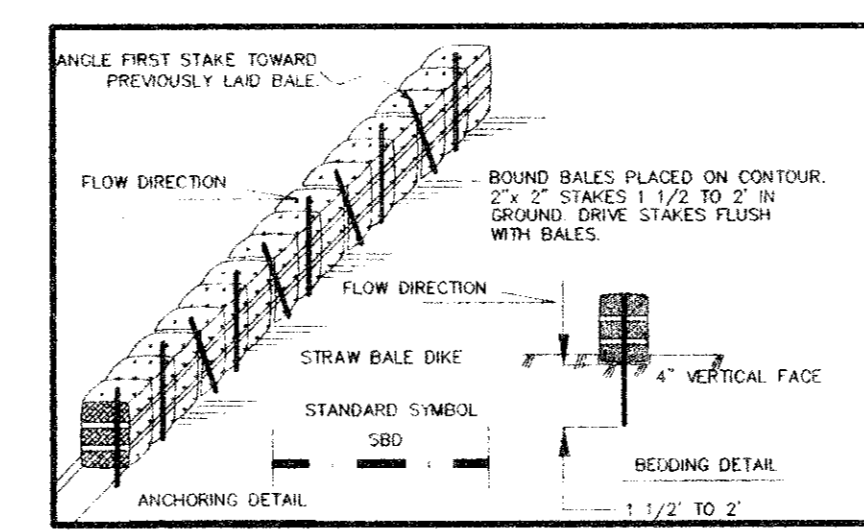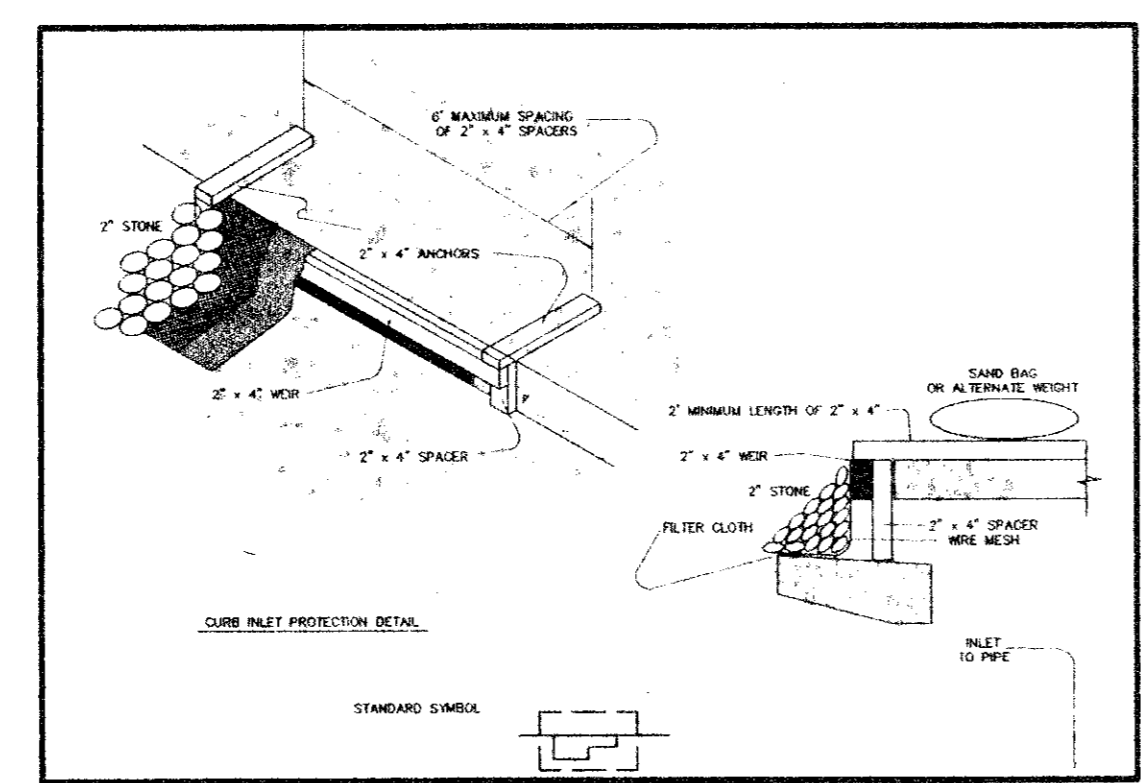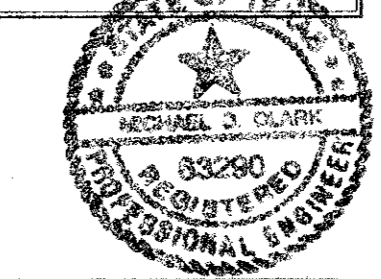

LEGEND

- EX. CONTOURS
- PROP. CONTOURS
- LOT LINE
- RIPRAP
- STRIPING
- STRAW BALE DIKE OR SILT FENCE
- STABILIZED CONSTRUCTION ENTRANCE
- STONE OUTLET SEDIMENT TRAP
- INLET PROTECTION
- TEMPORARY SEEDING
- PERMANENT SEEDING

BENCH MARK:
"I" cut top of curb at the curb return east side of Commercial Drive and Beltline Road.
Elev = 582.16

* MIN. FINISH FLOOR ELEVATION ARE FROM REPORT PREPARED BY O'BRIEN ENGINEERS DATED: 7/7/94

NO.	DATE	REVISION	APPROVAL

Winkelmann & Associates, Inc.
CONSULTING CIVIL ENGINEERS & SURVEYORS
12800 HILLCREST ROAD, SUITE 200
DALLAS, TEXAS 75250
(214) 492-7999
(214) 492-7999 FAX

T.L. CHENOWETH SURVEY, ABSTRACT NO. 273
D. MEYERS SURVEY, ABSTRACT NO. 923
CITY OF ADDISON, DALLAS COUNTY, TEXAS

OWNER:
TRIANGLE BOWL
1717 N. BELTLINE ROAD
IRVING, TX 75051

EROSION PROTECTION PLAN
BLOCK 3, BELTLINE MARSH BUSINESS PARK
ADDISON, TEXAS

Scale: 1"=40'
Date: 12/23/94
Designed By: TL
Drawn By: TL
Checked By: MC
File: 04812GRD.DWG
Project No.: 0482.01

SHEET
C-5
OF
9