



C:\04812\048120ET.Tue Nov 28 09:12:22 1995 PLOTTED BY WJT

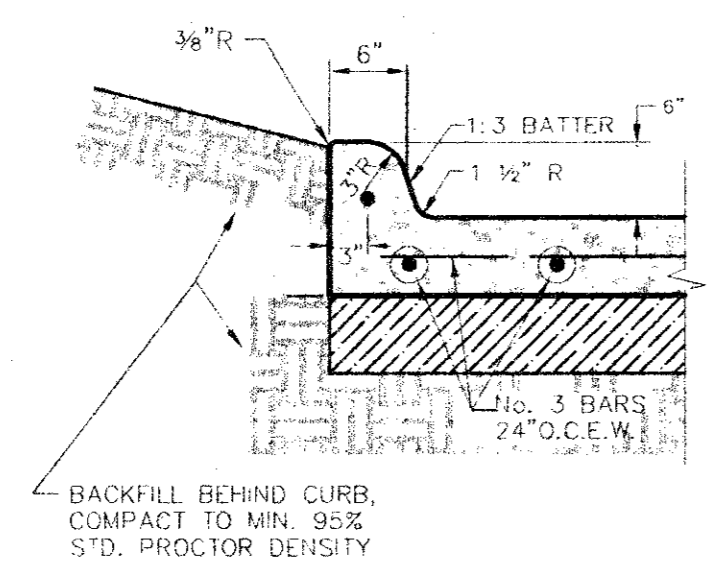

INTEGRAL CONCRETE CURB
N.T.S.

BARRIER FREE RAMP
N.T.S.

AS-BUILT DRAWINGS
 TO THE BEST OF MY KNOWLEDGE THIS PROJECT WAS CONSTRUCTED IN SUBSTANTIAL ACCORDANCE WITH THE TOWN OF ADDISON STANDARDS AND SPECIFICATIONS, AND FUNCTIONS AS DESIGNED. WINKELMANN & ASSOCIATES, INC. DOES NOT CERTIFY AS TO THE QUALITY OR CORRECTNESS OF CONSTRUCTION, AS NO FIELD INSPECTION WAS PERFORMED.
 Scale: 1"=40' Date: 12/05/94
 Designed By: TL
 Drawn By: TL
 Checked By: MC
 File: 048120ET.DWG
 Project No.: 04812.01
 WINKELMANN & ASSOCIATES, INC. DATE 11-29-95

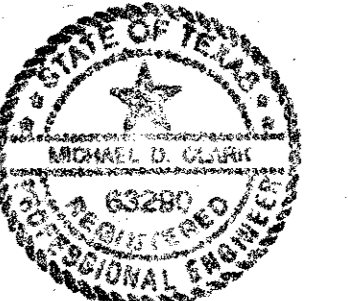

<p>Scale: 1"=40' Date: 12/05/94</p> <p>Designed By: TL</p> <p>Drawn By: TL</p> <p>Checked By: MC</p> <p>File: 048120ET.DWG</p> <p>Project No.: 04812.01</p>		<p>NO. DATE</p>	<p>REVISION</p>	<p>APPROVAL</p>
<p>OWNER: T.L. CHENOWETH SURVEY, ABSTRACT NO. 273 D. MEYERS SURVEY, ABSTRACT NO. 923 CITY OF ADDISON, DALLAS COUNTY, TEXAS</p> <p>RED ROBIN RESTAURANT INTERNATIONAL 28 EXECUTIVE PARK, SUITE 200 IRVINE, CA 92714</p>		<p>Winkelmann & Associates, Inc. CIVIL ENGINEERS & SURVEYORS 1200 WINKELMANN ROAD, SUITE 200 ADDISON, TEXAS 75102 (214) 981-2999 FAX</p>		

CIVIL DETAILS
BLOCK 3, BELTLINE MARSH BUSINESS PARK
ADDISON, TEXAS