



BUSINESS AVE.


BELT LINE ROAD

MEDIAN NOTES



1. CONCRETE PAVEMENT FOR MEDIAN CONSTRUCTION WILL BE 8" THICK, 3,000 PSI COMPRESSIVE STRENGTH @ 28 DAYS (MIN. 5 SACKS PER CUBIC YARD). REINFORCE WITH #3 BARS @ 18" O.C.E.W.
2. SUBGRADE TO BE 6" CTB
3. REFER TO GENERAL NOTES FOR ADDITIONAL REQUIREMENTS.
4. MEDIAN CONSTRUCTION NOT TO BEGIN UNTIL COMPLETION OF DECELERATION LANE.

GENERAL NOTES


1. ALL CURBS TO BE PLACED INTEGRAL WITH PAVEMENT AND SHALL MEET THE SAME COMPRESSIVE STRENGTH AS THE PROPOSED CONCRETE PAVEMENT.
2. ARRANGEMENT OF JOINTS SHALL MATCH JOINTS IN EXISTING PAVEMENT.
3. ALL BAR LAPS SHALL BE 30" DIAMETERS.
4. BAR CHAIRS SHALL BE FURNISHED.
5. CROSS SLOPE OF PROPOSED TURN LANE WILL BE 1/4" PER FOOT.
6. CONCRETE PAVEMENT FOR TURN LANE WILL BE 8" THICK, 3000 PSI COMPRESSIVE STRENGTH AT 28 DAYS WITH A MIXTURE THAT IS MINIMUM FIVE SACKS PER CUBIC YARD. REINFORCEMENT WILL BE #3 BARS @ 18" OCEW.
7. SUBGRADE WILL BE SCARIFIED TO A DEPTH OF 6" AND RECOMPACTED TO 95% STANDARD PROCTOR DENSITY. SUBGRADE TO BE STABILIZED WITH 6% BY WEIGHT OF HYDRATED LIME. SUBGRADE SHALL EXTEND 1' BACK OF PROPOSED CURB. 6" CTB MAY BE ALLOWED AS ALTERNATE TO LIME STABILIZATION.
8. ALL JOINTS IN CONCRETE PAVEMENT TO BE SEALED WITH 0A55 ASPHALT OR RUBBER BASED COMPOUND.
9. INSTALLATION OF DRIVE APPROACHES, SIDEWALKS, RIGHT-TURN LANE AND MEDIAN IMPROVEMENTS SHALL MEET TOWN OF ADDISON STANDARDS.

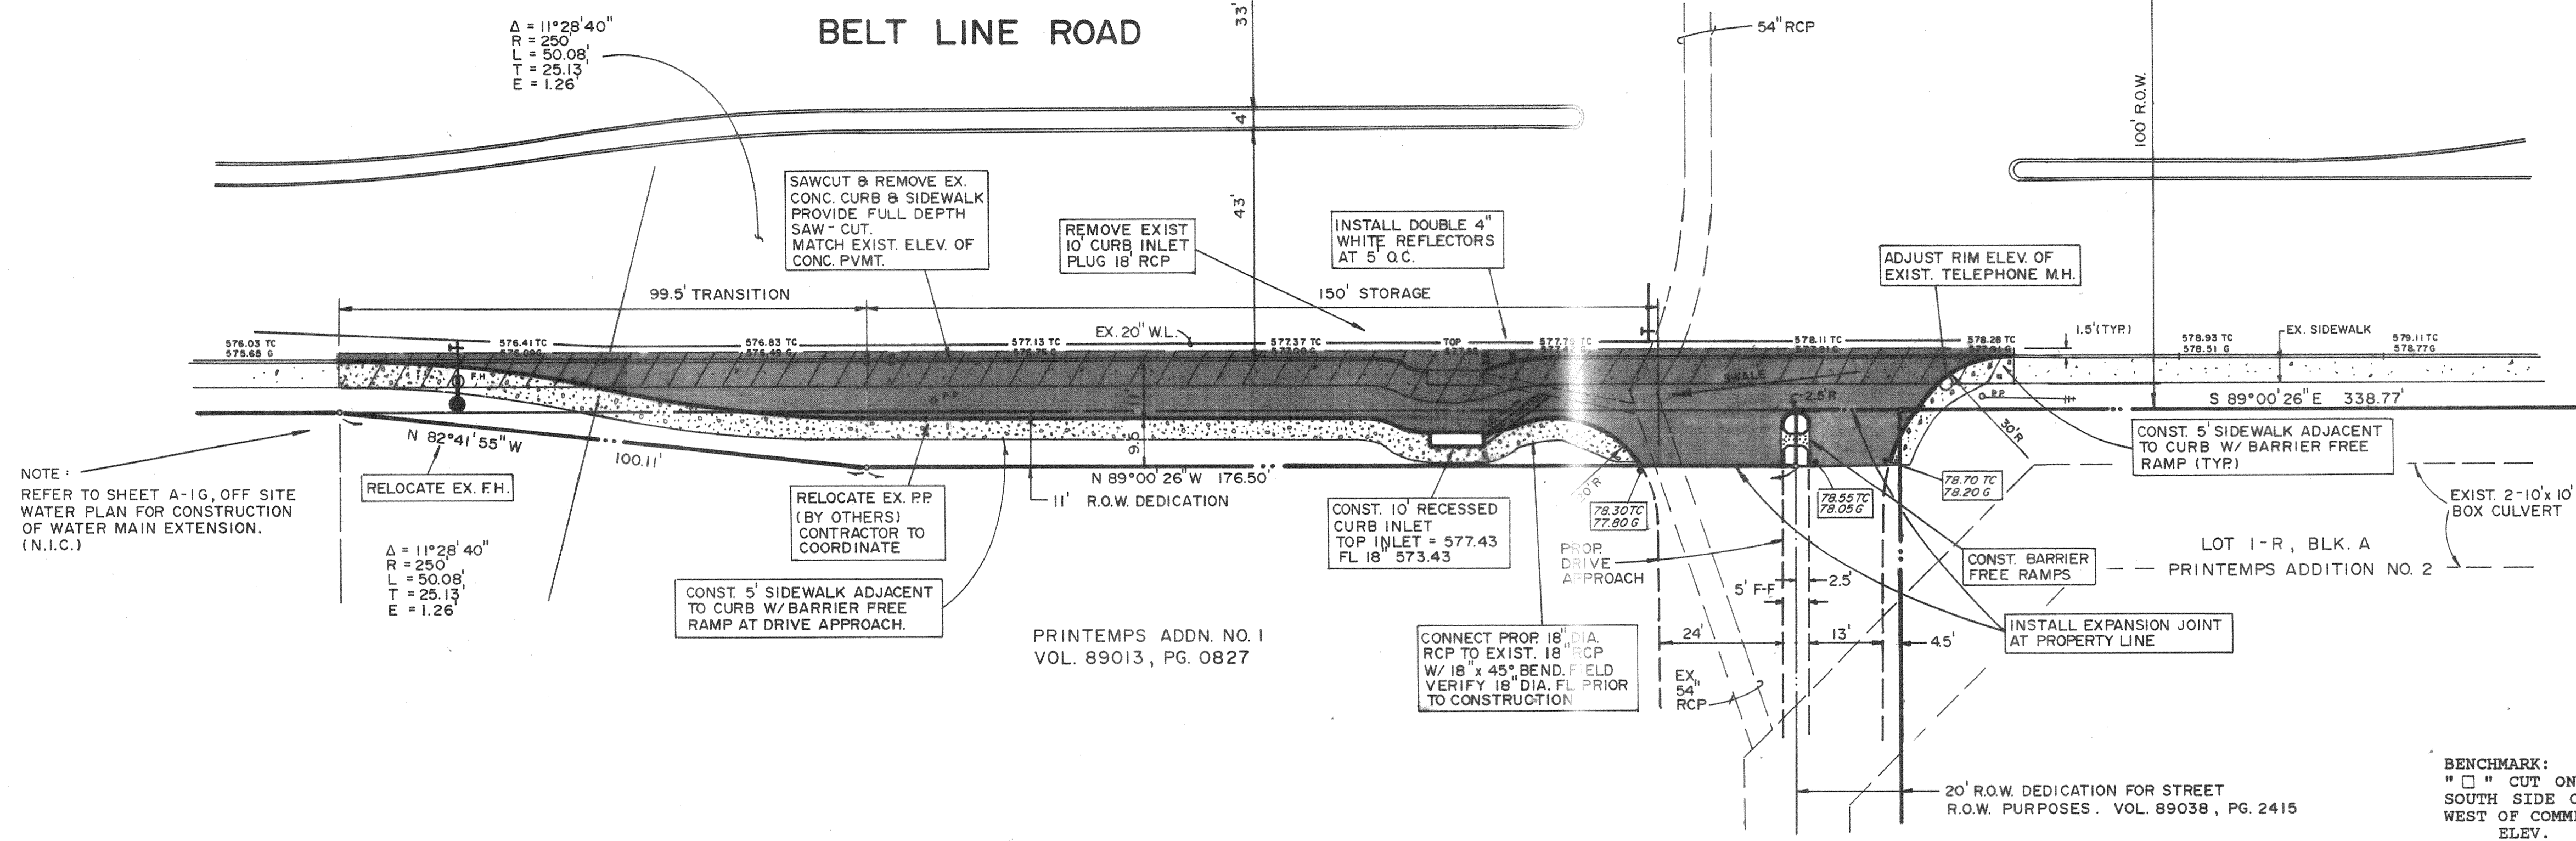

NOTE:
REFER TO SHEET A-16, OFF SITE
WATER PLAN FOR CONSTRUCTION
OF WATER MAIN EXTENSION.
(N.I.C.)

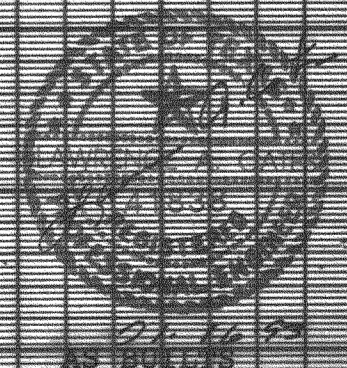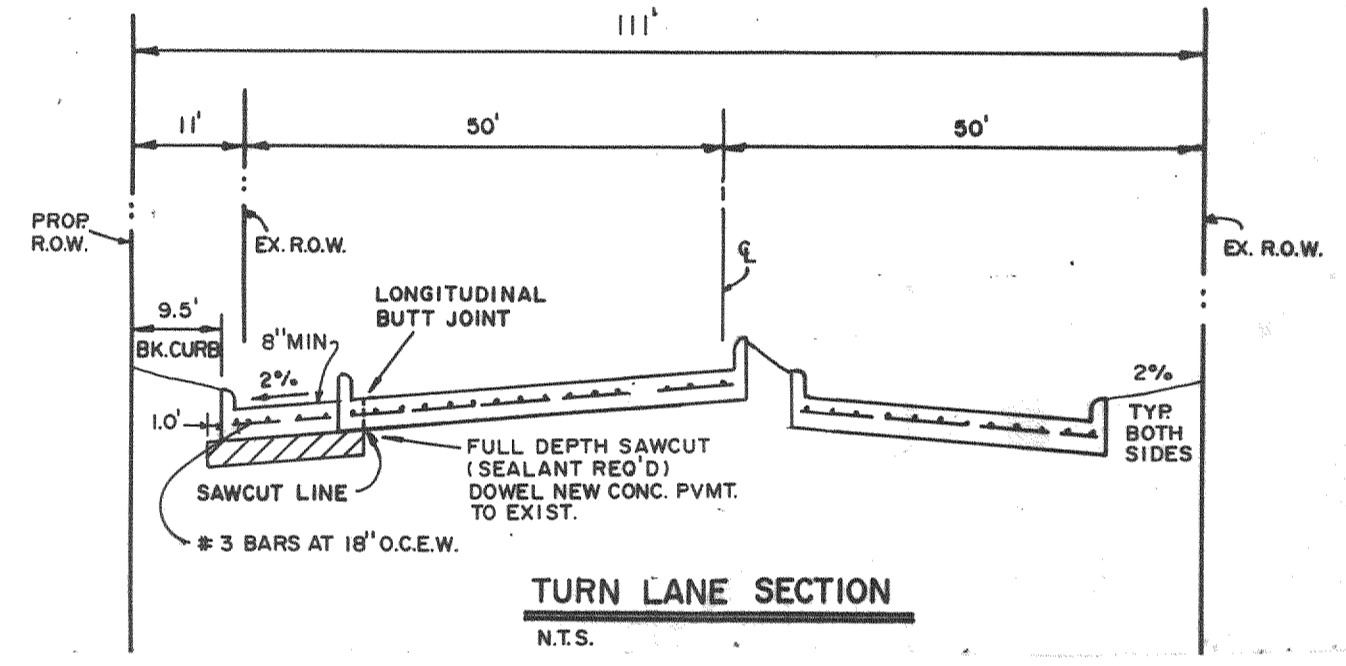


I CERTIFY THIS PROJECT WAS CONSTRUCTED IN GENERAL CONFORMANCE WITH THESE CONSTRUCTION PLANS AND WILL FUNCTION AS DESIGNED.

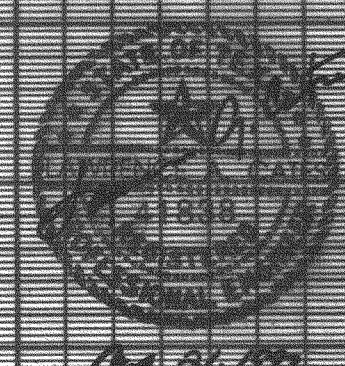

12/27/04 NO. MEDIAN WORK
07/07/06 REV. MEDIAN FOR CITY COMMENTS
02/02/08 REV. PROP. DRIVE, MEDIAN NOTES & ADDED PAVEMENT

DECELERATION LANE & MEDIAN CONSTRUCTION						
BELT LINE RD. & BUSINESS AVE.						
TOWN OF ADDISON						
CONSULTING ENGINEERS LAWRENCE A. CATES & ASSOC. DALLAS, TEXAS						
DESIGN	DRAWN	DATE	SCALE	NOTES	FILE	NO.
LAC	LAC	6/19/02	1" = 20'		92023	C-1

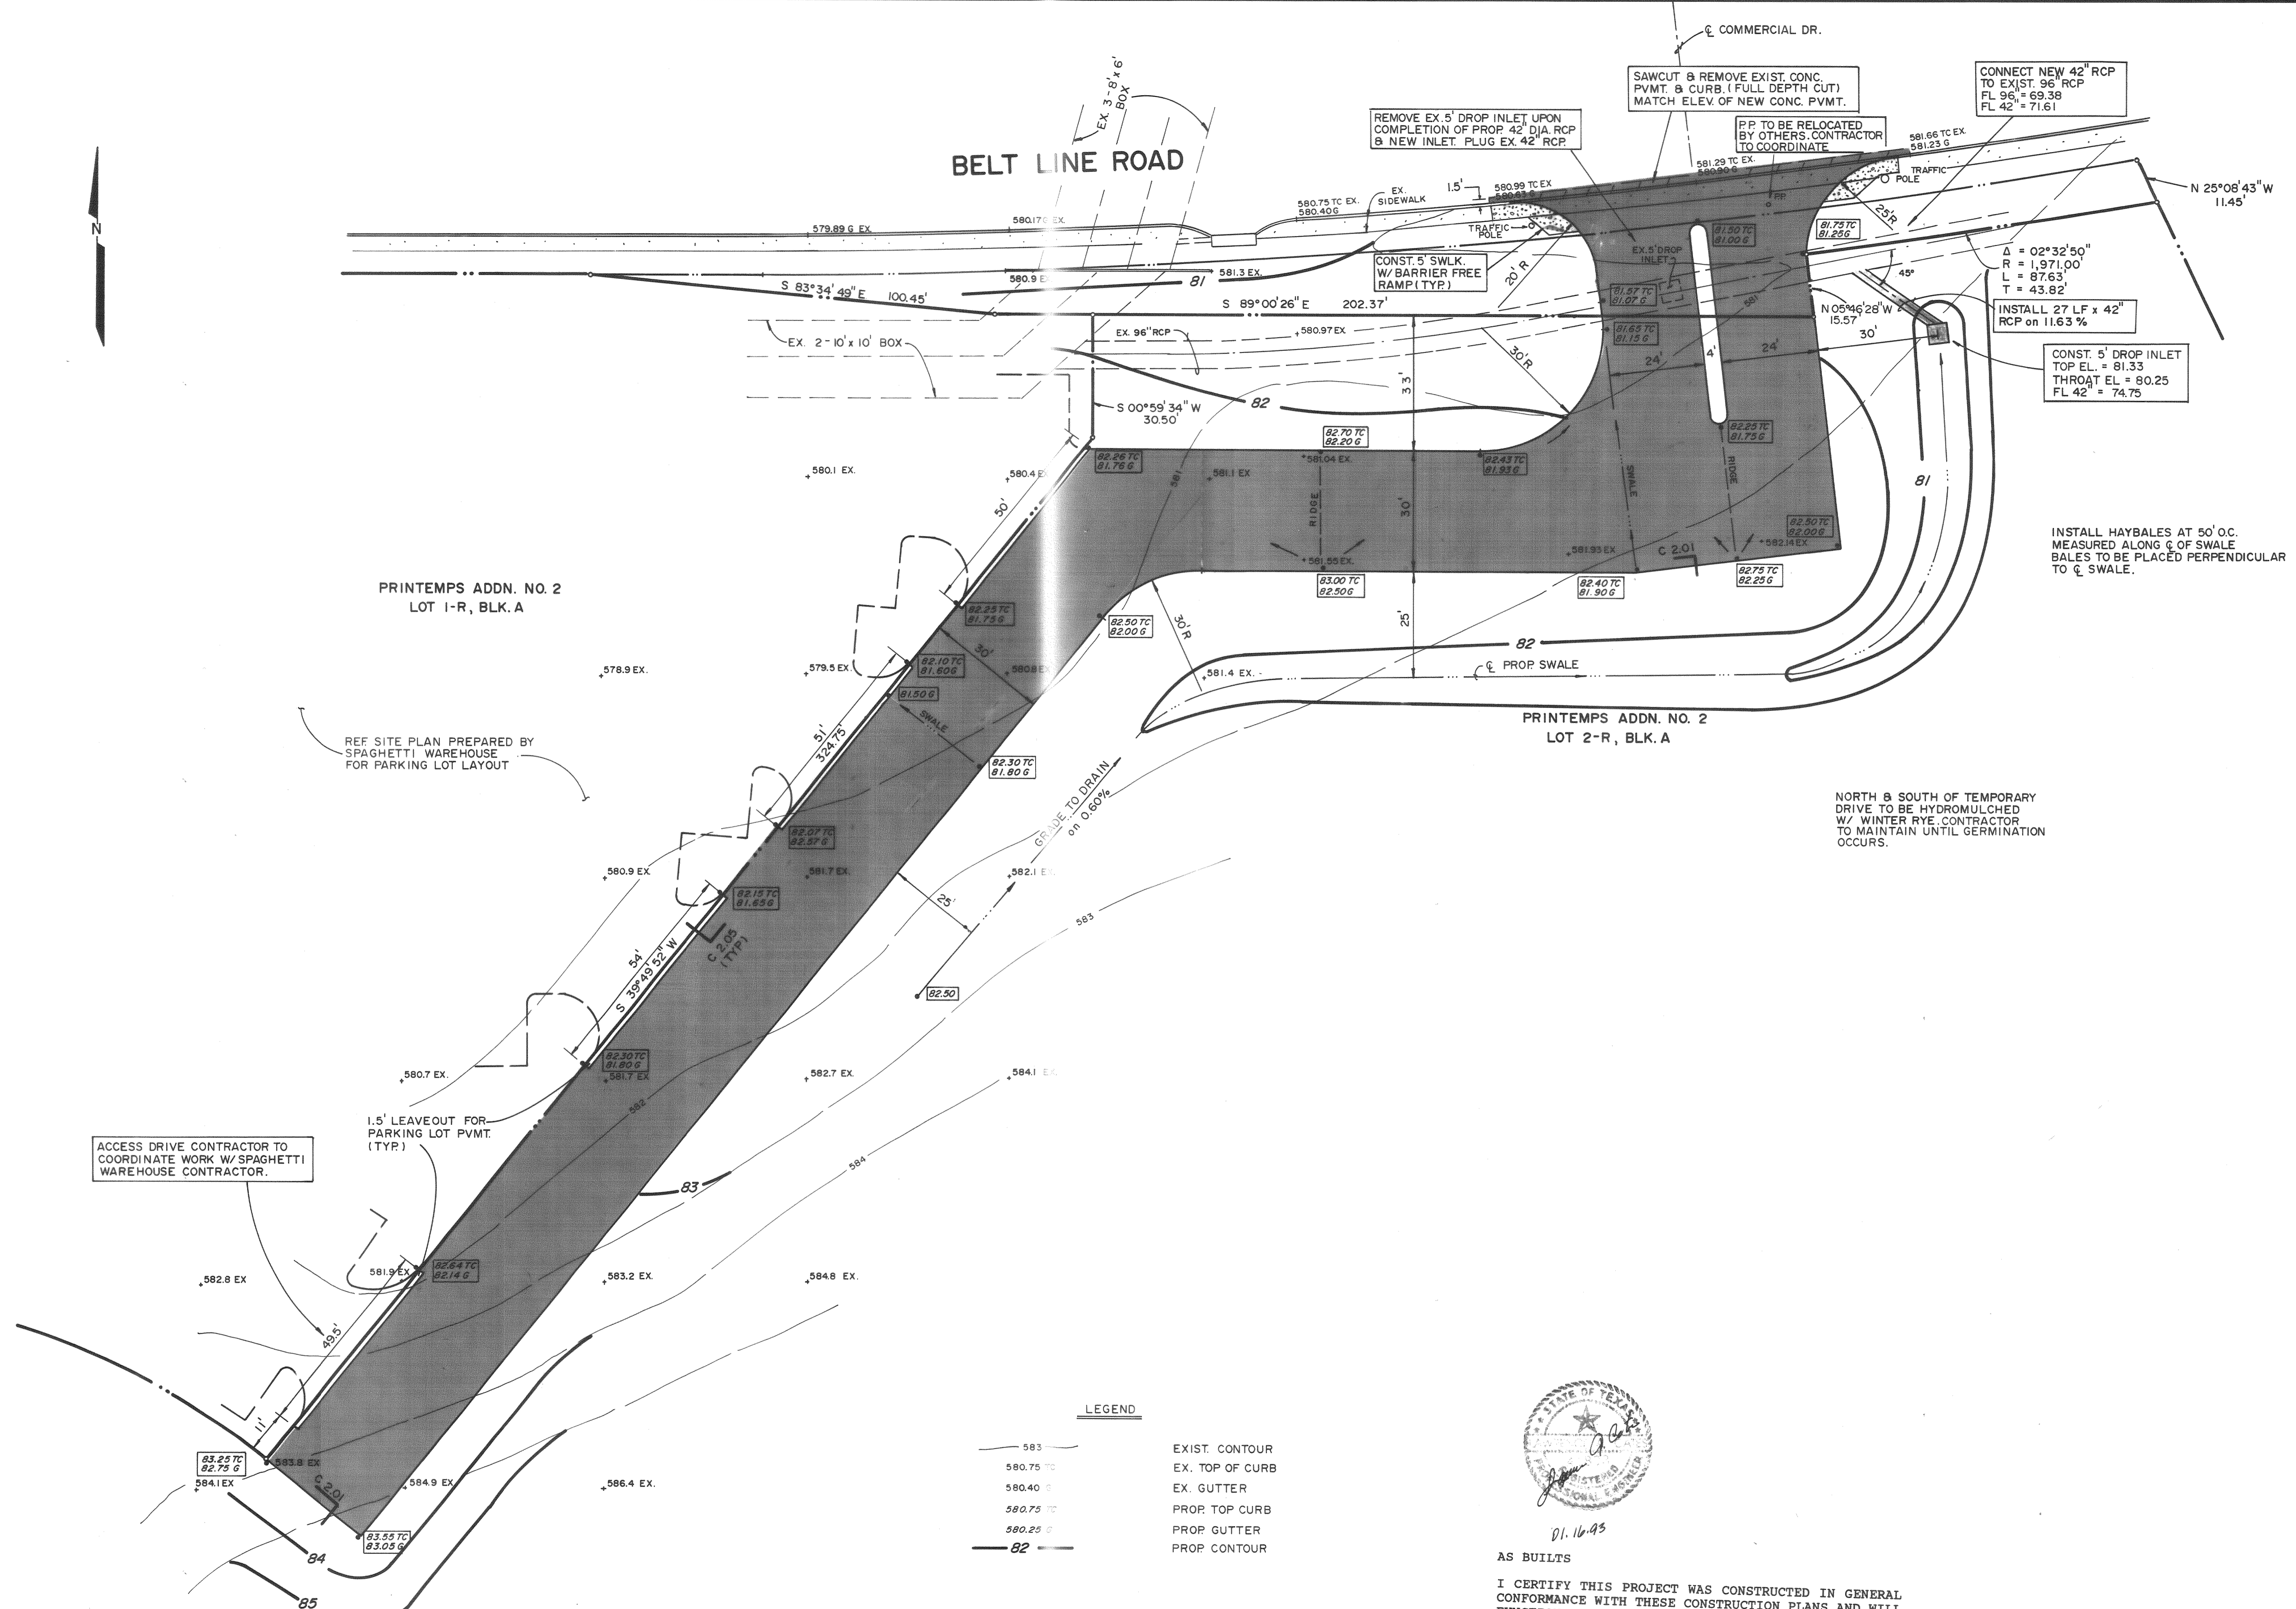

REF SITE PLAN PREPARED BY SPAGHETTI WAREHOUSE FOR PARKING LOT LAYOUT


ACCESS DRIVE CONTRACTOR TO COORDINATE WORK W/ SPAGHETTI WAREHOUSE CONTRACTOR.

1.5' LEAVEOUT FOR PARKING LOT PVMT. (TYP.)

NORTH & SOUTH OF TEMPORARY DRIVE TO BE HYDROMULCHED W/ WINTER RYE. CONTRACTOR TO MAINTAIN UNTIL GERMINATION OCCURS.

LEGEND


— 583 —	EXIST. CONTOUR
— 580.75 TC —	EX. TOP OF CURB
— 580.40 G —	EX. GUTTER
— 580.75 TC —	PROP. TOP CURB
— 580.25 G —	PROP. GUTTER
— 82 —	PROP. CONTOUR

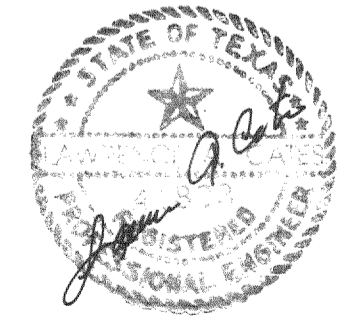

01.16.93
AS BUILTS


I CERTIFY THIS PROJECT WAS CONSTRUCTED IN GENERAL CONFORMANCE WITH THESE CONSTRUCTION PLANS AND WILL FUNCTION AS DESIGNED.

BENCHMARK:
" " CUT ON STORM SEWER INLET ON SOUTH SIDE OF BELT LINE ROAD 70'± WEST OF COMMERCIAL DRIVE.
ELEV. 580.56'

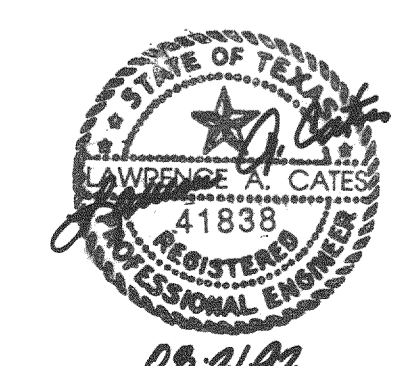


06-21-92

EAST ACCESS DRIVE						
SPAGHETTI WAREHOUSE						
LOT 1-R, PRINTEMPS NO. 1 ADDN.						
TOWN OF ADDISON, TX.						
LAWRENCE A. CATES & ASSOC.						CONSULTING ENGINEERS DALLAS, TEXAS
DESIGN	DRAWN	DATE	SCALE	NOTES	FILE	NO.
LAC	LAC	8/3/92	1"=20'		92023	C-3

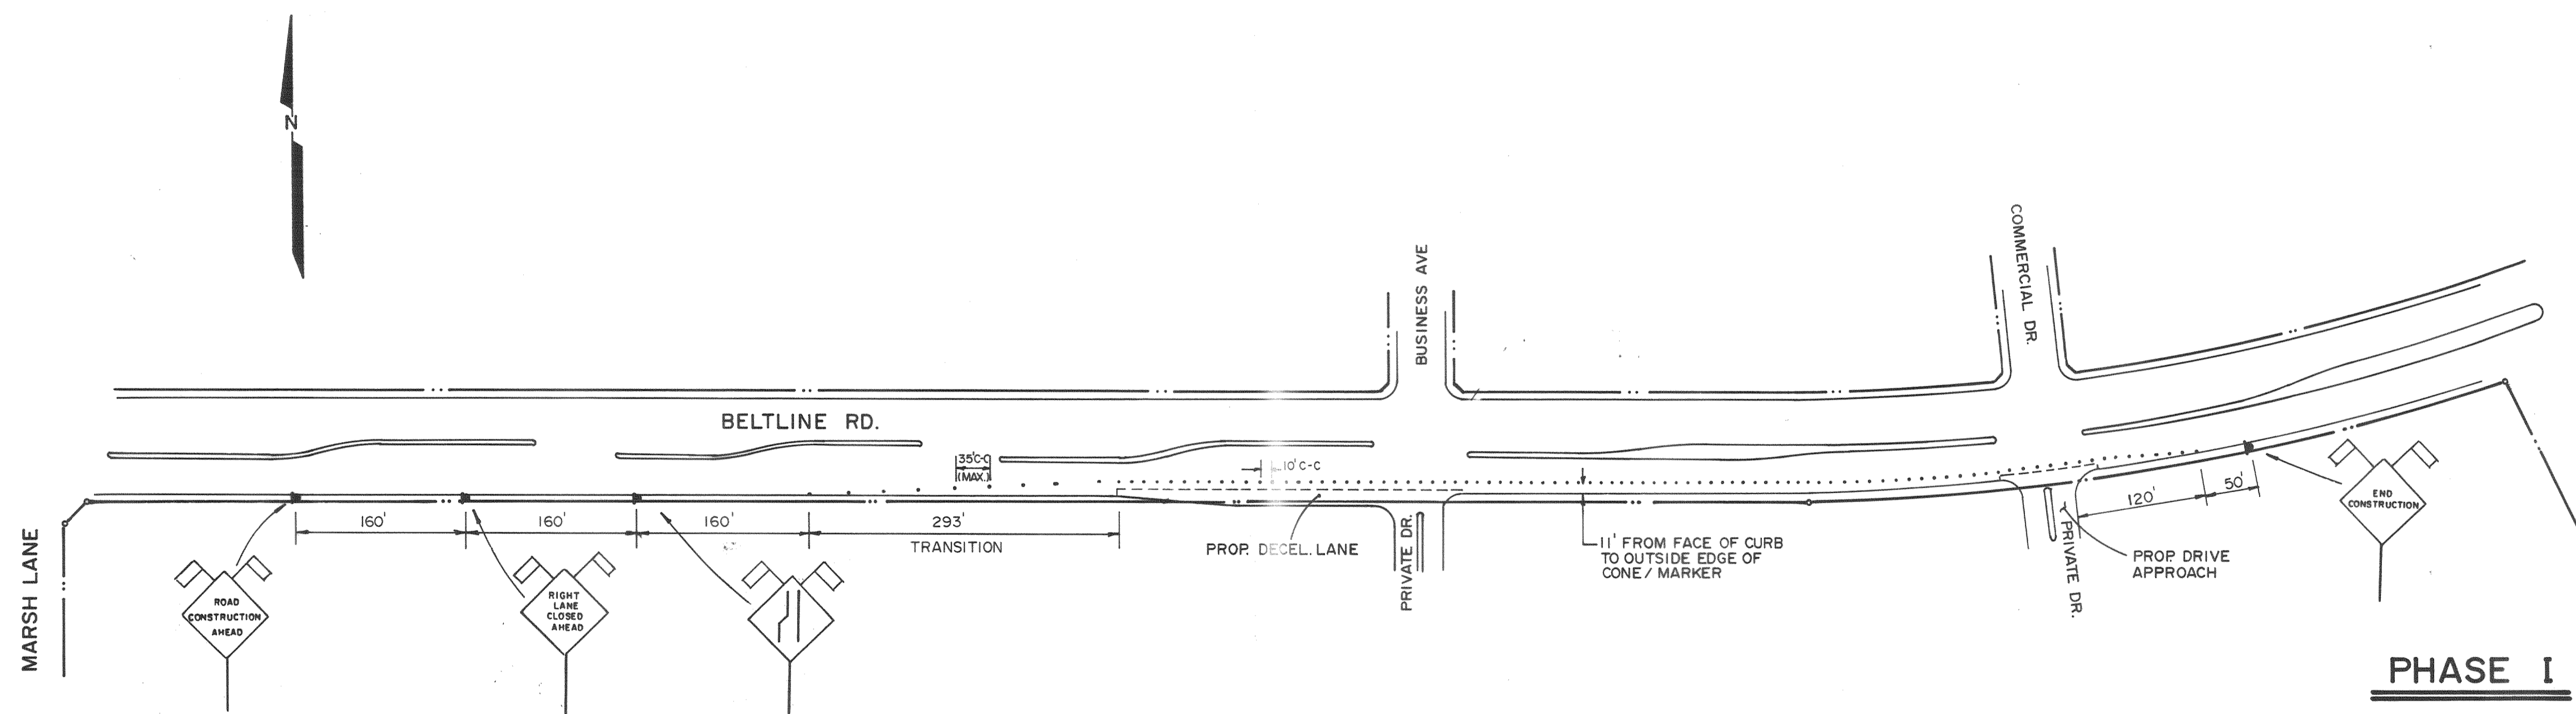


PHASE I

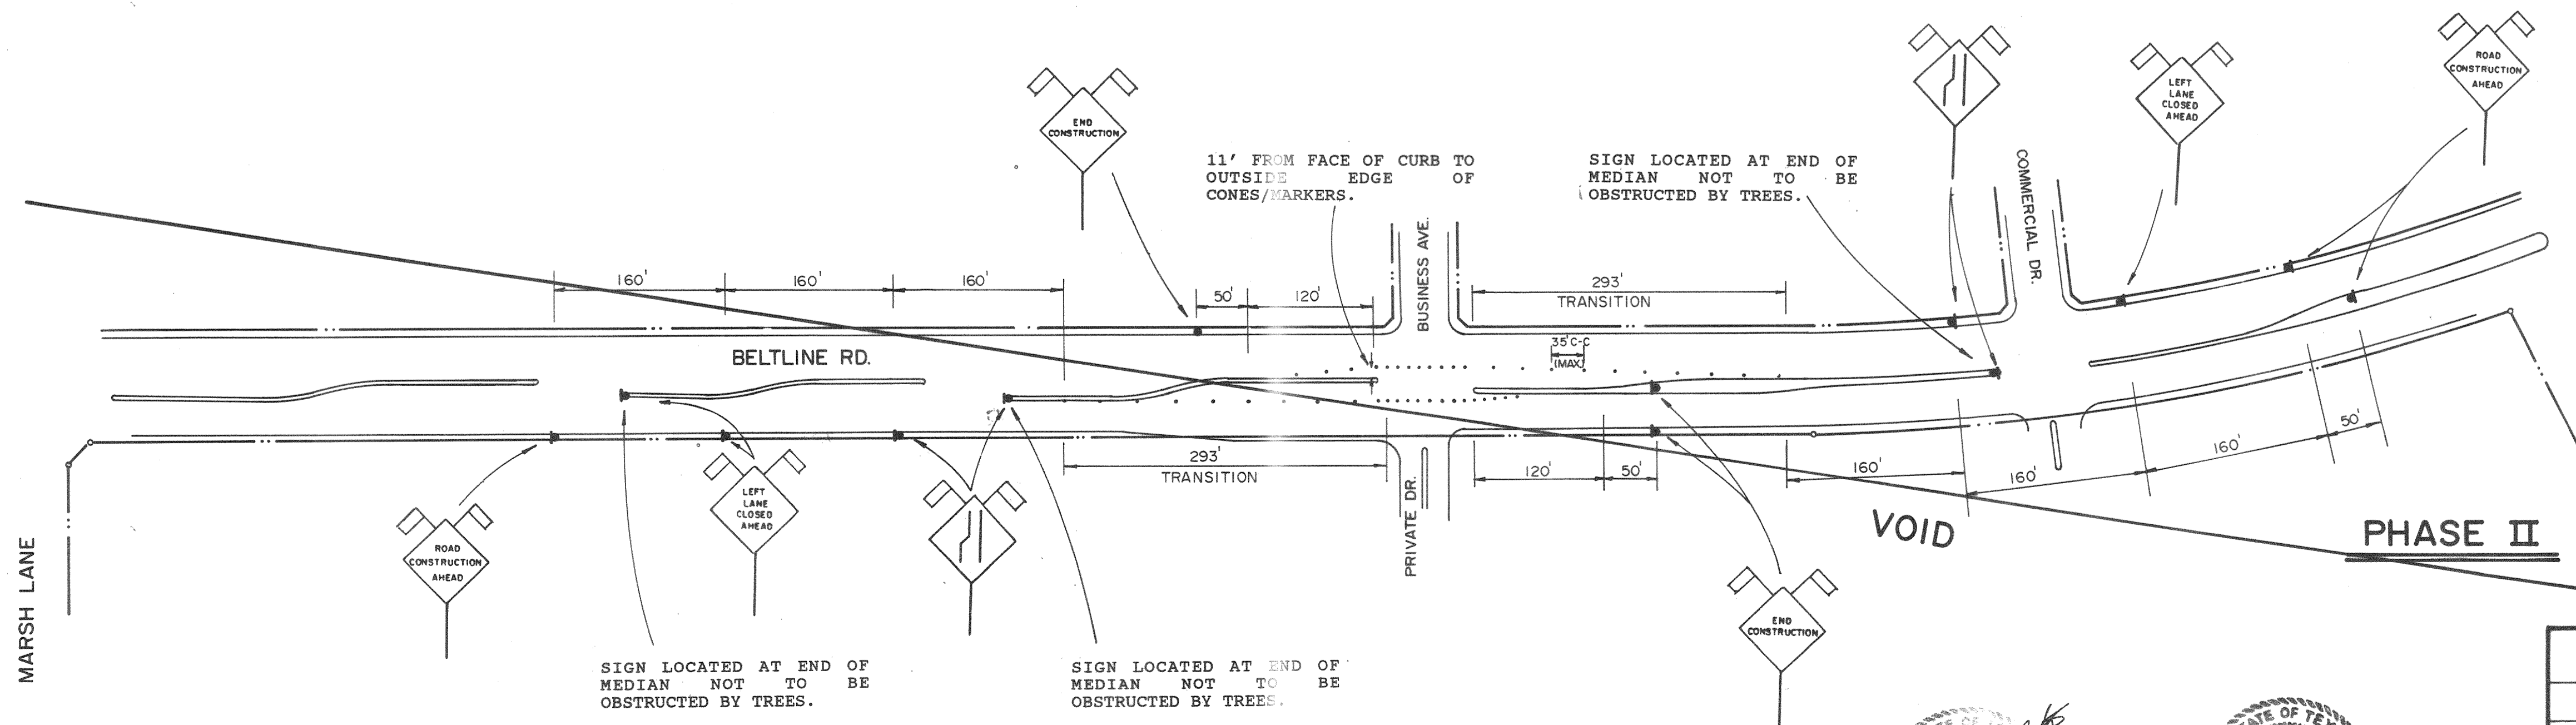

PHASE II



AS BUILTS

I CERTIFY THIS PROJECT WAS CONSTRUCTED IN GENERAL CONFORMANCE WITH THESE CONSTRUCTION PLANS AND WILL FUNCTION AS DESIGNED.

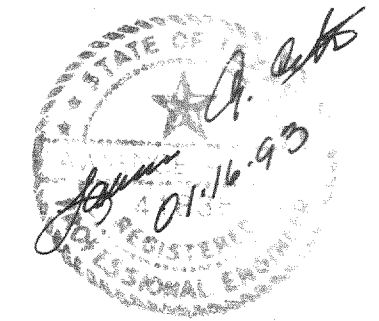


TRAFFIC CONTROL PLAN						
BELTLINE RD. EAST OF MARSH LN.						
TOWN OF ADDISON, TEXAS						
LAWRENCE A. CATES & ASSOC. CONSULTING ENGINEERS DALLAS, TEXAS						
DESIGN	DRAWN	DATE	SCALE	NOTES	FILE	NO.
L.A.C.	L.A.C.	8/24/92	1"=100'		92023	C-4

BELT LINE ROAD (100' R.O.W.)

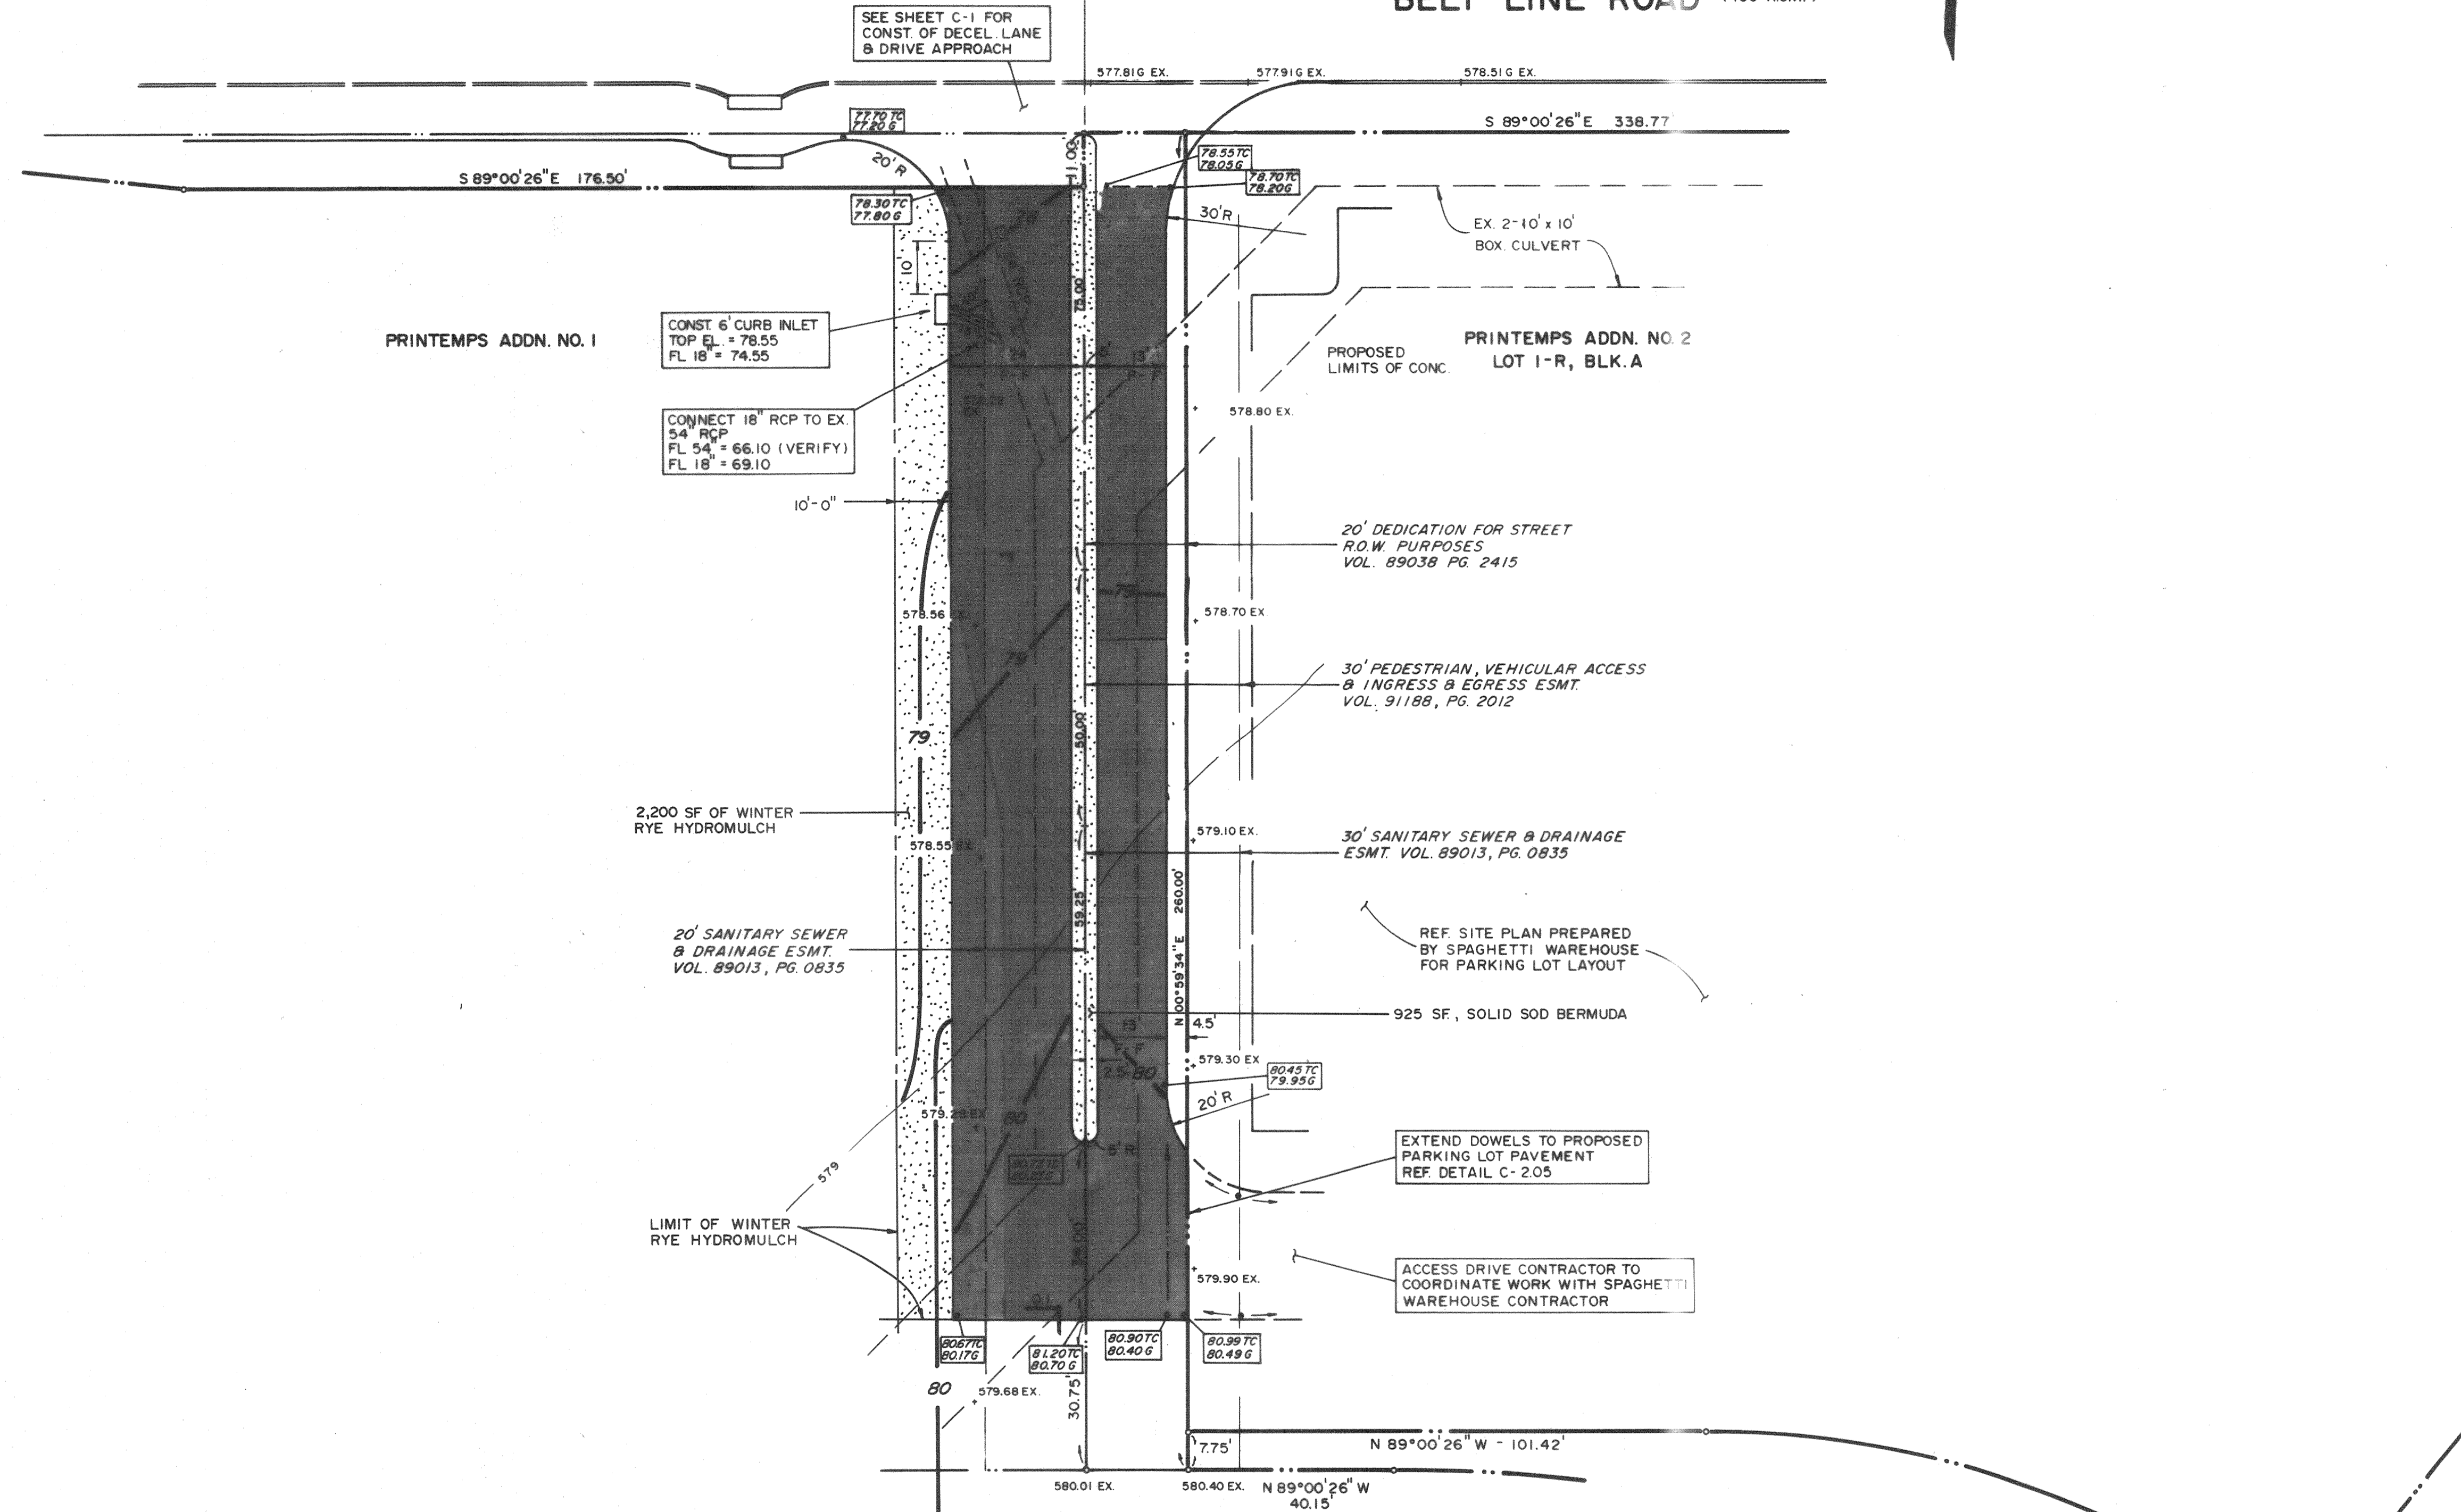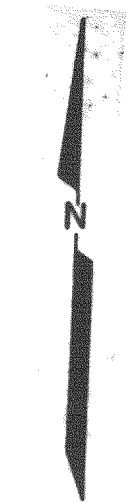

SOD INSTALLATION NOTES
 Grass: Bermuda; Blocks of sod should be laid joint to joint after fertilizing the ground first. The sod should be rolled after planting to level the lawn. The joints between the blocks of sod should be filled with sharp sand where they are evidently gapped open, then watered thoroughly.

- NOTES**
1. All lawn areas to be Solid Sod or hydromulch winter rye.
 2. All planting beds and lawn areas to be separated by steel edging.
 3. Landscape Contractor to locate all underground utilities before beginning construction and notify Owner of any subsequent conflicts.
 4. Landscape Contractor to field verify location of all existing and proposed site elements and report any discrepancies to Owner.
 5. All planting beds and lawn areas to slope away from structures at a minimum of 2%.
 6. All landscape areas to be 100% irrigated with an underground automatic irrigation system.

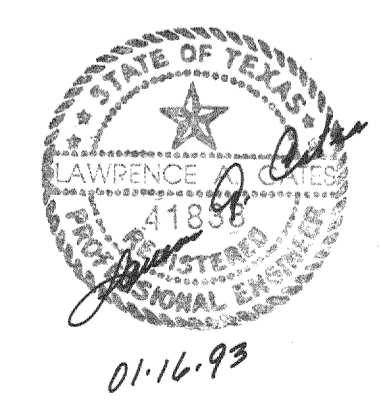

SMR LANDSCAPE ARCHITECTS
 703 McKinney, Suite 403 LB 107
 Dallas, Texas 75202

LANDSCAPE PLAN

AS BUILTS
 I CERTIFY THIS PROJECT WAS CONSTRUCTED IN GENERAL CONFORMANCE WITH THESE CONSTRUCTION PLANS AND WILL FUNCTION AS DESIGNED.

BENCHMARK:
 "X" CUT ON STORM SEWER INLET ON SOUTH SIDE OF BELT LINE ROAD 70'± WEST OF COMMERCIAL DRIVE.
 ELEV. 580.56'



REV: 08-28-92 REV. DRIVE
 REV: 08-17-92 PER CITY COMMENTS


WEST ACCESS DRIVE						
SPAGHETTI WAREHOUSE						
LOT 1-R, PRINTemps NO. 1 ADDN.						
TOWN OF ADDISON, TX.						
LAWRENCE A. CATES & ASSOC. CONSULTING ENGINEERS DALLAS, TEXAS						
DESIGN	DRAWN	DATE	SCALE	NOTES	FILE	NO.
L.A.C.	L.A.C.	7/20/92	1"=20'		92023	L-1

FROM	TO	DISTANCE	PVC CONDUIT T-TRENCH P-PUSH	CABLE										
				SWITCHING			DETECTOR			GRD		LOOP		PWR
				12C	7C	7C	2C	3C	1C	1C	1C	1C	3C	3C
3	PB4	10'				25								
	PB9	15'	1-2" T				50						440	
	PB4	105'				115	230							
2	PB3	10'				25								
	PB3	50'				120	120							
	PB2	10'	1-2" T	25					25					
	PB2	40'		80	160	160			80					
1	PB1	6'				21								
	PB1	22'		32	96	64			32					
	PB6	8'		18	18	18	18	18	18	476				
	PB6	53'		63	63	63	63							
	PB7	5'	1-3" T	20	20	20	20							
TOTALS				101	137	663	642	101	238	916				

ITEM	Unit	Quan.
CONDUIT: 1-3" PVC TRENCH 1-2" PVC TRENCH	L.F.	5 25
PULL BOX	Ea	1
3M OPTICOM DETECTOR OPTICAL AMPLIFIER	Ea	1
PEDESTRIAN PUSH BUTTON W/ INTEGRAL SIGN	Ea	6
LOOP DETECTOR AMPLIFIER	Ea	3
CABLE-WIRE: 12 CONDUCTOR #12 7 CONDUCTOR #12 7 CONDUCTOR #12 (PED) 2 CONDUCTOR (DET) 3 CONDUCTOR (OPTICOM) 1 CONDUCTOR #8 (GROUND)	L.F.	101 137 663 642 101 238
THHN DETECTOR LOOP (1c#12)	L.F.	788
FOUNDATIONS: CONTROLLER TYPE 30-A 24-A	Ea	1 1
POLES SIGNAL PEDESTAL MAST ARM POLE w/30' ARM	Ea	1 1
SIGNAL HEADS: 4 SECTION 12" LENS 3 SECTION " " " 1 SECTION PEDESTRIAN	Ea	3 2 6

NOTE TO CONTRACTOR:
1. PRIOR TO BEGINNING ANY CONSTRUCTION IN ADDISON, NOTIFY ROBIN JONES, DIRECTOR OF STREETS # 450-7244 AND DON PREECE, DIRECTOR OF UTILITIES # 450-72

HEAD NUMBERS	9, 10, 22	5, 11, 12	14, 17, 18	19, 20, 21
LENS SIZE	12"	12"	-	-
TYPE	CONV.	CONV.	PED.	PED.
LENS CONFIGURATION	R V G	R V G	DW/W	DW/W
TOTAL NO. OF UNITS	2	3		6


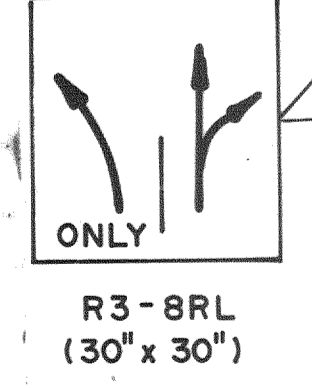


- 5 INSTALL PEDESTAL SIGNAL POLE
- 4 30' INSTALL SIGNAL MAST ARM & POLE
- 3 EXIST. SIGNAL MAST ARM & POLE
- ▷ 5 INSTALL TRAFFIC SIGNAL HEAD
- ▷ 4 EXIST. TRAFFIC SIGNAL HEAD
- ▷ 17 INSTALL PEDESTRIAN PUSH BUTTON & ILLUMINATED SIGN
- ▷ 16 EXIST. PEDESTRIAN PUSH BUTTON & ILLUMINATED SIGN
- ◄ 5 INSTALL OPTICOM DETECTOR ONE DIRECTION
- ◄ 4 EXIST. OPTICOM DETECTOR ONE DIRECTION
- INSTALL SIGNAL PULLBOX
- EXIST. SIGNAL PULLBOX
- ⊠ EXIST. CONTROLLER & FOUNDATION
- POWER POLE SERVICE SOURCE
- PVC CONDUIT
- - - - - EXISTING U.G. UTILITIES
- == SEWER
- EXIST. PVC CONDUIT



NOTE 1. ALL PAVEMENT MARKINGS & SIGNS REQUIRED WITH THIS INSTALLATION TO MEET M.U.T.C.D. STANDARDS.
2. THE EXISTING 3 SECTION SIGNAL HEAD AT LOCATION ③ IS TO BE RELOCATED FOR USE AS POLE MOUNTED SIGNAL AT LOCATION ②

AS BUILTS
I CERTIFY THIS PROJECT WAS CONSTRUCTED IN GENERAL CONFORMANCE WITH THESE CONSTRUCTION PLANS AND WILL FUNCTION AS DESIGNED.

TRAFFIC SIGNAL INSTALLATION						
COMMERCIAL DR. AT BELTLINE ROAD						
TOWN OF ADDISON, TEXAS						
LAWRENCE A. CATES & ASSOC. CONSULTING ENGINEERS DALLAS, TEXAS						
DESIGN	DRAWN	DATE	SCALE	NOTES	FILE	NO.
L.A.C.	L.A.C.	8/24/92	1" = 20'			TI

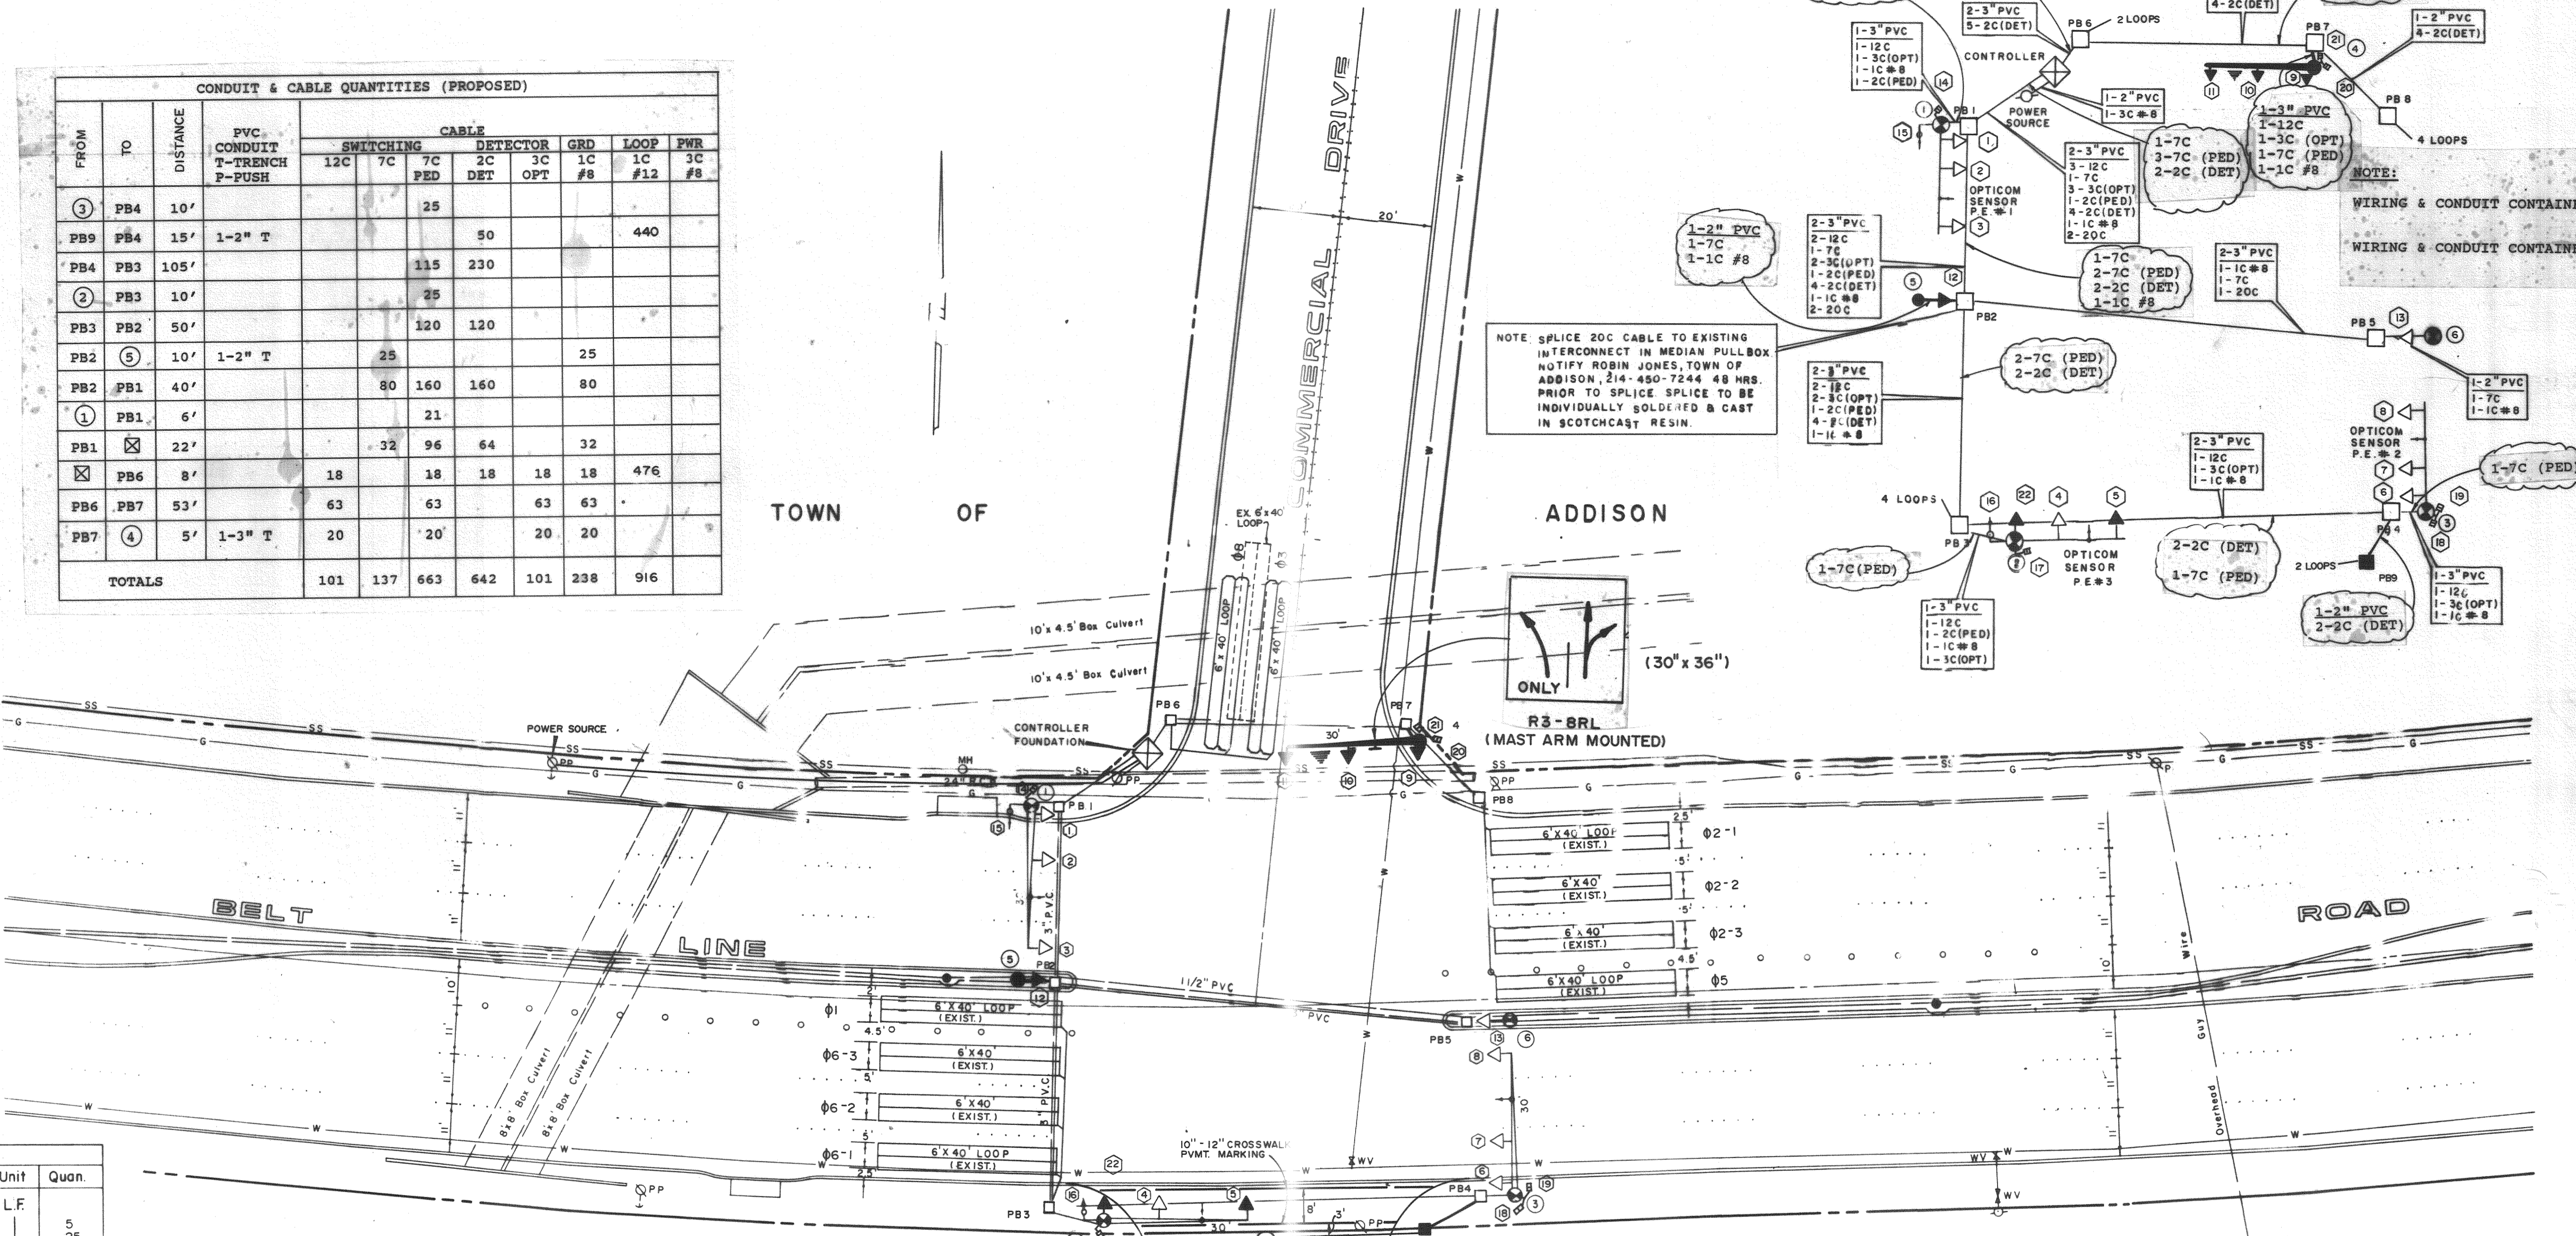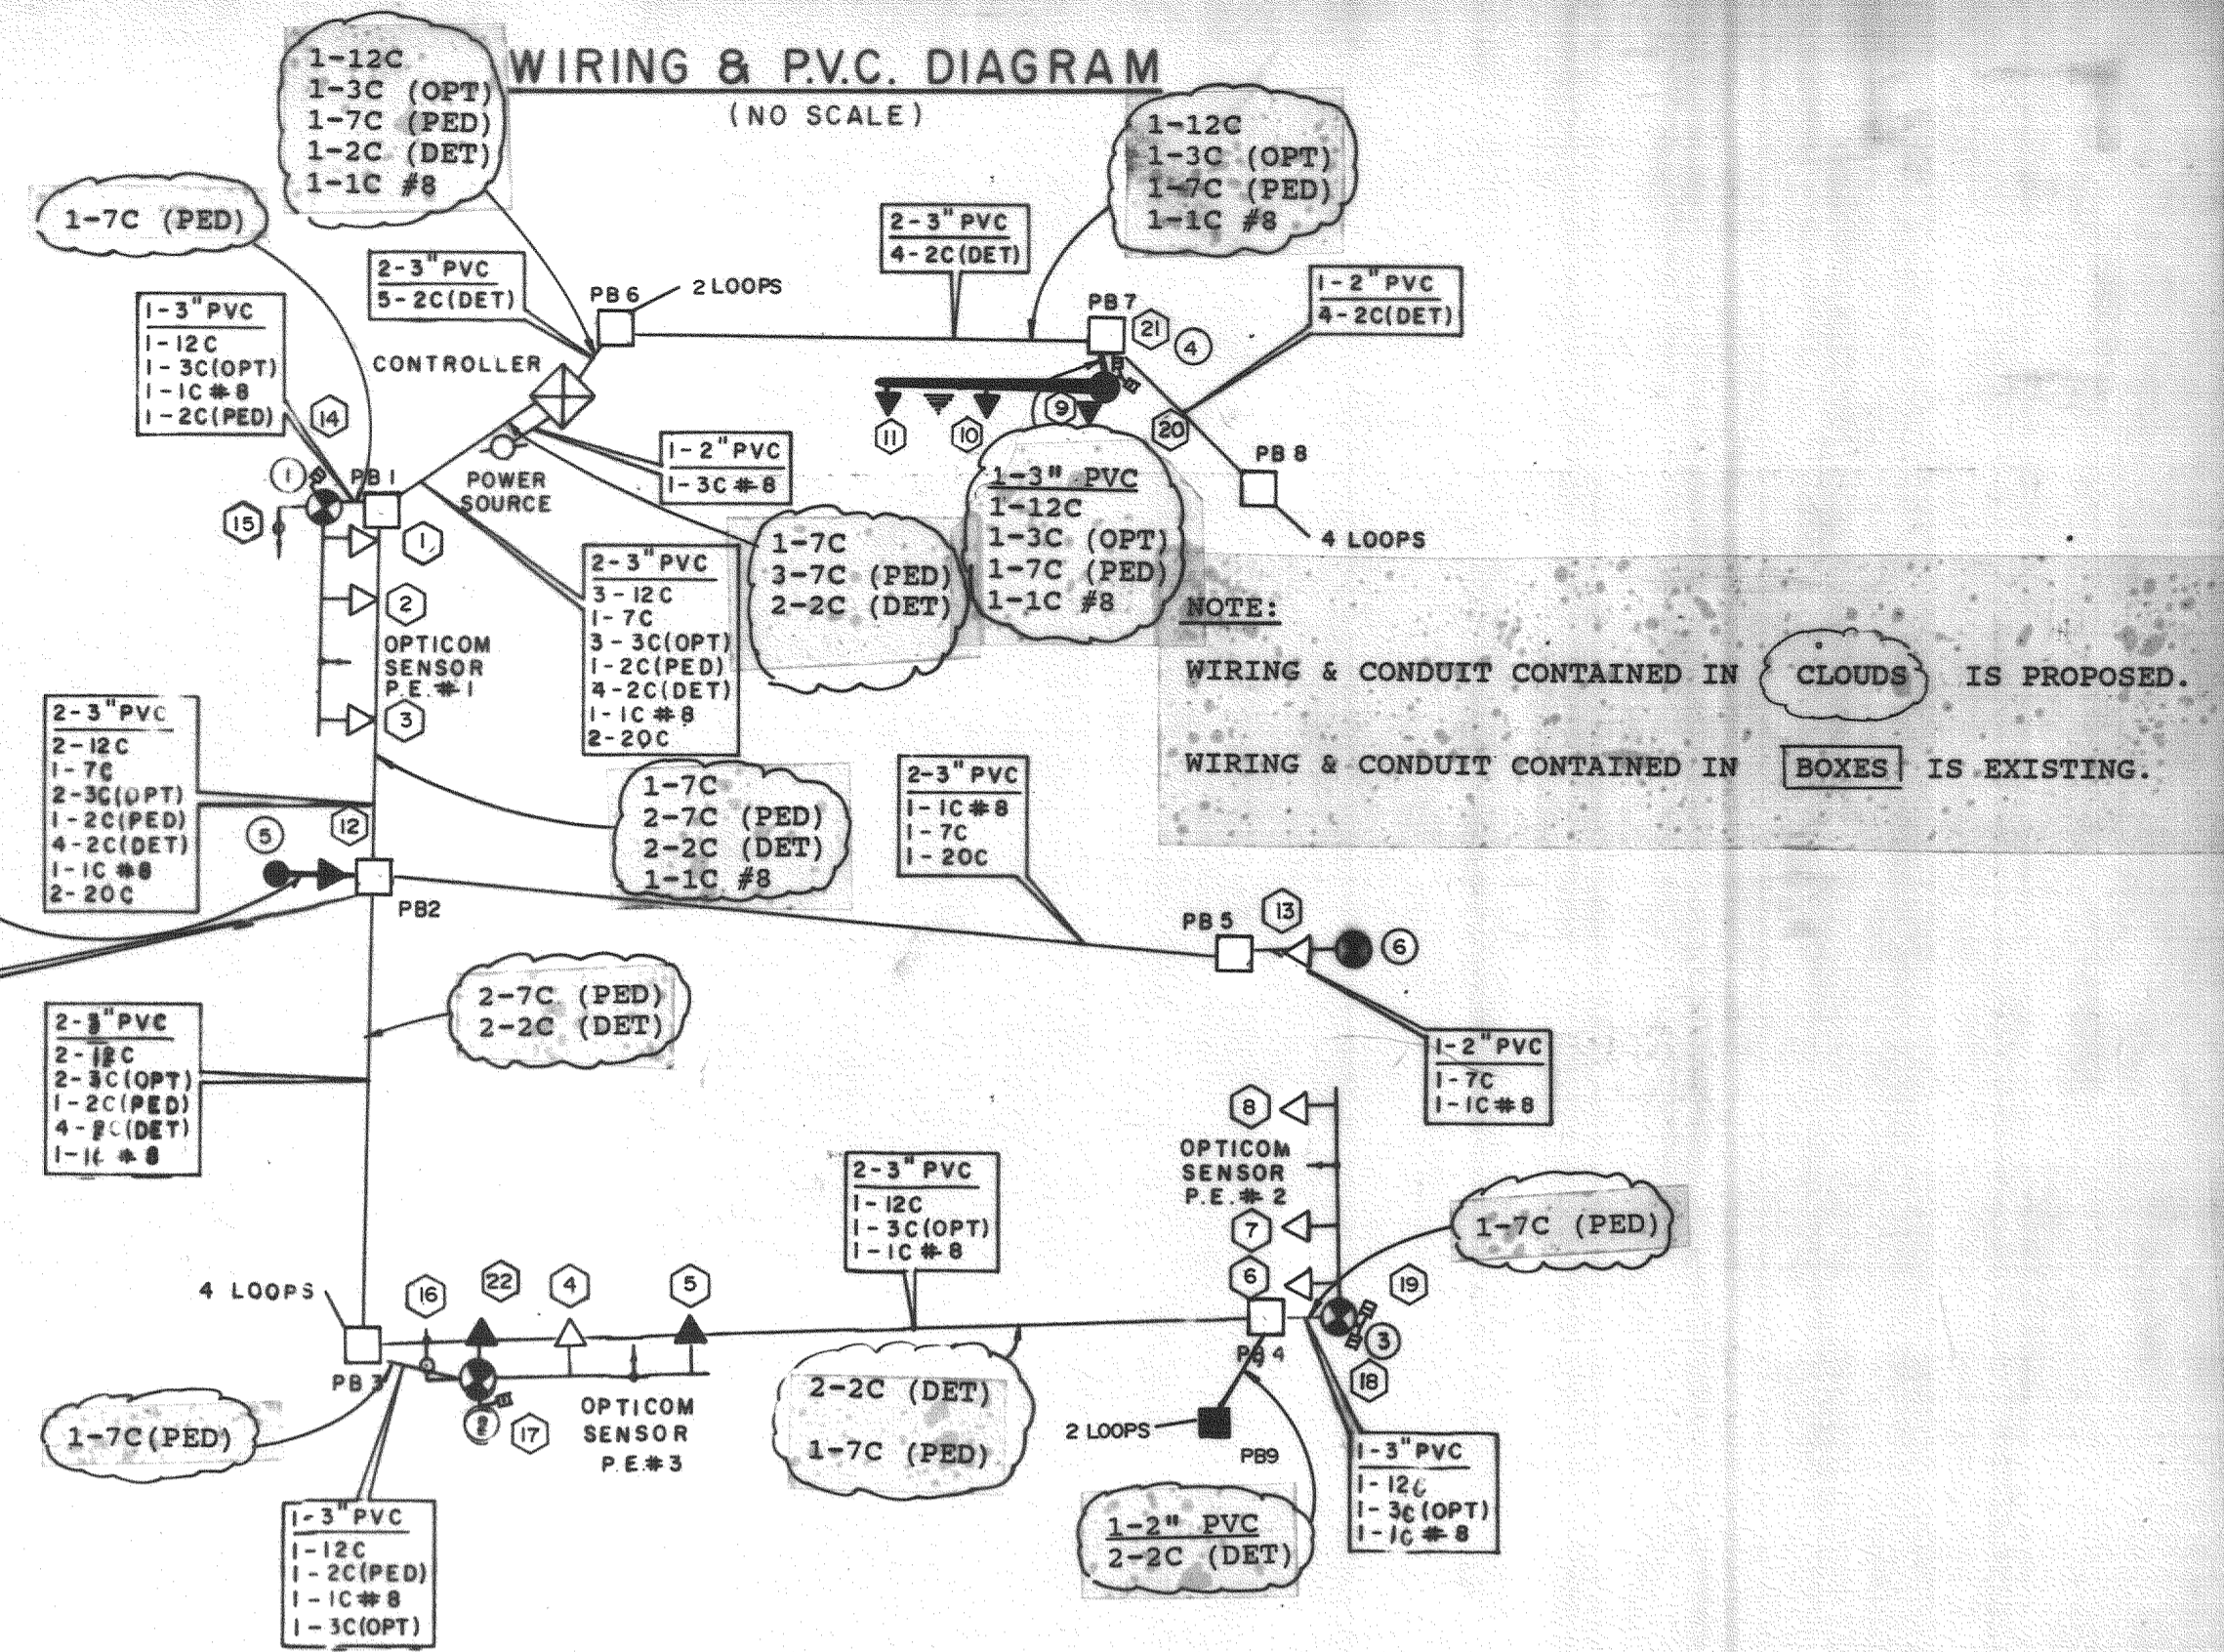

PHASE DIAGRAM

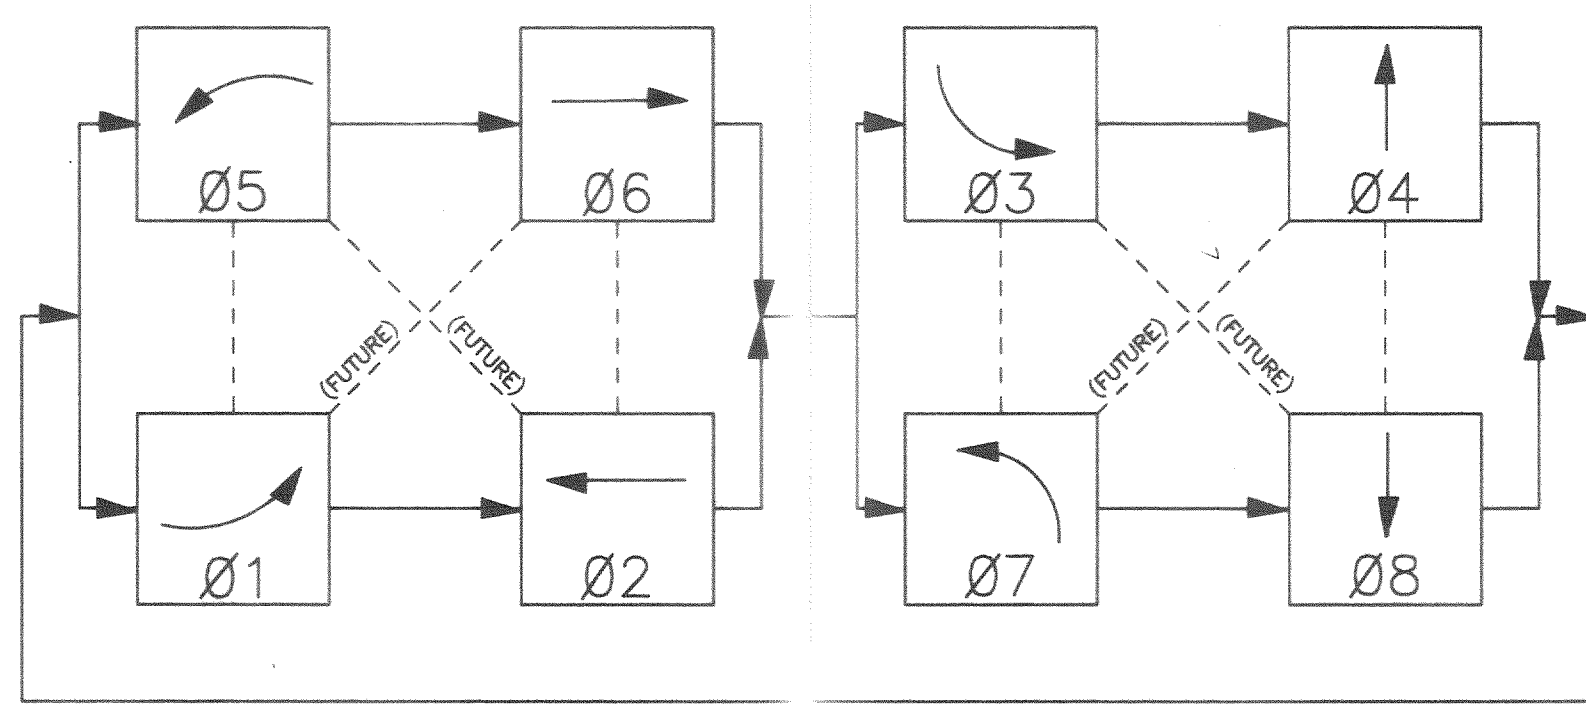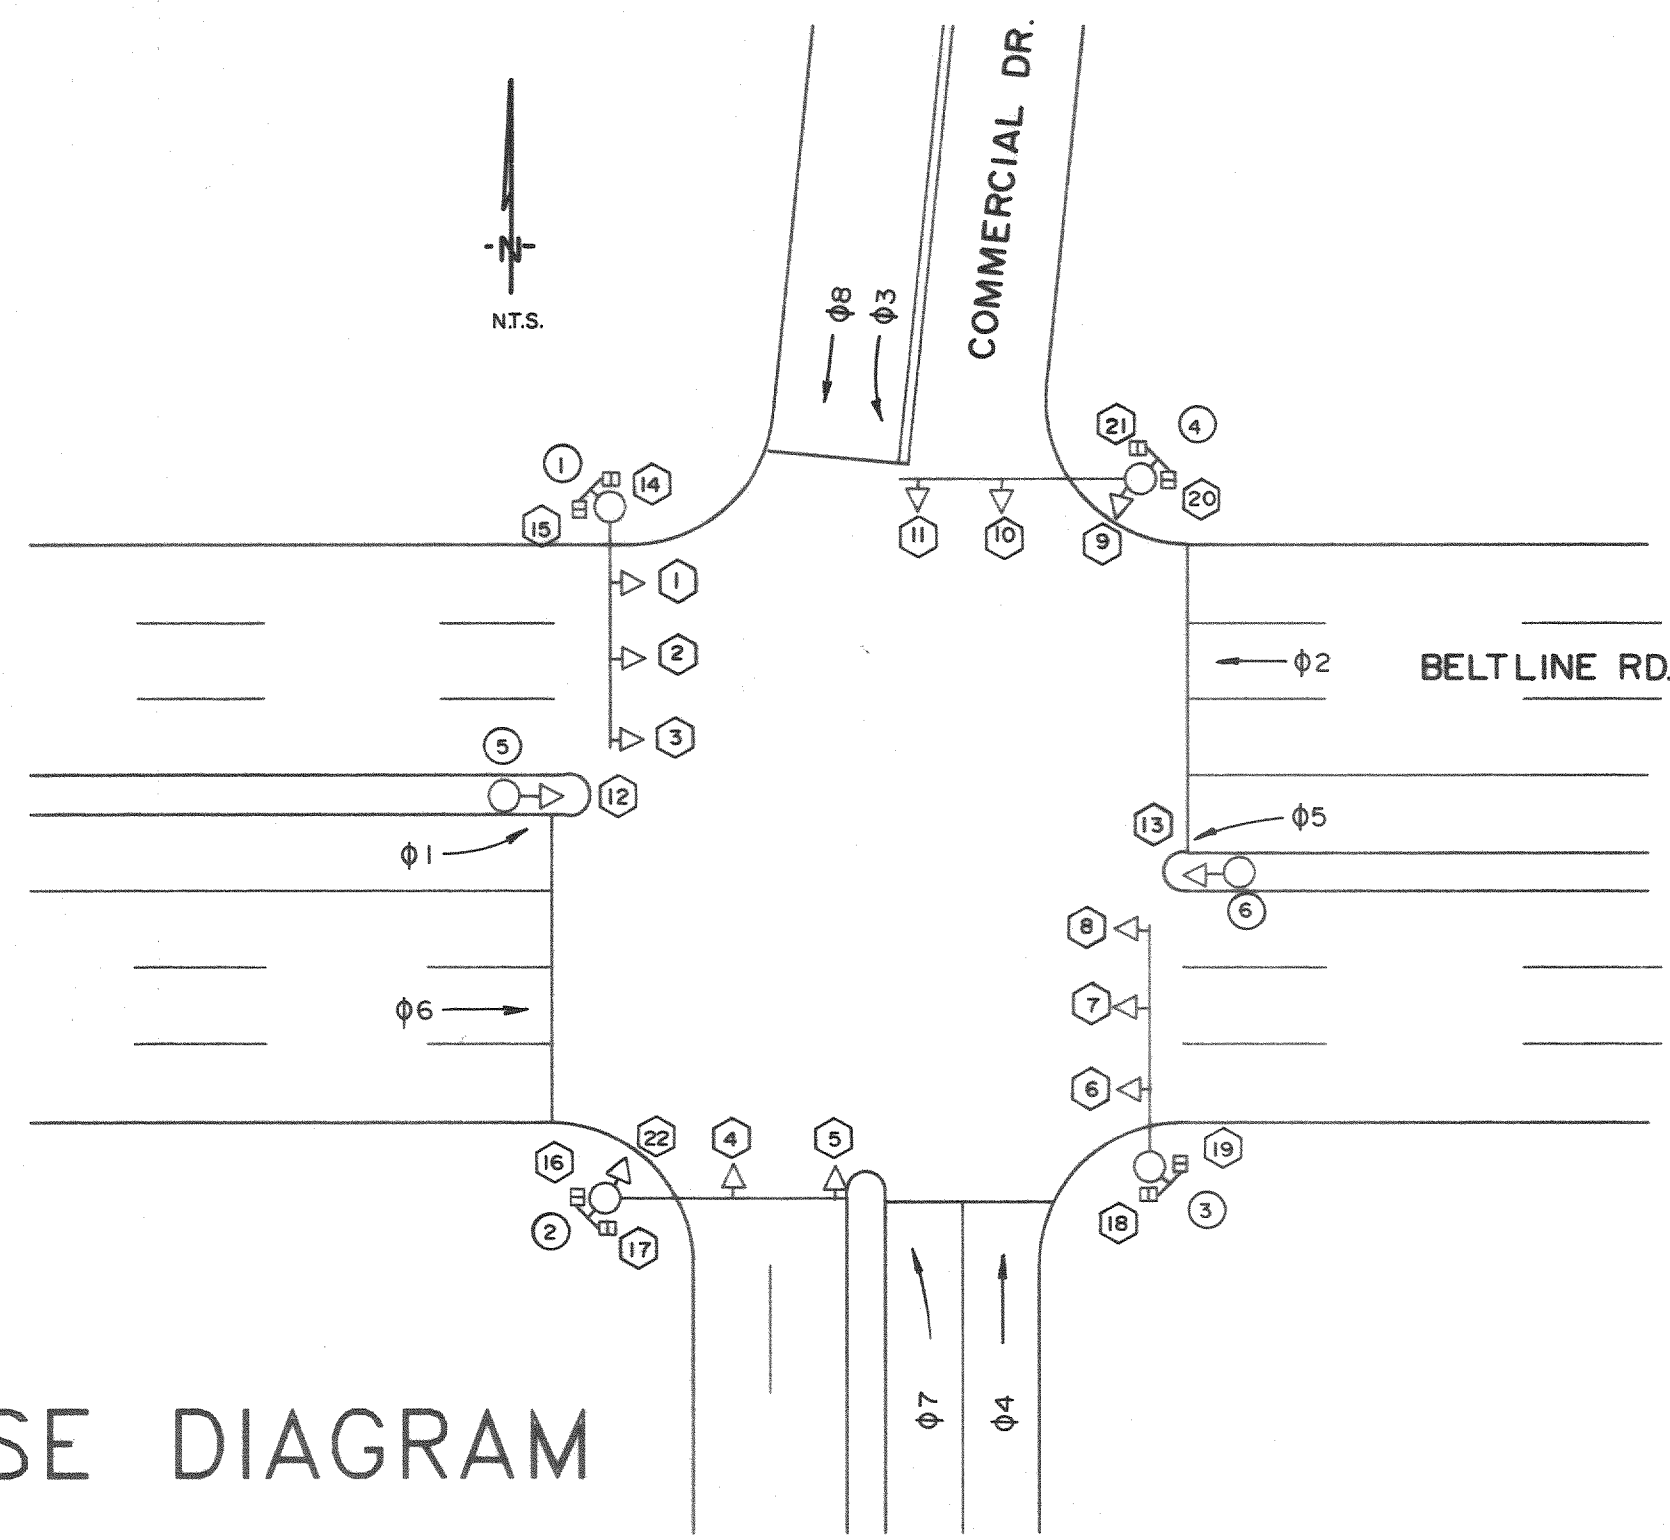


PHASE SEQUENCE

HEAD NO.	1	2	3	4	5	6	7	8	9	10	11	12	13	14	15	16	17	18	19	20	21	22	
INDICATION	R	R	R	R	R	R	R	R	R	R	R	R	R	DW	DW	DW	DW	DW	DW	DW	DW	DW	R
	Y	Y	Y	Y	Y	Y	Y	Y	Y	Y	Y	Y	Y									Y	
	G	G	G	G	G	G	G	G	G	G	G	G	G									G	

PHASE	SIGNAL HEAD NO.	Ø1 + Ø5					Ø2 + Ø6					Ø3 + Ø7					Ø4 + Ø8					Ø1 + Ø6					Ø2 + Ø5					Ø3 + Ø8					Ø4 + Ø7					FLASHING OPERATION			
		R/W	PED. CLEAR	CLEAR TO PHASE Ø2+Ø6	CLEAR TO PHASE Ø1+Ø6	CLEAR TO PHASE Ø2+Ø5	ALL CLEAR	R/W	PED. CLEAR	CLEAR TO PHASE Ø1+Ø5	CLEAR TO PHASE Ø2+Ø5	CLEAR TO PHASE Ø6+Ø1	ALL CLEAR	R/W	PED. CLEAR	CLEAR TO PHASE Ø4+Ø8	CLEAR TO PHASE Ø3+Ø8	CLEAR TO PHASE Ø4+Ø7	ALL CLEAR	R/W	PED. CLEAR	CLEAR TO PHASE Ø3+Ø7	CLEAR TO PHASE Ø4+Ø8	CLEAR TO PHASE Ø3+Ø8	ALL CLEAR	R/W	PED. CLEAR	CLEAR TO PHASE Ø6+Ø2	CLEAR TO PHASE Ø1+Ø5	ALL CLEAR	R/W	PED. CLEAR	CLEAR TO PHASE Ø2+Ø6	CLEAR TO PHASE Ø1+Ø5	ALL CLEAR	R/W	PED. CLEAR	CLEAR TO PHASE Ø4+Ø8	CLEAR TO PHASE Ø7+Ø3	ALL CLEAR	R/W	PED. CLEAR	CLEAR TO PHASE Ø4+Ø8	CLEAR TO PHASE Ø7+Ø3	ALL CLEAR
Ø2	1-3	R		R	R	R	R	G	G	Y	G	Y	Y	R		R	R	R	R	R	R	R	R	R	R	R	R	R	R	R	R	R	R	R	R	R	R	R	R	R	Y	R			
Ø8	4,22	R		R	R	R	R	R	R	R	R	R	R	R		R	R	R	R	R	G	G	Y	Y	G	Y	R	R	R	R	R	R	R	R	R	R	R	R	R	R	R	R			
Ø3	5	R		R	R	R	R	R	R	R	R	R	R	G/R		Y/R	G/R	Y/R	Y/R	Y/R	G	G	Y	Y	G	Y	R	R	R	R	R	R	R	R	R	R	R	R	R	R	R	R			
Ø6	6-8	R		R	R	R	R	G	G	Y	Y	G	Y	R		R	R	R	R	R	R	R	R	R	R	R	R	R	R	R	R	R	R	R	R	R	R	R	R	R	R	R	Y	R	
Ø4	9-10	R		R	R	R	R	R	R	R	R	R	R	R		R	R	R	R	R	G	G	Y	G	Y	Y	R	R	R	R	R	R	R	R	R	R	R	R	R	R	R	R	R		
Ø7	11	R	OMIT	R	R	R	R	R	R	R	R	R	R	G/R		Y/R	Y/R	G/R	Y/R	Y/R	G	G	Y	G	Y	G	Y	R	R	R	R	R	R	R	R	R	R	R	R	R	R	R	R		
Ø5	12	G/R	OMIT	Y/R	Y/R	G/R	Y/R	G	G	Y	G	Y	Y	R		R	R	R	R	R	R	R	R	R	R	R	R	R	R	R	R	R	R	R	R	R	R	R	R	R	R	R	R		
Ø1	13	G/R	OMIT	Y/R	G/R	Y/R	Y/R	G	G	Y	Y	G	Y	R		R	R	R	R	R	R	R	R	R	R	R	R	R	R	R	R	R	R	R	R	R	R	R	R	R	R	R	R		
Ø2P	14,21	DW		DW	DW	DW	DW	W	FDW	DW	W	DW	DW	DW		DW	DW	DW	DW	DW	DW	DW	DW	DW	DW	DW	DW	DW	DW	DW	DW	DW	DW	DW	DW	DW	DW	DW	DW	DW	DW	DW			
Ø8P	15,16	DW		DW	DW	DW	DW	DW	DW	DW	DW	DW	DW	DW		DW	DW	DW	DW	DW	W	FDW	DW	DW	DW	DW	DW	DW	DW	DW	DW	DW	DW	DW	DW	DW	DW	DW	DW	DW	DW	DW			
Ø6P	17,18	DW		DW	DW	DW	DW	W	FDW	DW	DW	W	DW	DW		DW	DW	DW	DW	DW	DW	DW	DW	DW	DW	DW	DW	DW	DW	DW	DW	DW	DW	DW	DW	DW	DW	DW	DW	DW	DW	DW	DW		
Ø4P	19,20	DW		DW	DW	DW	DW	DW	DW	DW	DW	DW	DW	DW		DW	DW	DW	DW	DW	W	FDW	DW	W	DW	DW	DW	DW	DW	DW	DW	DW	DW	DW	DW	DW	DW	DW	DW	DW	DW	DW			


PHASE & SIGNAL HEAD IDENTIFICATION


NOTE:
 AT THE TIME OF THIS INSTALLATION, THE FOLLOWING PHASE COMBINATIONS WILL NOT BE UTILIZED:
 Ø1+Ø6, Ø2+Ø5, Ø3+Ø8, Ø4+Ø7
 THESE ARE SHOWN FOR FUTURE USE ONLY.

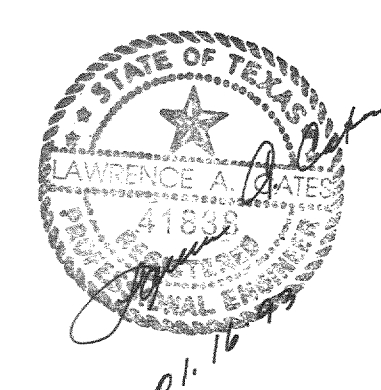


AS BUILTS
 I CERTIFY THIS PROJECT WAS CONSTRUCTED IN GENERAL CONFORMANCE WITH THESE CONSTRUCTION PLANS AND WILL FUNCTION AS DESIGNED.

PHASE & SIGNAL HEAD IDENTIFICATION						
BELTLINE RD. EAST OF MARSH LN.						
TOWN OF ADDISON, TEXAS						
LAWRENCE A. CATES & ASSOC.				CONSULTING ENGINEERS DALLAS, TEXAS		
DESIGN	DRAWN	DATE	SCALE	NOTES	FILE	NO.
LAC	LAC	8/24/92	NTS		92023	T2

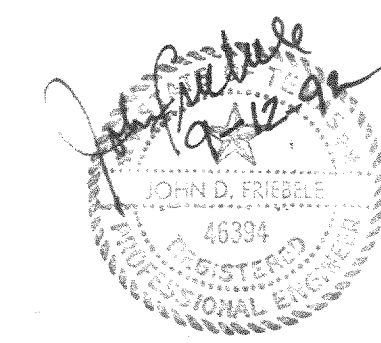

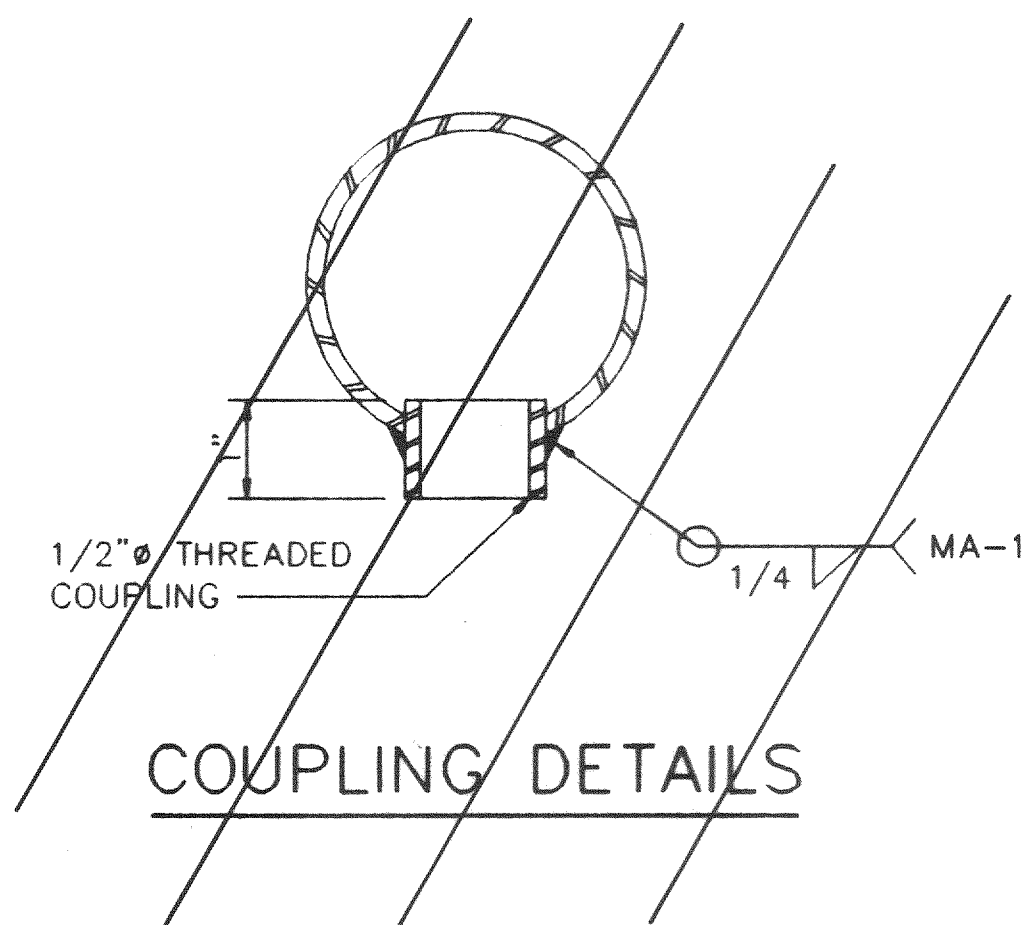


COUPLING DETAILS

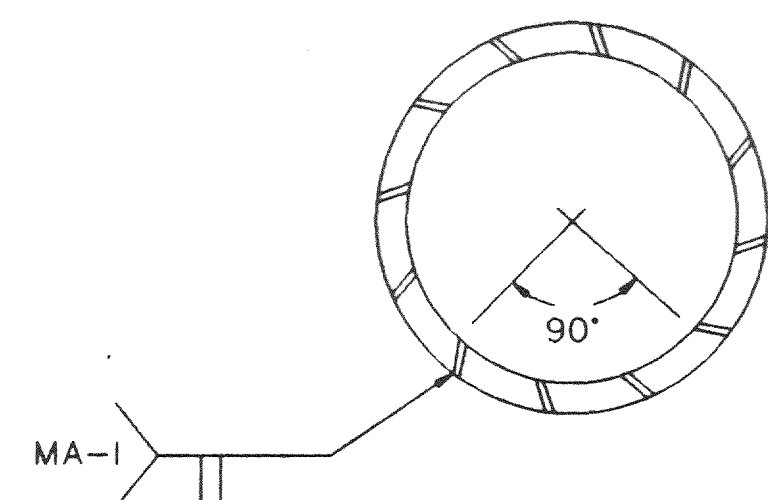


LONGITUDINAL SEAM WELD MUST BE ORIENTED WITHIN THE LOWER 90° OF THE SIGNAL ARM.

ARM WELD DETAIL

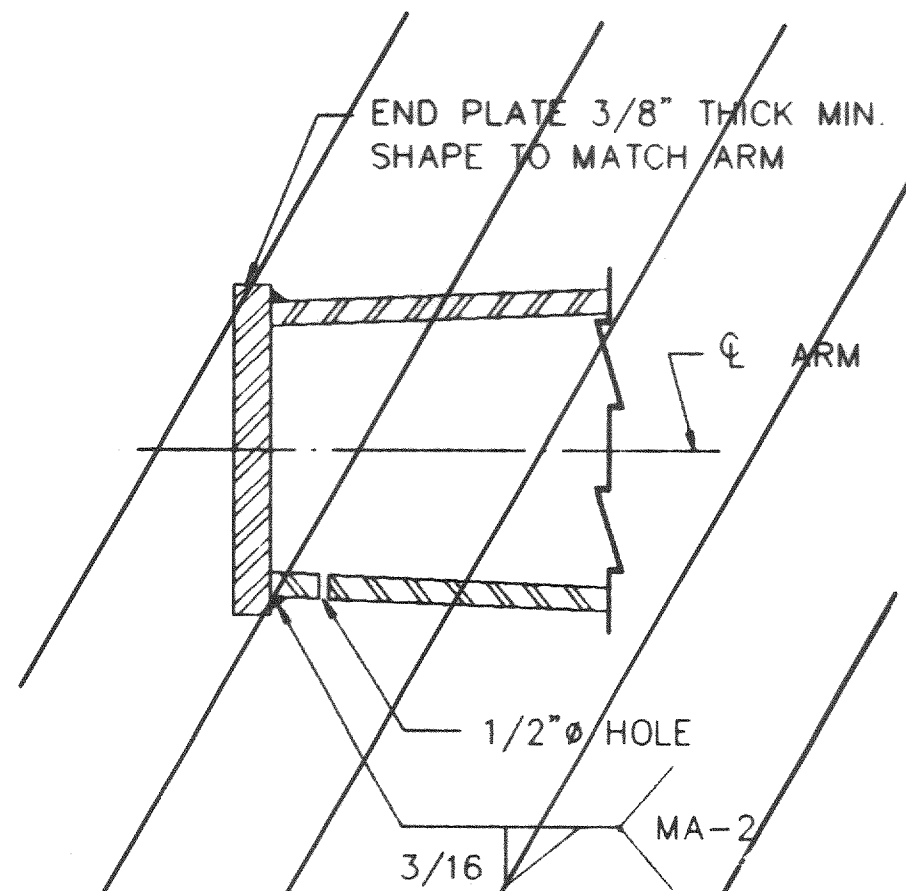

NOTE :
"POLE MANUFACTURER SHALL DRILL 1/2" HOLE IN BOTTOM OF MAST ARM AT END PLATE"
(FOR HOT-DIP GALVANIZING)

PLATE WELD DETAIL

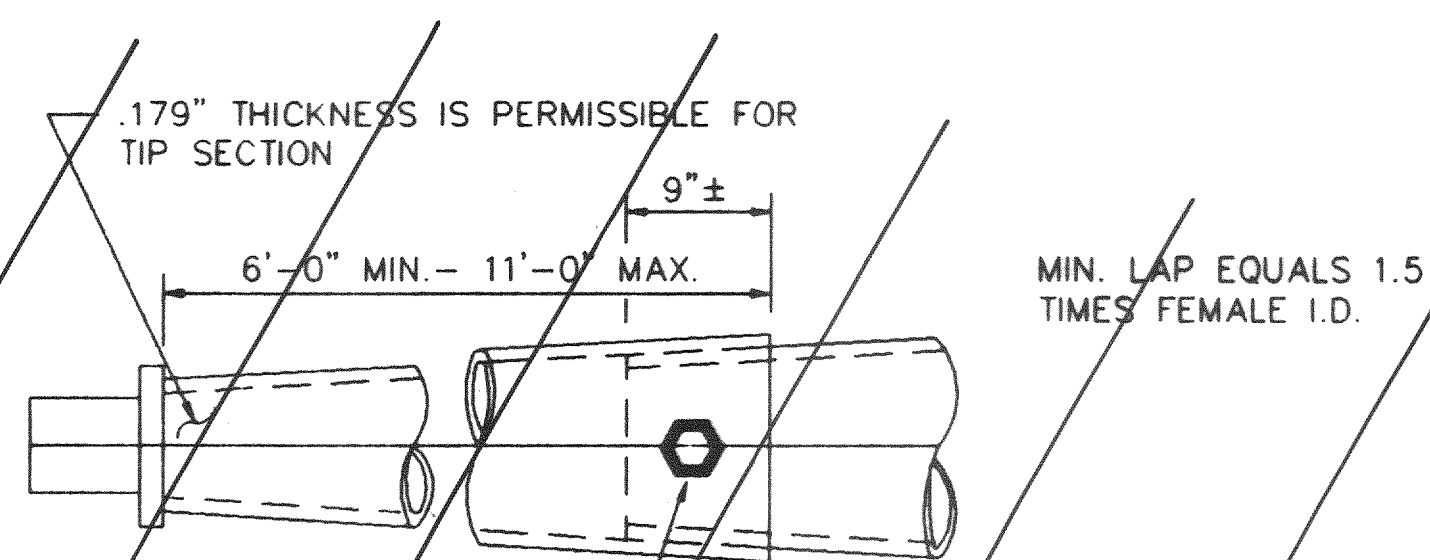


NOTE :

A SLIP JOINT IS PERMISSIBLE FOR ARMS 40' AND GREATER IN LENGTH. THE SLIP JOINT SHALL BE MADE IN THE SHOP, BUT MAY BE MATCH MARKED AND SHIPPED DISASSEMBLED.

4-3/4" HOLES AND 1-5/8" GALV. A307 BOLT. TACK WELD NUT TO THREAD PROJECTION AFTER MAKING JOINT. REPAIR DAMAGED GALVANIZING IN ACCORDANCE WITH THE SPECIFICATIONS.


SLIP JOINT DETAILS

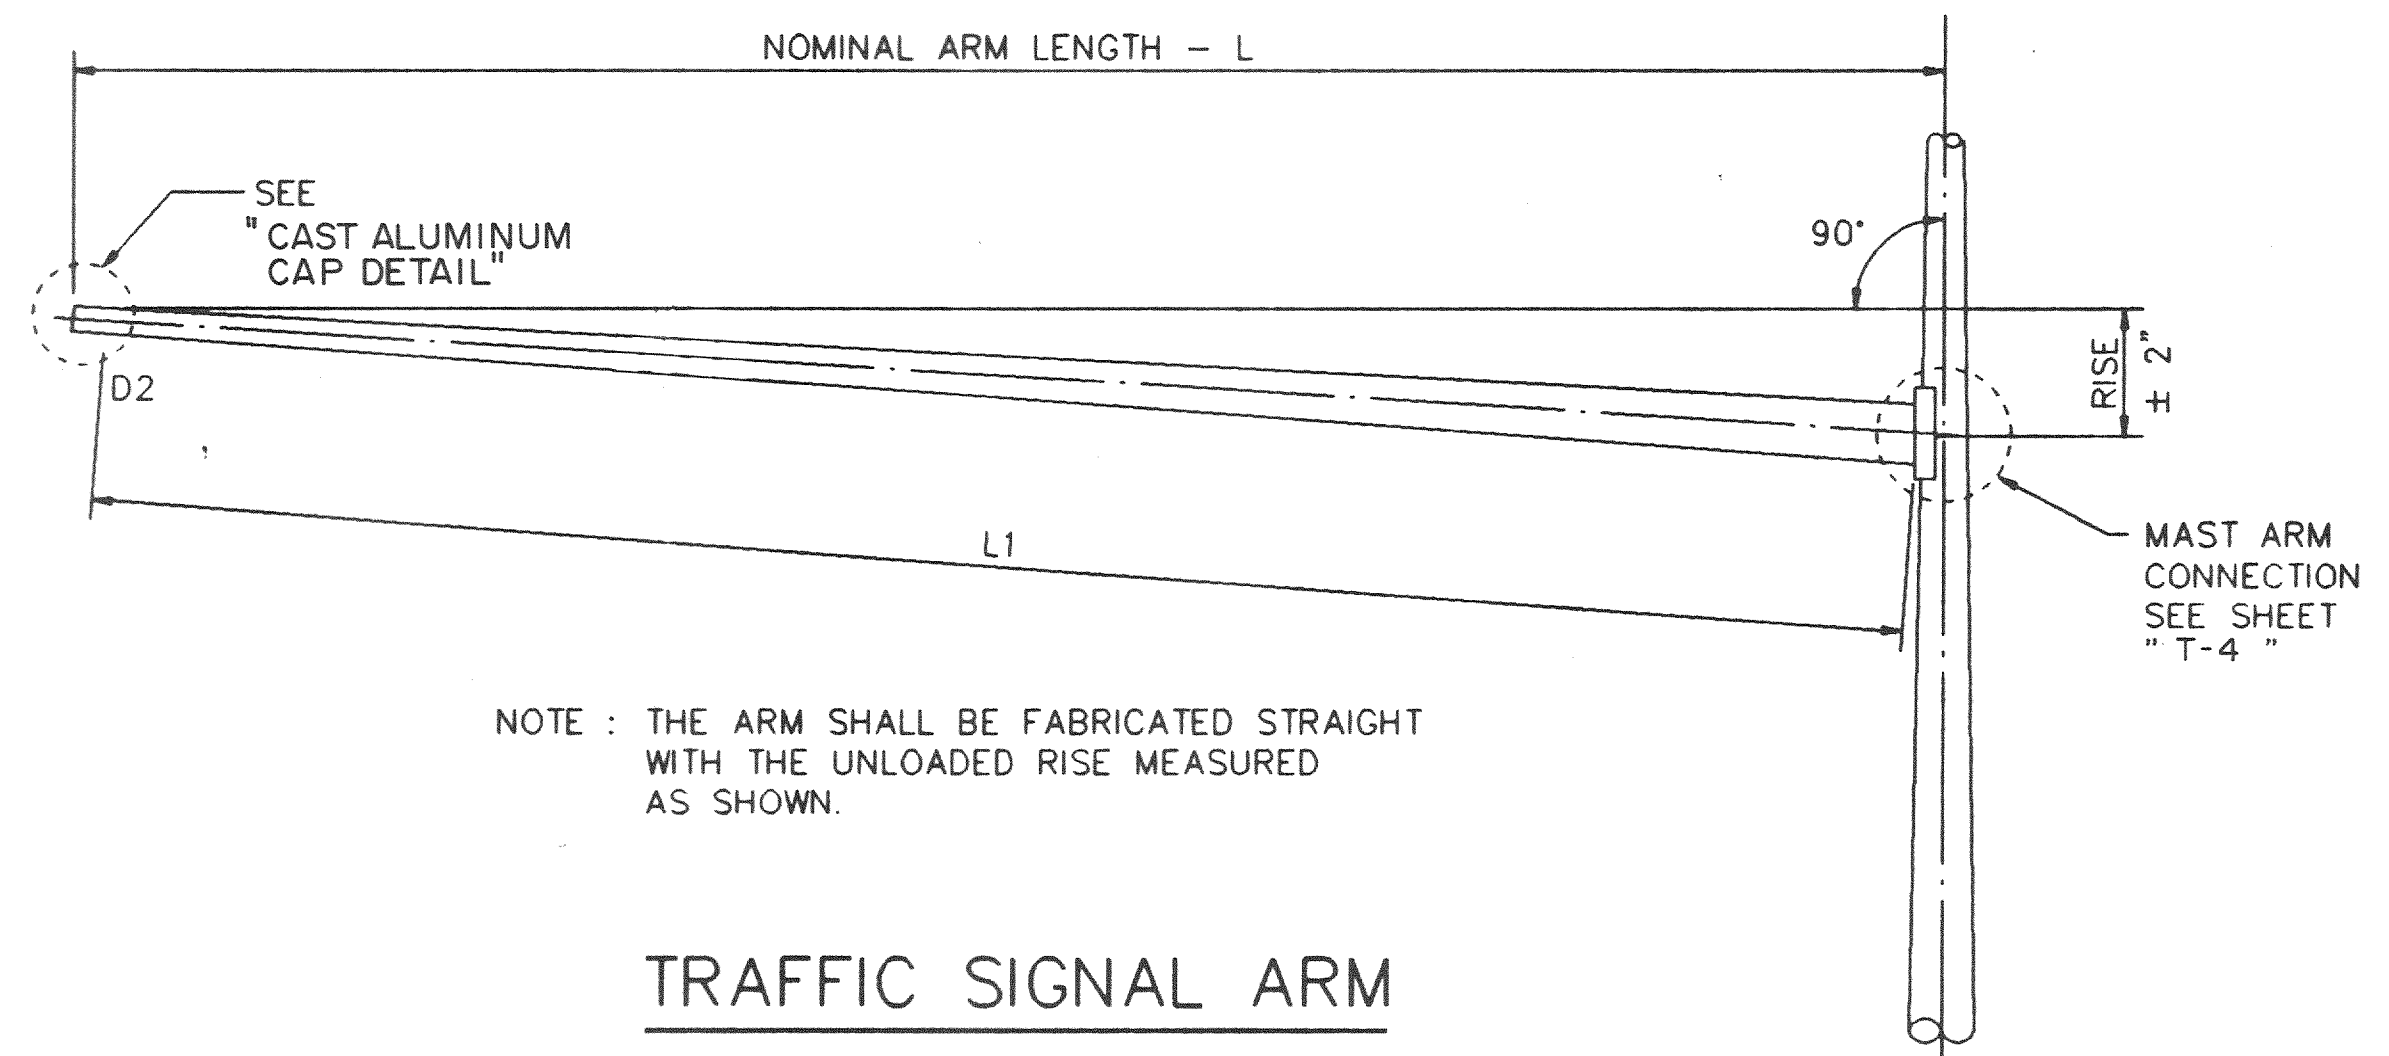

NOTE : THE ARM SHALL BE FABRICATED STRAIGHT WITH THE UNLOADED RISE MEASURED AS SHOWN.

TRAFFIC SIGNAL ARM

(FIXED MOUNT)

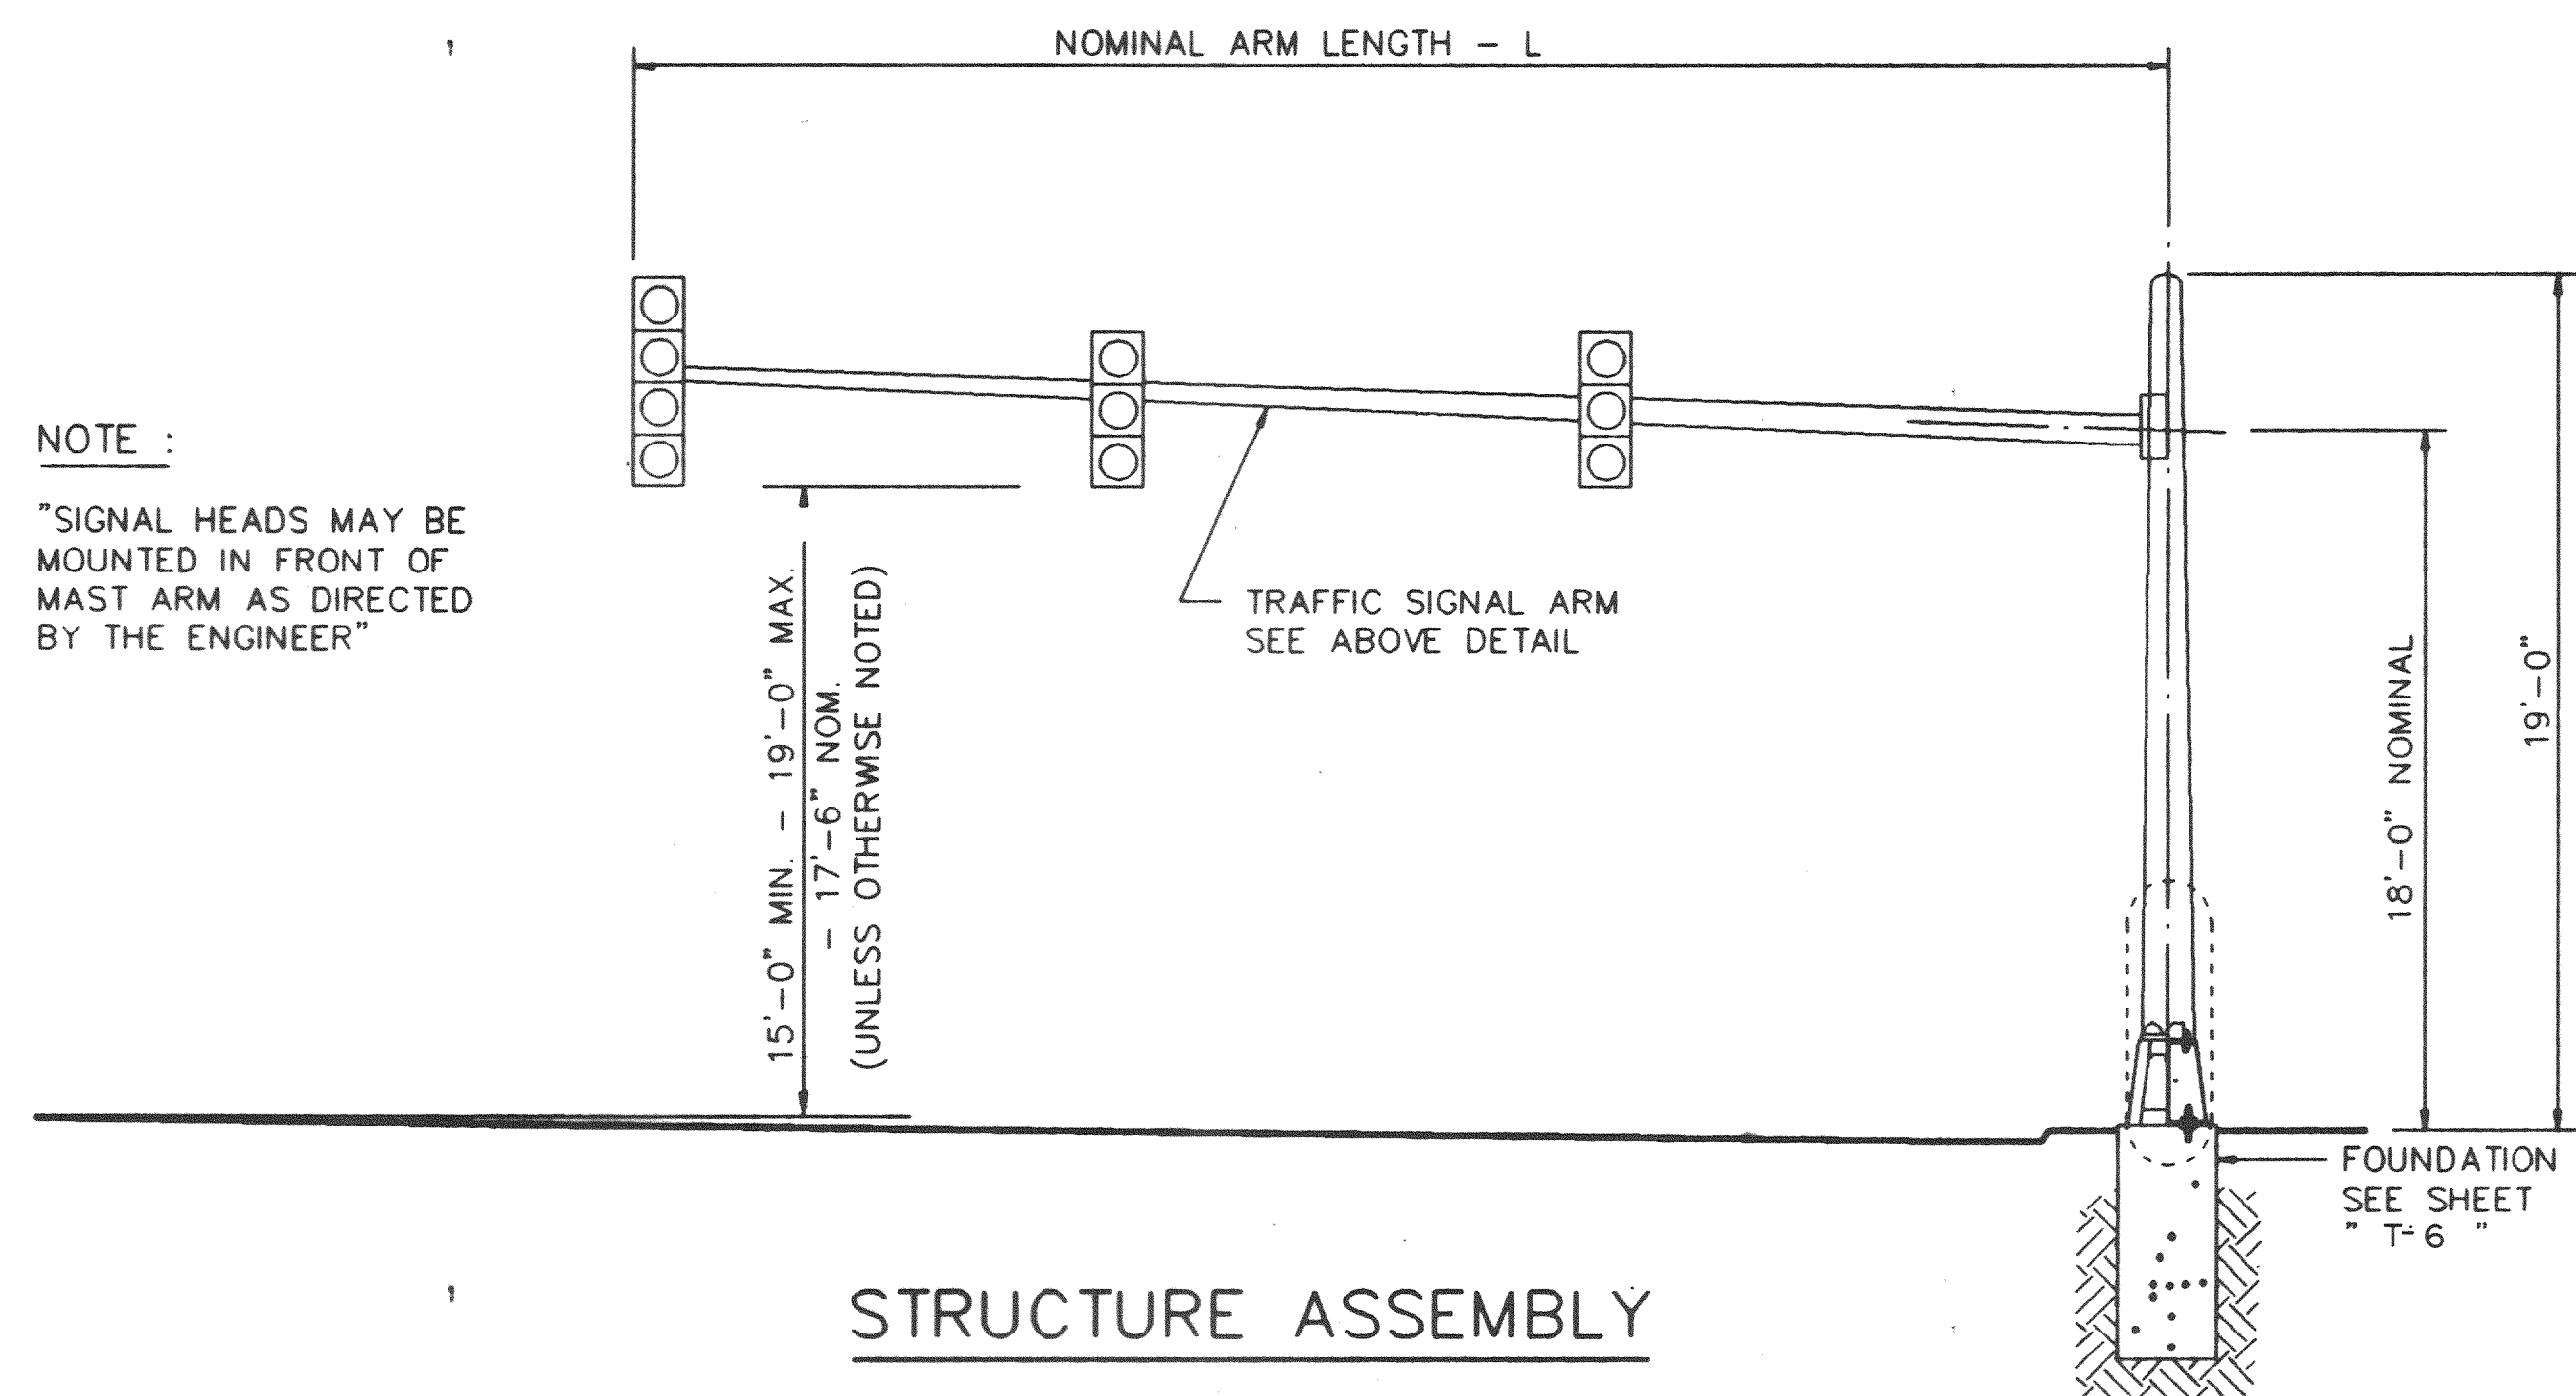

NOTE :

"SIGNAL HEADS MAY BE MOUNTED IN FRONT OF MAST ARM AS DIRECTED BY THE ENGINEER"

STRUCTURE ASSEMBLY

AS BUILTS

I CERTIFY THIS PROJECT WAS CONSTRUCTED IN GENERAL CONFORMANCE WITH THESE CONSTRUCTION PLANS AND WILL FUNCTION AS DESIGNED.

James A. Cates
01/16/93

John F. Miller
7-12-92

MAST ARM DETAILS						
BELTLINE RD. EAST OF MARSH LN.						
TOWN OF ADDISON, TEXAS						
LAWRENCE A. CATES & ASSOC. CONSULTING ENGINEERS DALLAS, TEXAS						
DESIGN	DRAWN	DATE	SCALE	NOTES	FILE	NO.
LAC	LAC	8/24/92	NT S		92023	T3