


GENERAL NOTES

1. All work shall conform to City of Addison Standard Specifications for Water & Sewer Construction.
2. All water lines to have 42 inch minimum cover as measured from top of pipe to existing ground or finished grade, whichever is greater or as needed to clear other utilities.
3. Water mains shall be Ductile Iron, Class 350, all sizes, with polyethylene wrap, or Cast Iron, Class 150, 8" or larger, with polyethylene wrap, or PVC, Class 150, DR 18 (C900), all sizes.
4. Contractor shall use PVC SDR 35 Sewer pipe. PVC pipe shall have a maximum deflection of 5%.
5. Contractor shall provide City with a barricade plan for utility work within street right-of-way.
6. Valves shall be resilient seat gate valves.
7. Trench excavation for trenches 5 feet or more in depth shall be in accordance with all provisions of Part 1926, Subpart P - Excavations, Trenching and shoring of the Occupational Safety and Health's Standards and Interpretations. It shall be the responsibility of the Contractor to conform to the above stated provisions and to supply Trench Safety Plans to the City.
8. The locations of all utilities indicated on the plans are taken from available public records. The exact location and depth of all utilities indicated must be determined by the Contractor. It shall be the duty of the Contractor to ascertain whether any additional facilities other than those shown on the plans may be present.
9. It shall be the responsibility of the Contractor to protect all existing utilities in the construction of this project. Any utilities damaged during the construction of this project shall be repaired at the Contractor's expense.
10. Work on Beltline Road per Town of Addison's ordinances & restrictions.
11. All water services shall have backflow devices installed between the meter and building.

RECORD DRAWING

WATER/SEWER PLAN
BURGER KING
CITY OF ADDISON, TX.

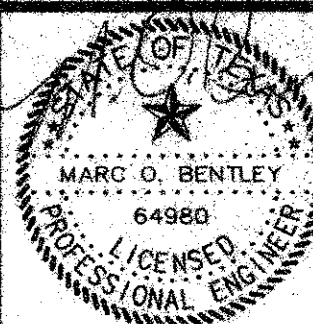

RECORD DRAWING

IMPROVEMENTS INDICATED ON THIS PLAN WHERE MADE IN ACCORDANCE WITH THE PROJECT PLANS & SPECIFICATIONS. THE DESIGN ENGINEER IS NOT AWARE OF ANY CHANGES TO THESE PLANS OTHER THAN THOSE SHOWN.
 DATE: JANUARY 5, 2000

BENCHMARK: "X" CUT ON CENTER OF CURB INLET WEST SIDE OF BUSINESS AVE. APPROXIMATELY 120 FEET NORTH OF BELTLINE RD.
 ELEV 578.52

Scale:	1"=20'
File Name:	BKADDSITE.DWG
Date:	7/19/99
Project No.:	99122
Designed:	B.E.I.
Drawn:	B.E.I.
Checked:	M.O.S.
SHEET	

C4

S:\PROJECTS\99122\BKADDSITE.dwg Mod Jan 05 15:23:41 2000