

PLAN
1" = 2'-0"

GENERAL NOTES


1. CONCRETE SHALL HAVE A MINIMUM COMPRESSIVE STRENGTH OF $f'c = 3000$ PSI AT 28 DAYS.
2. REINFORCING STEEL $F_y = 40$ KSI.
3. BAR LAPS SHALL BE 30" DIAMETERS.
4. EXPOSED EDGES AND CORNERS TO BE CHAMFERED $3/4"$.



AS-BUILTS
I CERTIFY THIS PROJECT WAS CONSTRUCTED IN GENERAL CONFORMANCE WITH THESE CONSTRUCTION PLANS AND WILL FUNCTION AS DESIGNED.

• DENOTES CONCRETE REMOVAL

REV. 6-10-93 Added 27" RCP To Junc. Box

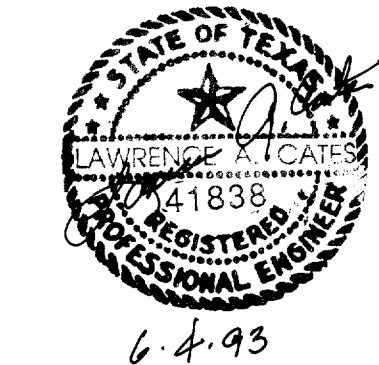

| | | | | | | |
|---------------------------------------|-------|--------|------------|-------|---------------------------------------|------|
| 84" RCP JUNCTION BOX DETAILS | | | | | | |
| KMART NO. 4885 | | | | | | |
| BELTLINE AND MARSH | | | | | | |
| ADDISON, TEXAS | | | | | | |
| LAWRENCE A. CATES & ASSOC. | | | | | CONSULTING ENGINEERS DALLAS, TEXAS | |
| DESIGN | DRAWN | DATE | SCALE | NOTES | FILE | NO. |
| LAC | LAC | 6-4-93 | 1" = 2'-0" | | 91012 | C-17 |