


AS SHOWN
 I CERTIFY THIS PROJECT WAS CONSTRUCTED IN GENERAL
 CONFORMANCE WITH THESE CONSTRUCTION PLANS AND WILL
 GUARANTEE AS SHOWN.

REV. 04.10.93 - 0.005% GRADE & LATERAL

BENCH MARK:
 N.W. CORNER OF EXISTING CURB INLET LOCATED ON
 SOUTH SIDE OF BELT LINE ROAD. INLET LOCATED
 575' WEST OF THE INTERSECTION OF BELT LINE
 ROAD AND BUSINESS AVENUE.
 ELEV. 573.06'

BENCHMARK:
 "□" CUT ON STORM SEWER INLET ON
 SOUTH SIDE OF BELT LINE ROAD 70'±
 WEST OF COMMERCIAL DRIVE.
 ELEV. 580.56'

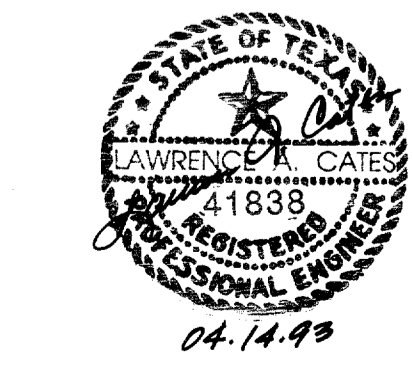

LINE A & LINE B					
SANITARY SEWER PROFILES					
ADDISON TOWN CENTER					
TOWN OF ADDISON, TEXAS					
LAWRENCE A. CATES & ASSOC. CONSULTING ENGINEERS DALLAS, TEXAS					
DESIGN	DRAWN	DATE	SCALE	NOTES	FILE NO.
LAC	LAC	04/07/93	H: 1"=40' V: 1"=6'	D.P.	91012
					C-9