


**"AS BUILT"**

This project was constructed in conformance to the Town of Addison Standards and Specifications, and functions as designed.

- LEGEND**
- F.I.P. = FOUND IRON PIPE
  - F.I.R. = FOUND IRON ROD
  - FND "X" = FOUND SCRIBED X
  - S.I.R. = SET IRON ROD
  - ⊙ = FIRE HYDRANT
  - ⊕ = GAS MANHOLE
  - ⊕ = LIGHT POLE
  - ⊕ = ELECTRIC BOX
  - ⊕ = POWER POLE
  - ⊕ = STORM SEWER MANHOLE
  - ⊕ = SANITARY SEWER CLEANOUT
  - ⊕ = SANITARY SEWER MANHOLE
  - ⊕ = WATER METER
  - ⊕ = WATER VALVE
  - ⊕ = TRAFFIC BOX
  - ⊕ = TRAFFIC LIGHT
  - ⊕ = TELEPHONE PEDISTAL
  - ⊕ = SIGN
  - ⊕ = FENCE

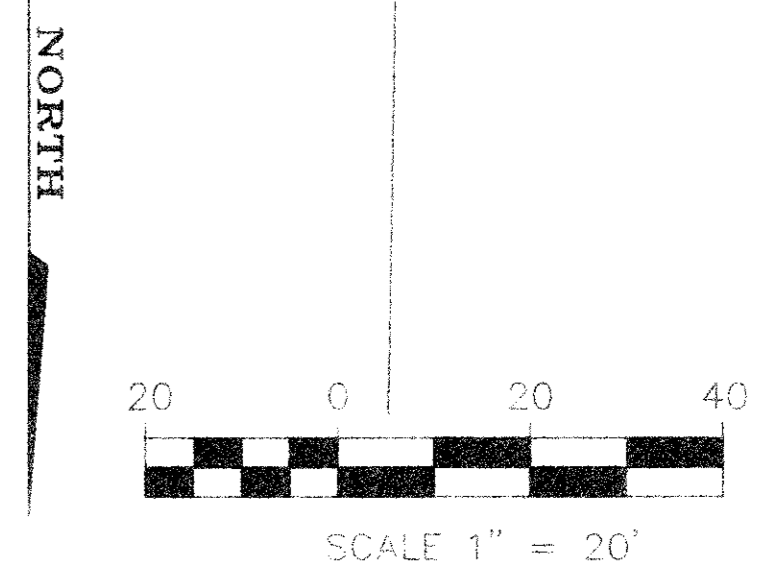

NO.	DATE	REVISION	BY
1	8/27/96	LOCATED MONUMENT SIGN IN PARKING LOT	MNP

**GRADING PLAN**  
**VELADI RANCH STEAKHOUSE**  
 BELTLINE ROAD AT COMMERCIAL  
 ADDISON, TEXAS

**MPP** MICHAEL PEEPLES  
 Engineers and Planners  
 4660 Sunbelt  
 Dallas, Texas 75248  
 (214) 248-1968

DATE: 07/25/96 DRAWN BY: MNP  
 DRAWING NAME: ADDISON SCALE 1" = 20'

CE-1