
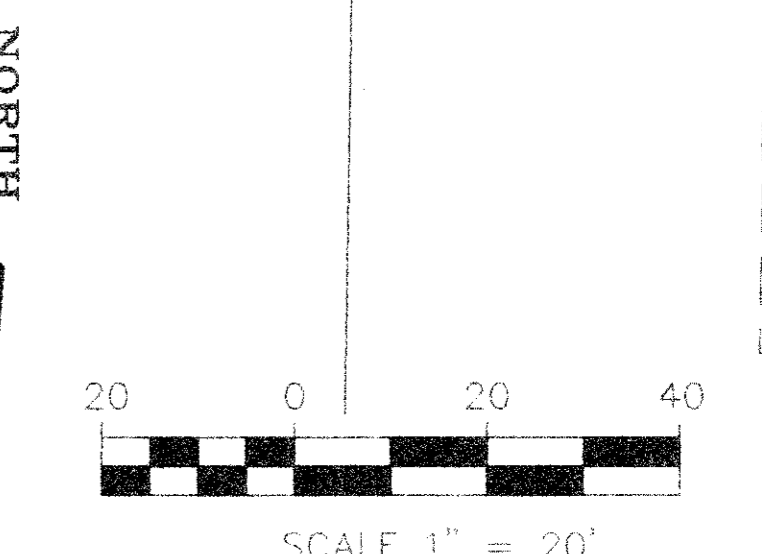
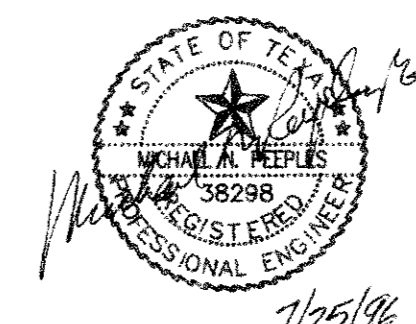
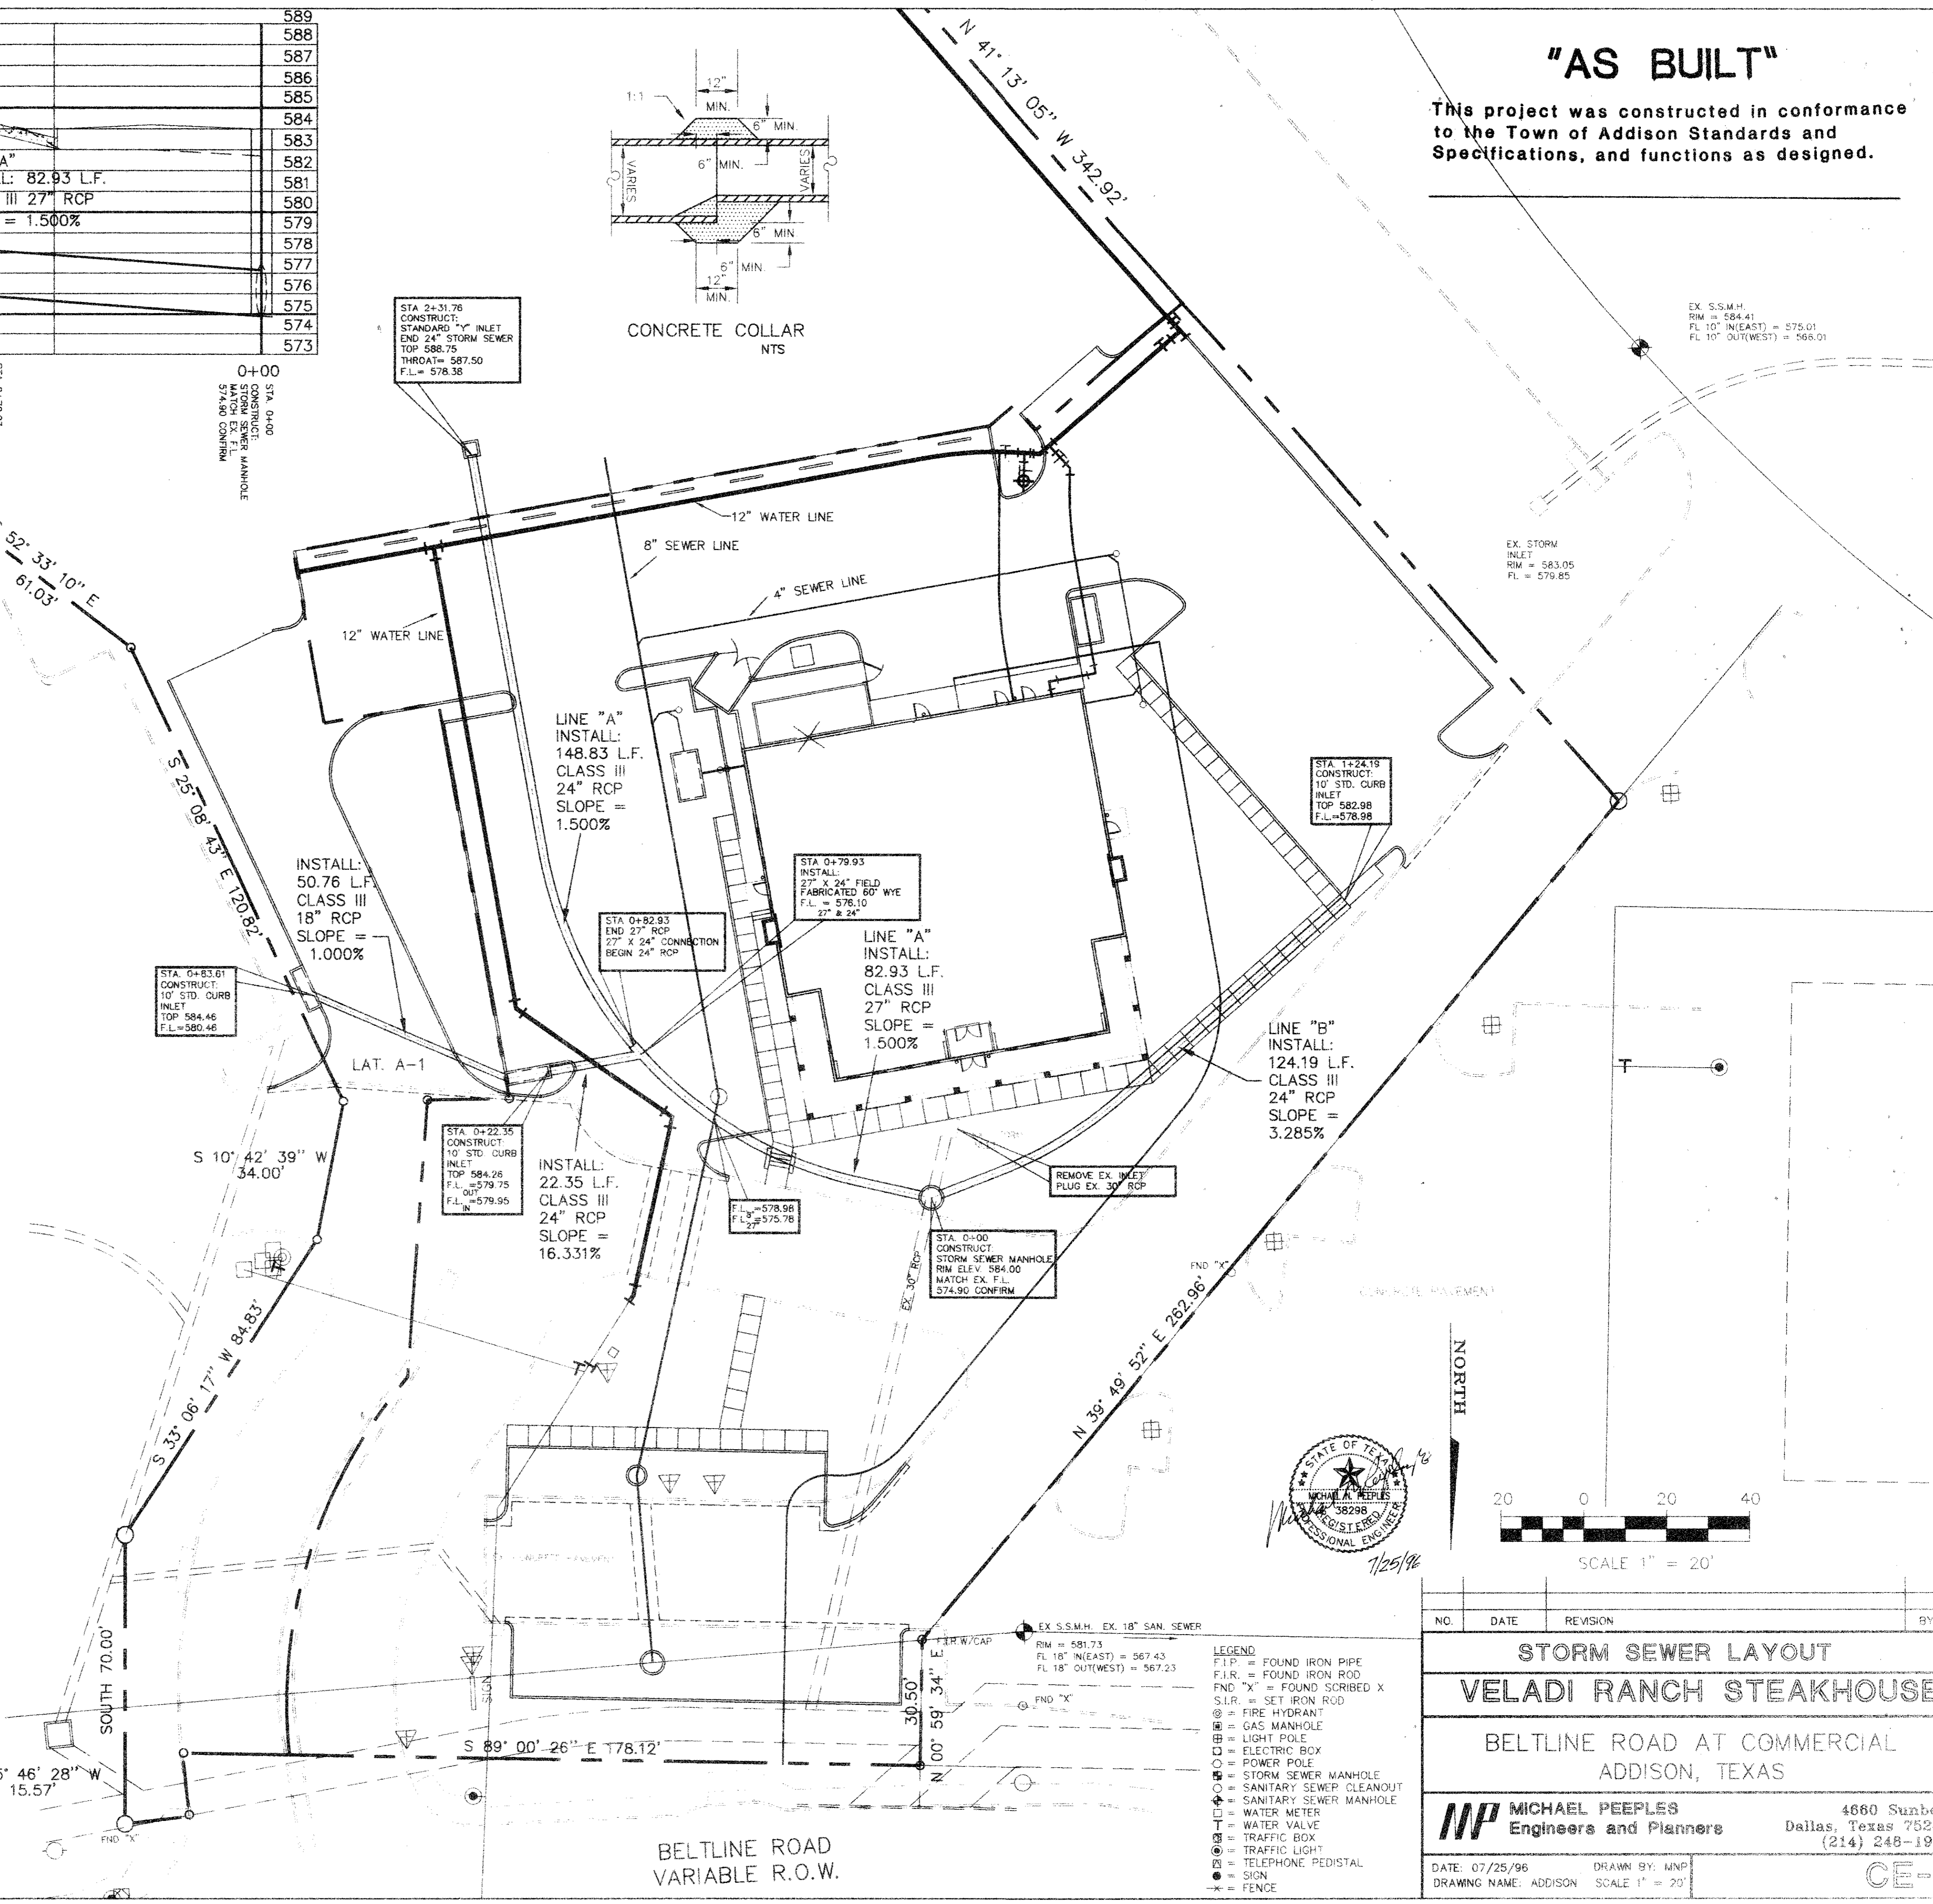
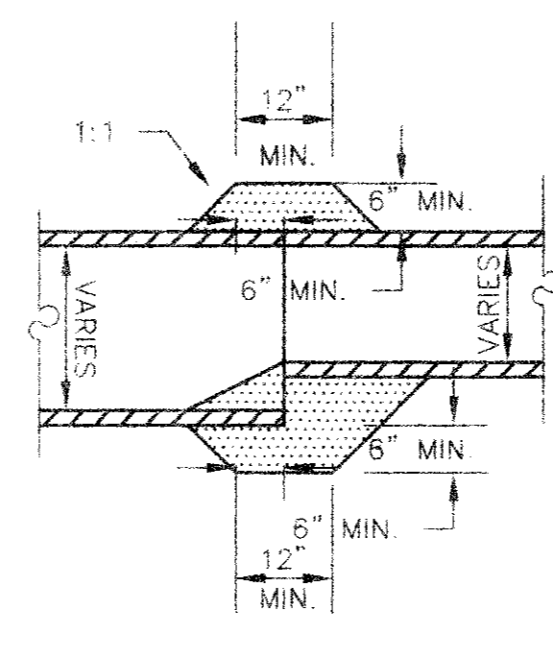
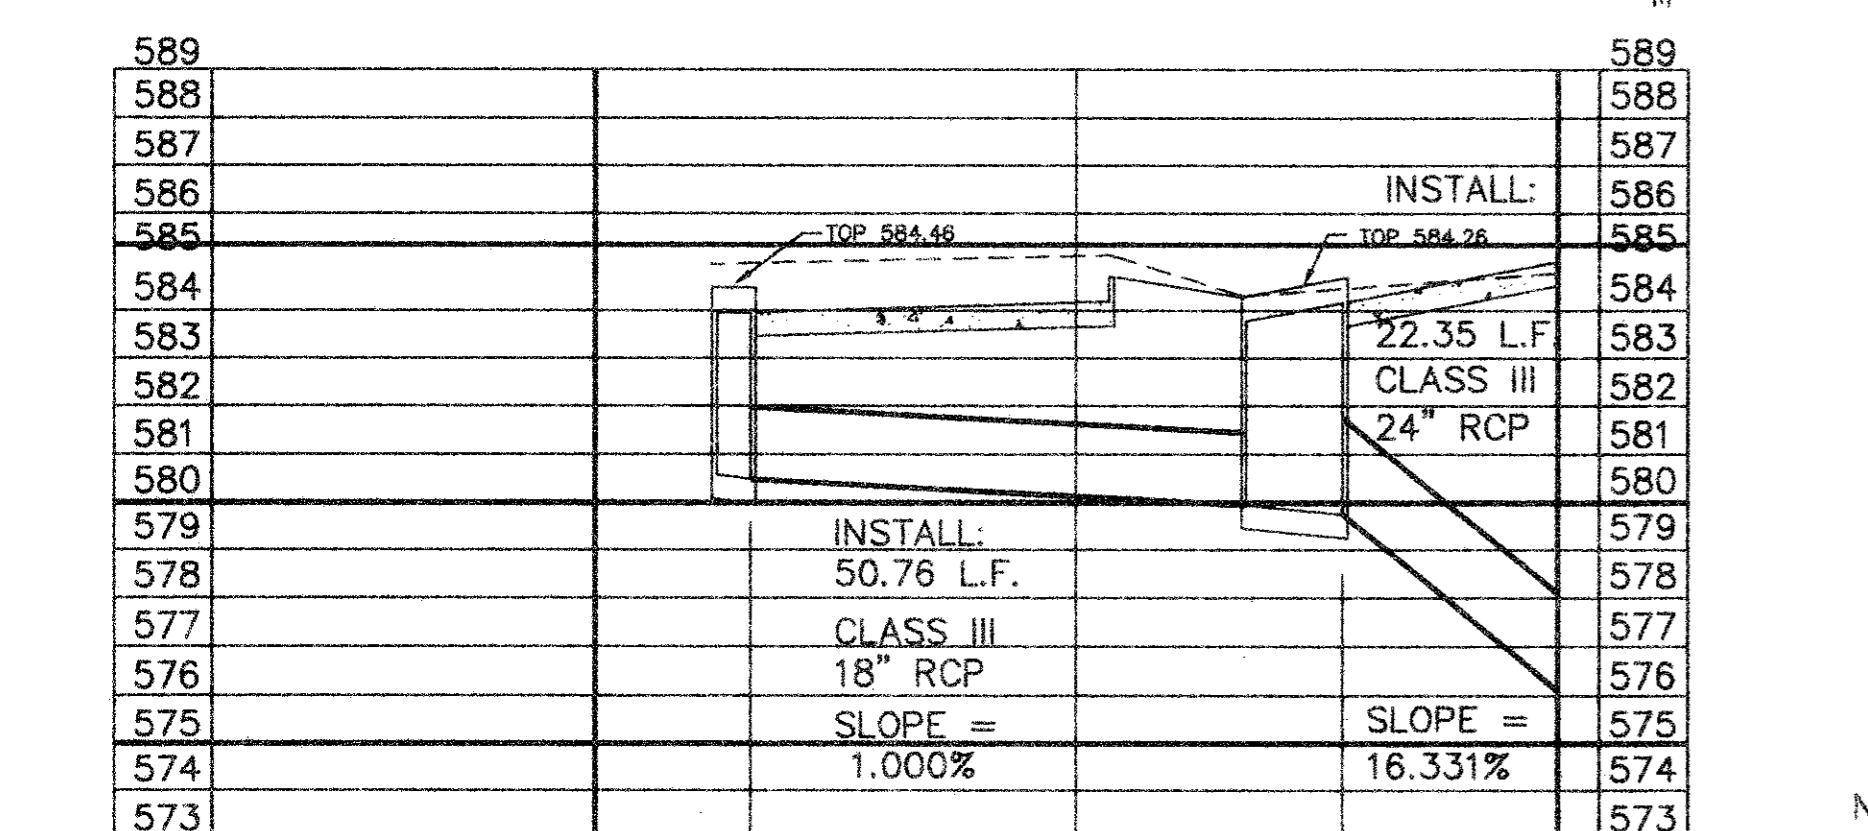
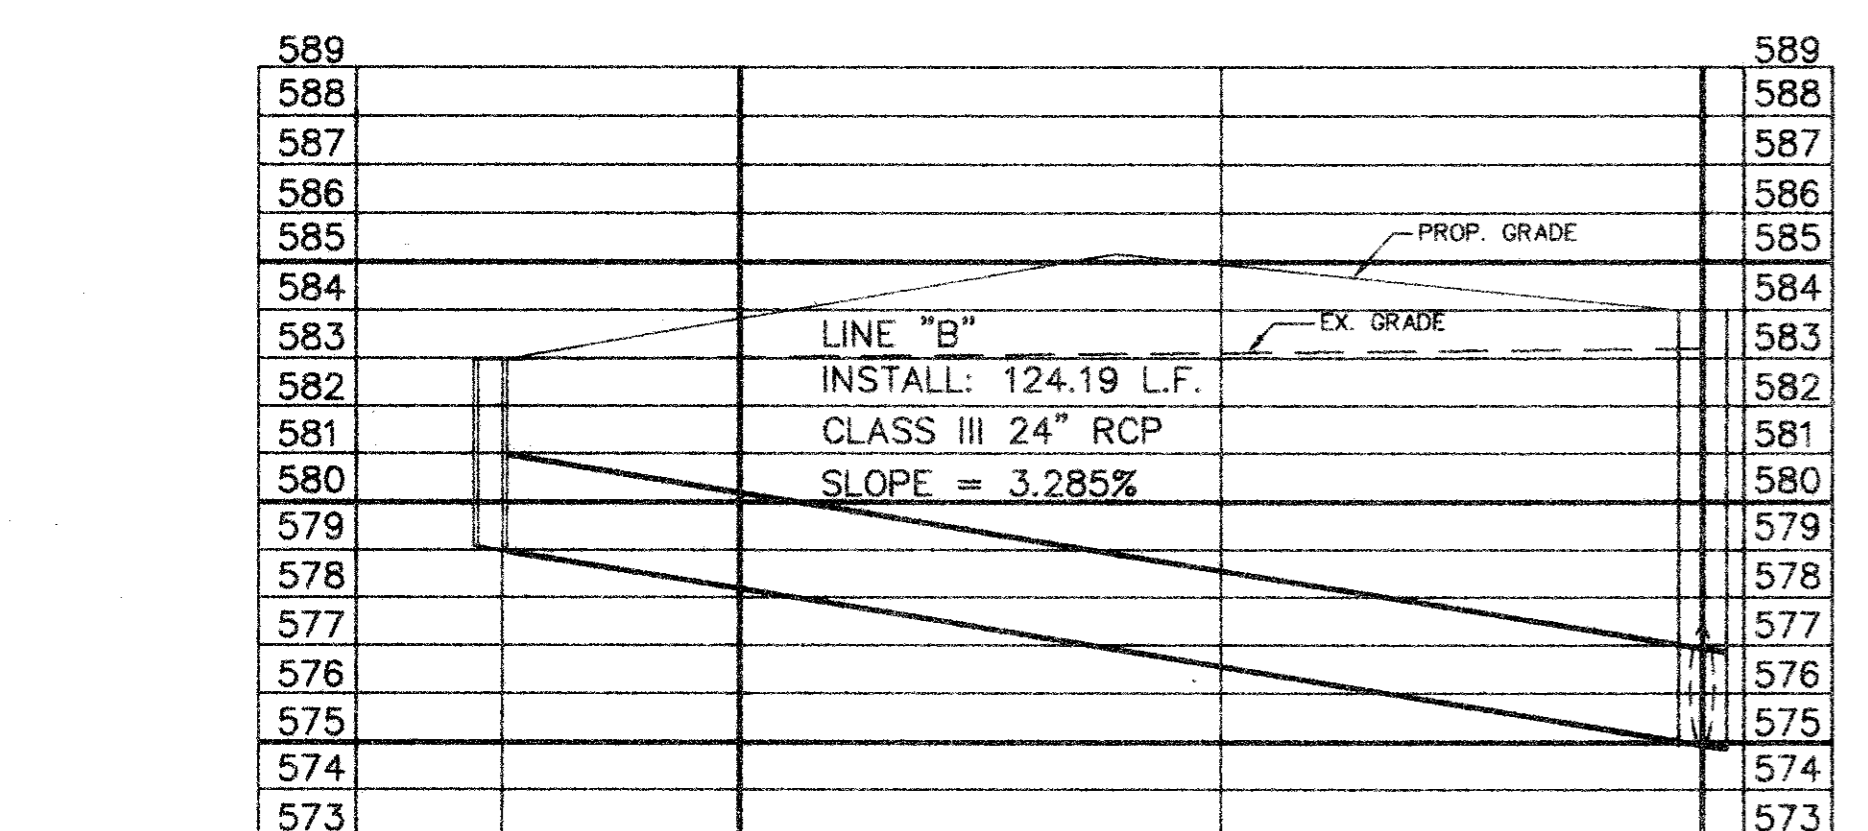


"AS BUILT"

This project was constructed in conformance to the Town of Addison Standards and Specifications, and functions as designed.

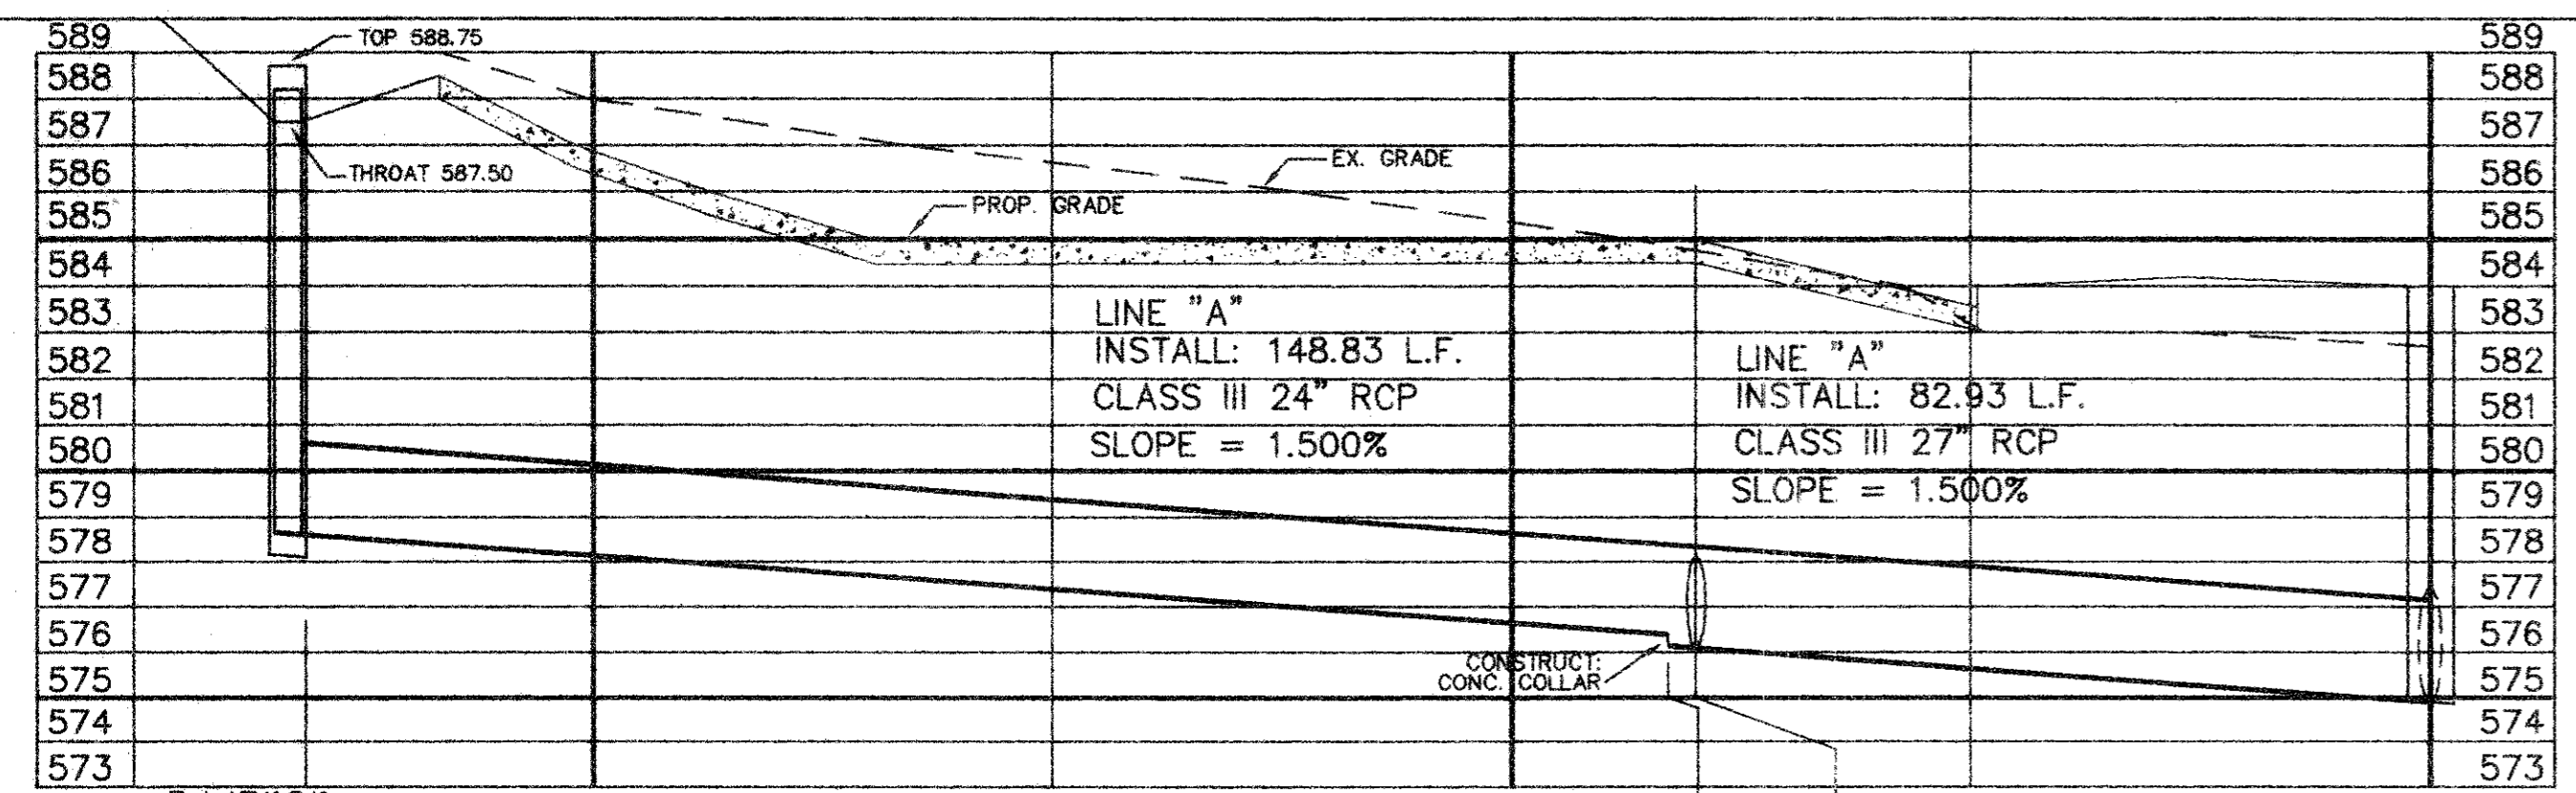

NO.	DATE	REVISION	BY
STORM SEWER LAYOUT			
VELADI RANCH STEAKHOUSE			
BELTLINE ROAD AT COMMERCIAL ADDISON, TEXAS			
MP MICHAEL PEEPLES Engineers and Planners		4660 Sunbelt Dallas, Texas 75248 (214) 248-1968	
DATE: 07/25/96		DRAWN BY: MNP	
DRAWING NAME: ADDISON		SCALE 1" = 20'	