



**INTEGRAL CONCRETE CURB**

N.T.S.

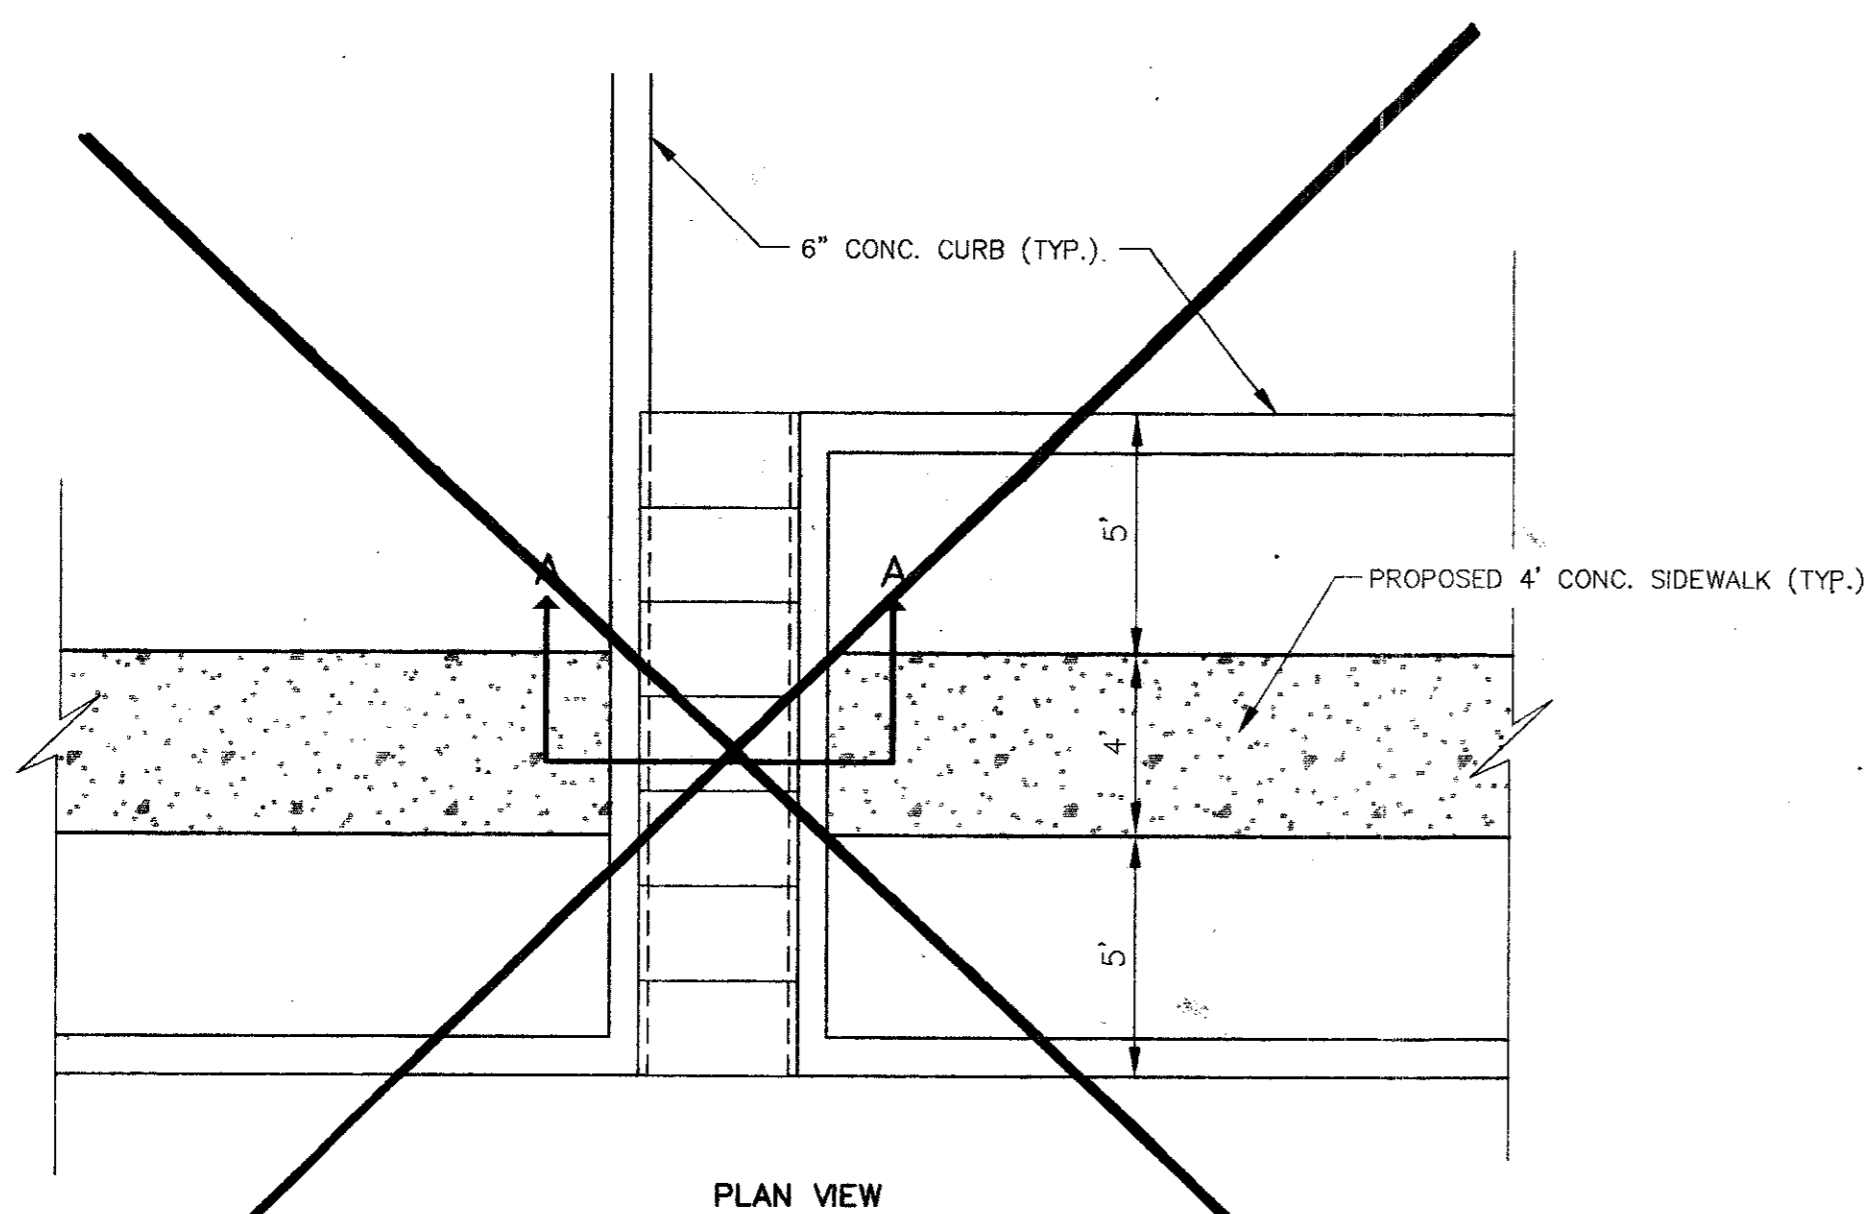


PLAN VIEW

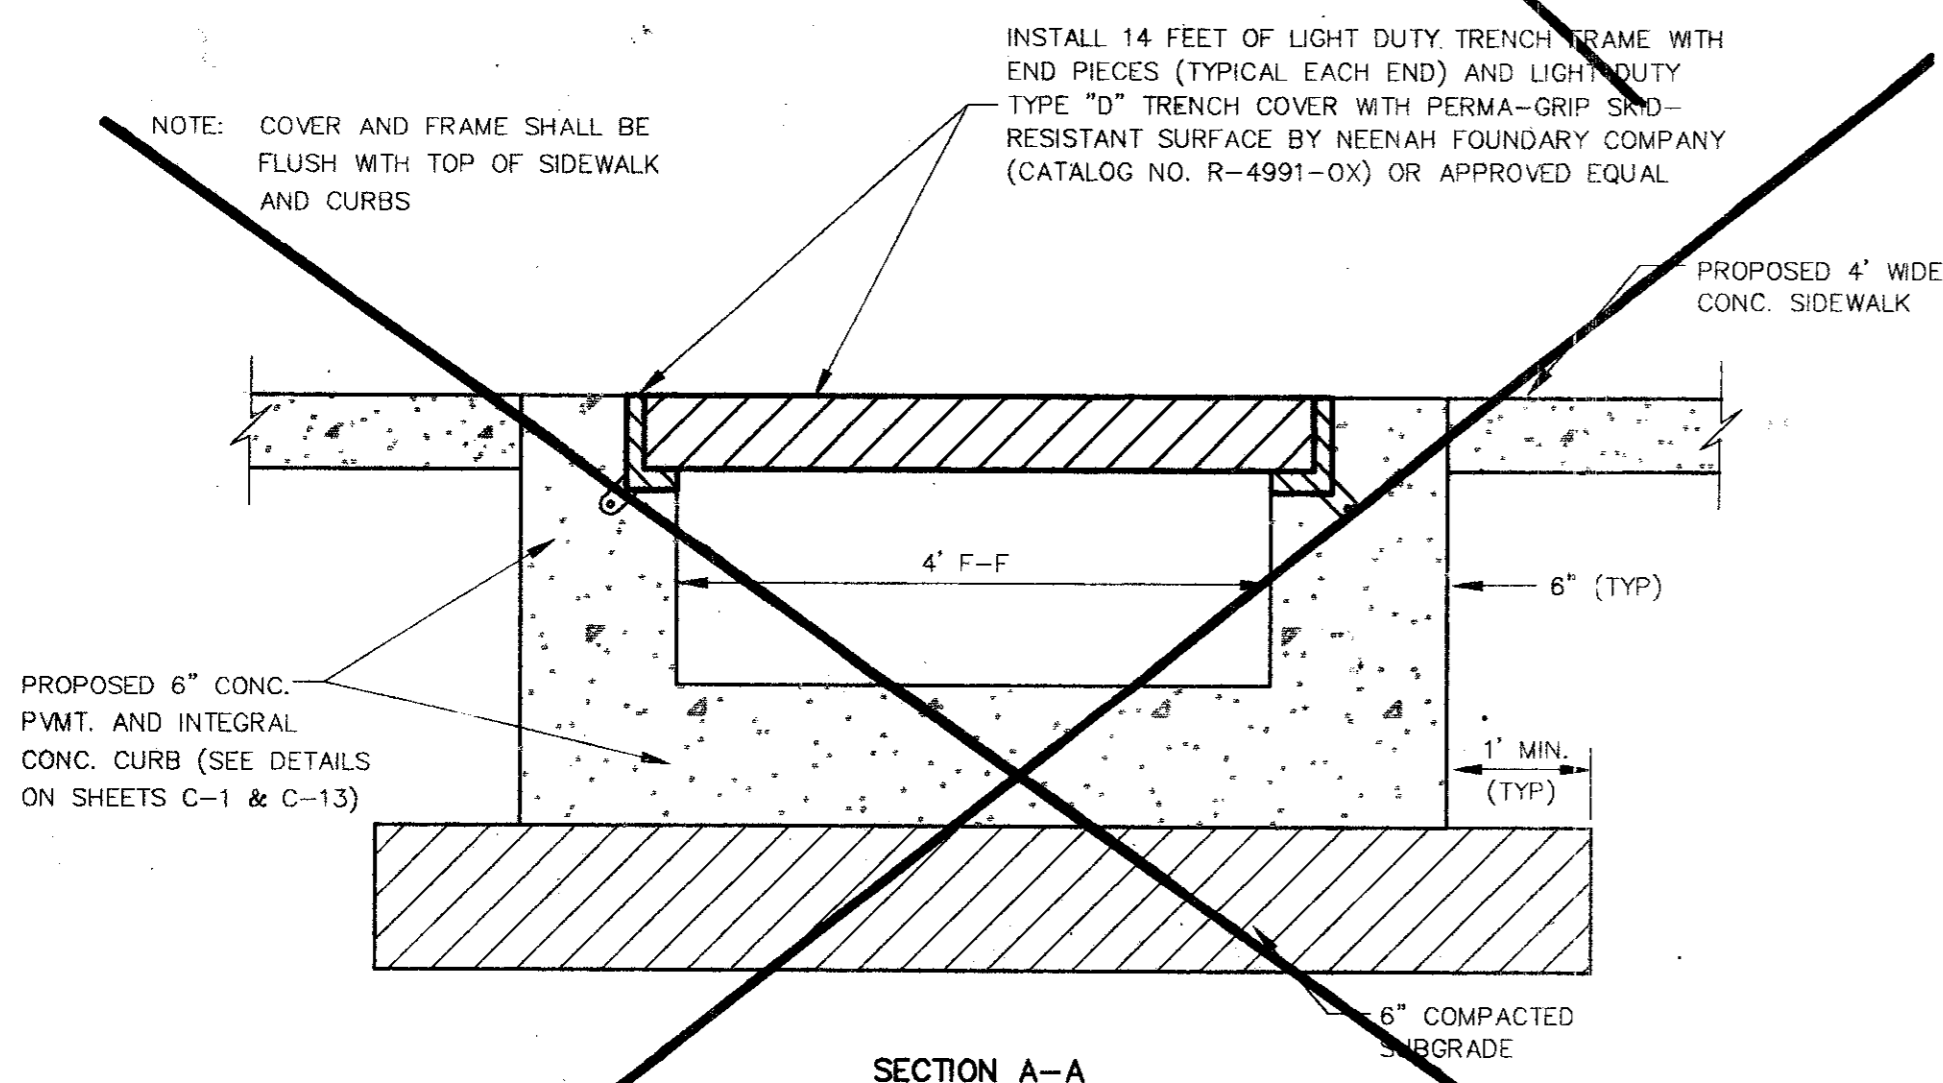


**CONCRETE FLUME DETAIL**

N.T.S.

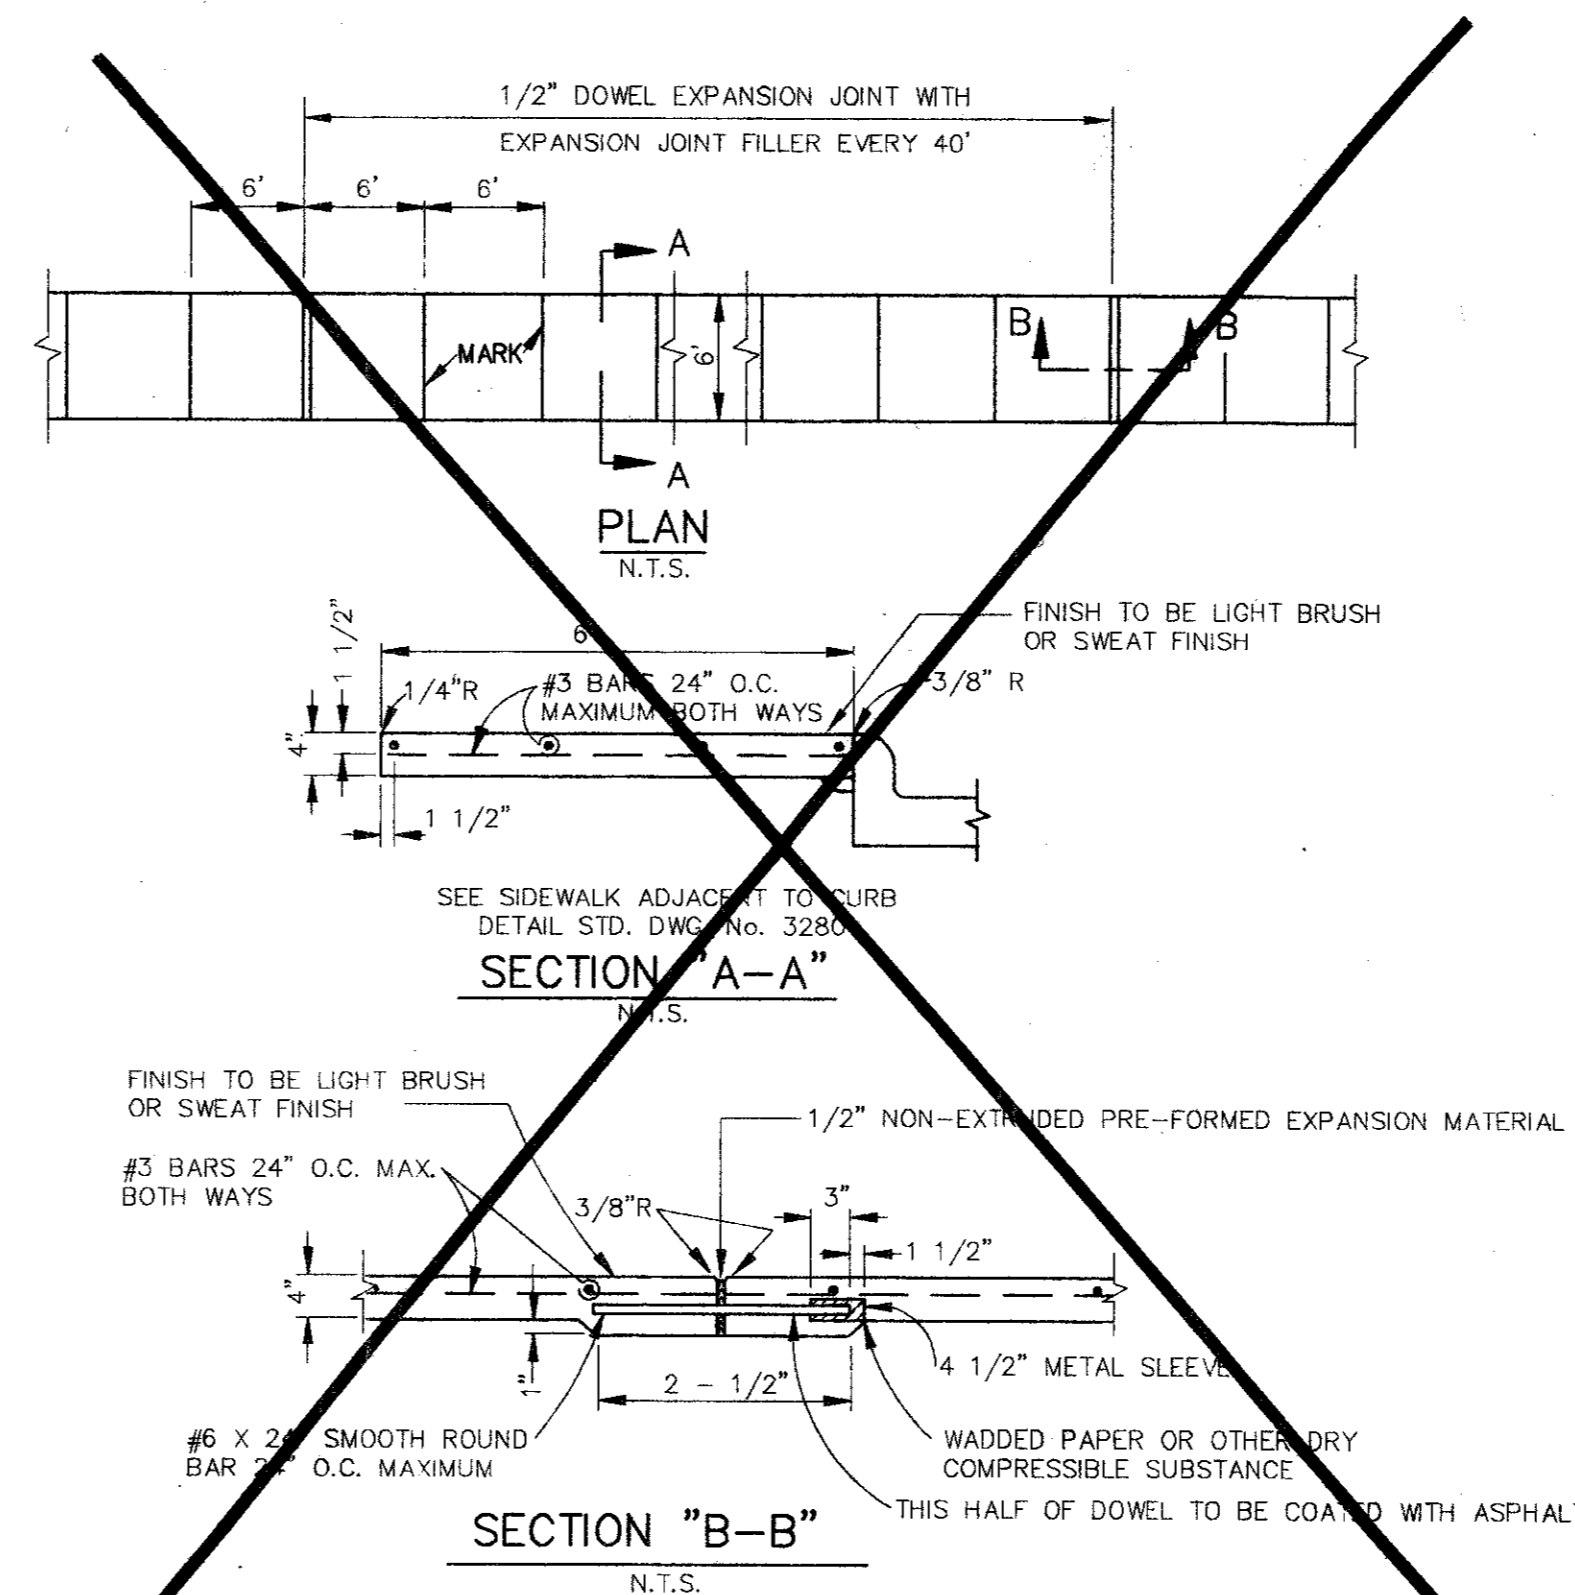

**CONCRETE SIDEWALK**

N.T.S.

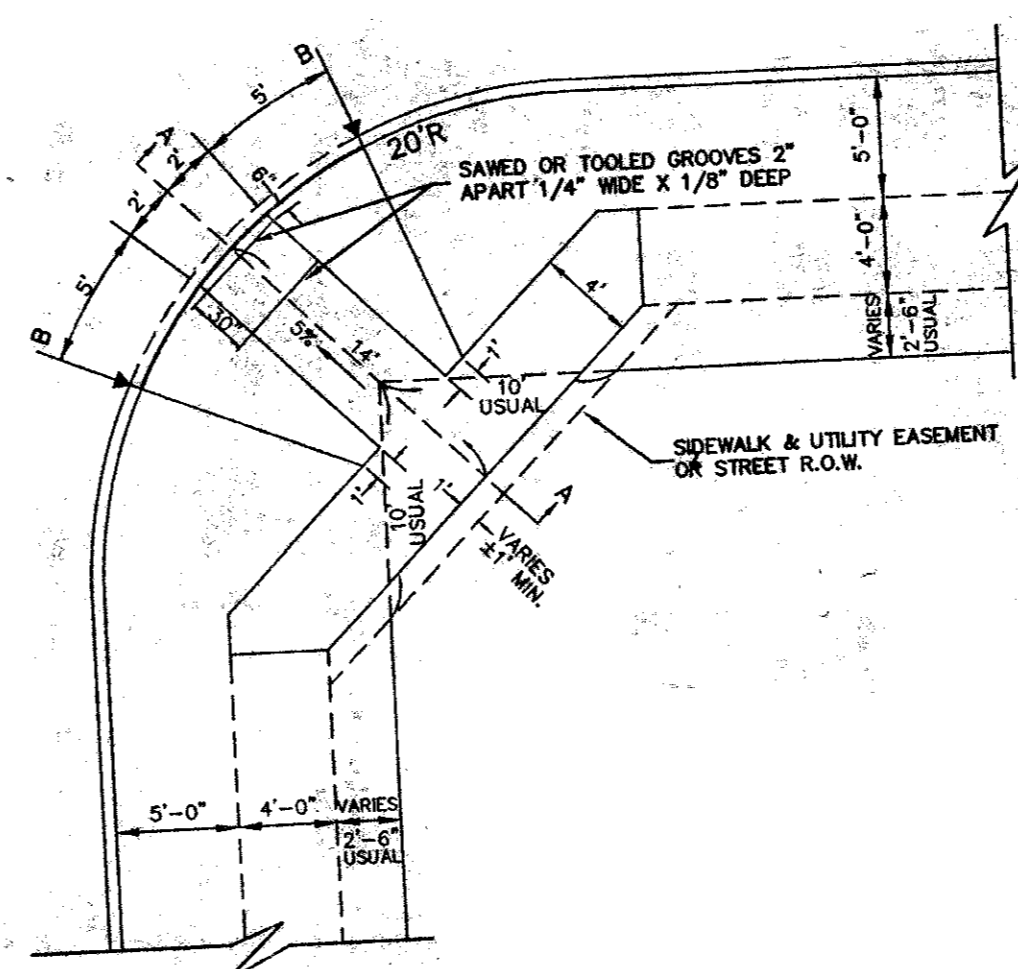

**BARRIER FREE RAMP**

N.T.S.

APPROVAL	
REVISION	
DATE	
No.	

**Winkelmann & Associates, Inc.**  
 CONSULTING CIVIL ENGINEERS & SURVEYORS  
 63200  
 28 EXECUTIVE PARK, SUITE 200  
 IRVINE, TEXAS 75038  
 (409) 442-7000 FAX

T.L. CHENOWETH SURVEY, ABSTRACT NO. 273  
 WILKENS SURVEY, ABSTRACT NO. 923  
 CITY OF ADDISON, DALLAS COUNTY, TEXAS  
 OWNER:  
 RED ROBIN RESTAURANT INTERNATIONAL  
 28 EXECUTIVE PARK, SUITE 200  
 IRVINE, CA 92714

**CIVIL DETAILS**  
**BLOCK 3, BELTLINE MARSH BUSINESS PARK**  
**ADDISON, TEXAS**

Scale : 1" = 30'  
 Date : 1/3/95  
 Designed By : TL  
 Drawn By : TL  
 Checked By : MC  
 File : 0930IDET  
 Project No. : 09301.01

**AS BUILT**  
 Winkelmann & Associates, Inc. hereby certifies that this plan, to the best of our knowledge is "As Built." All modifications from the originally approved construction documents have been made as per information provided by the contractor. Winkelmann & Associates, Inc. does not certify as to the correctness or quality of construction as no field inspection was performed.  
 Winkelman & Associates, Inc. DATE 7-10-95

SHEET  
 8  
 9