


Architect

6-8-79
JOB NO. 5
DATE
DRAWN BY: JFG
OF

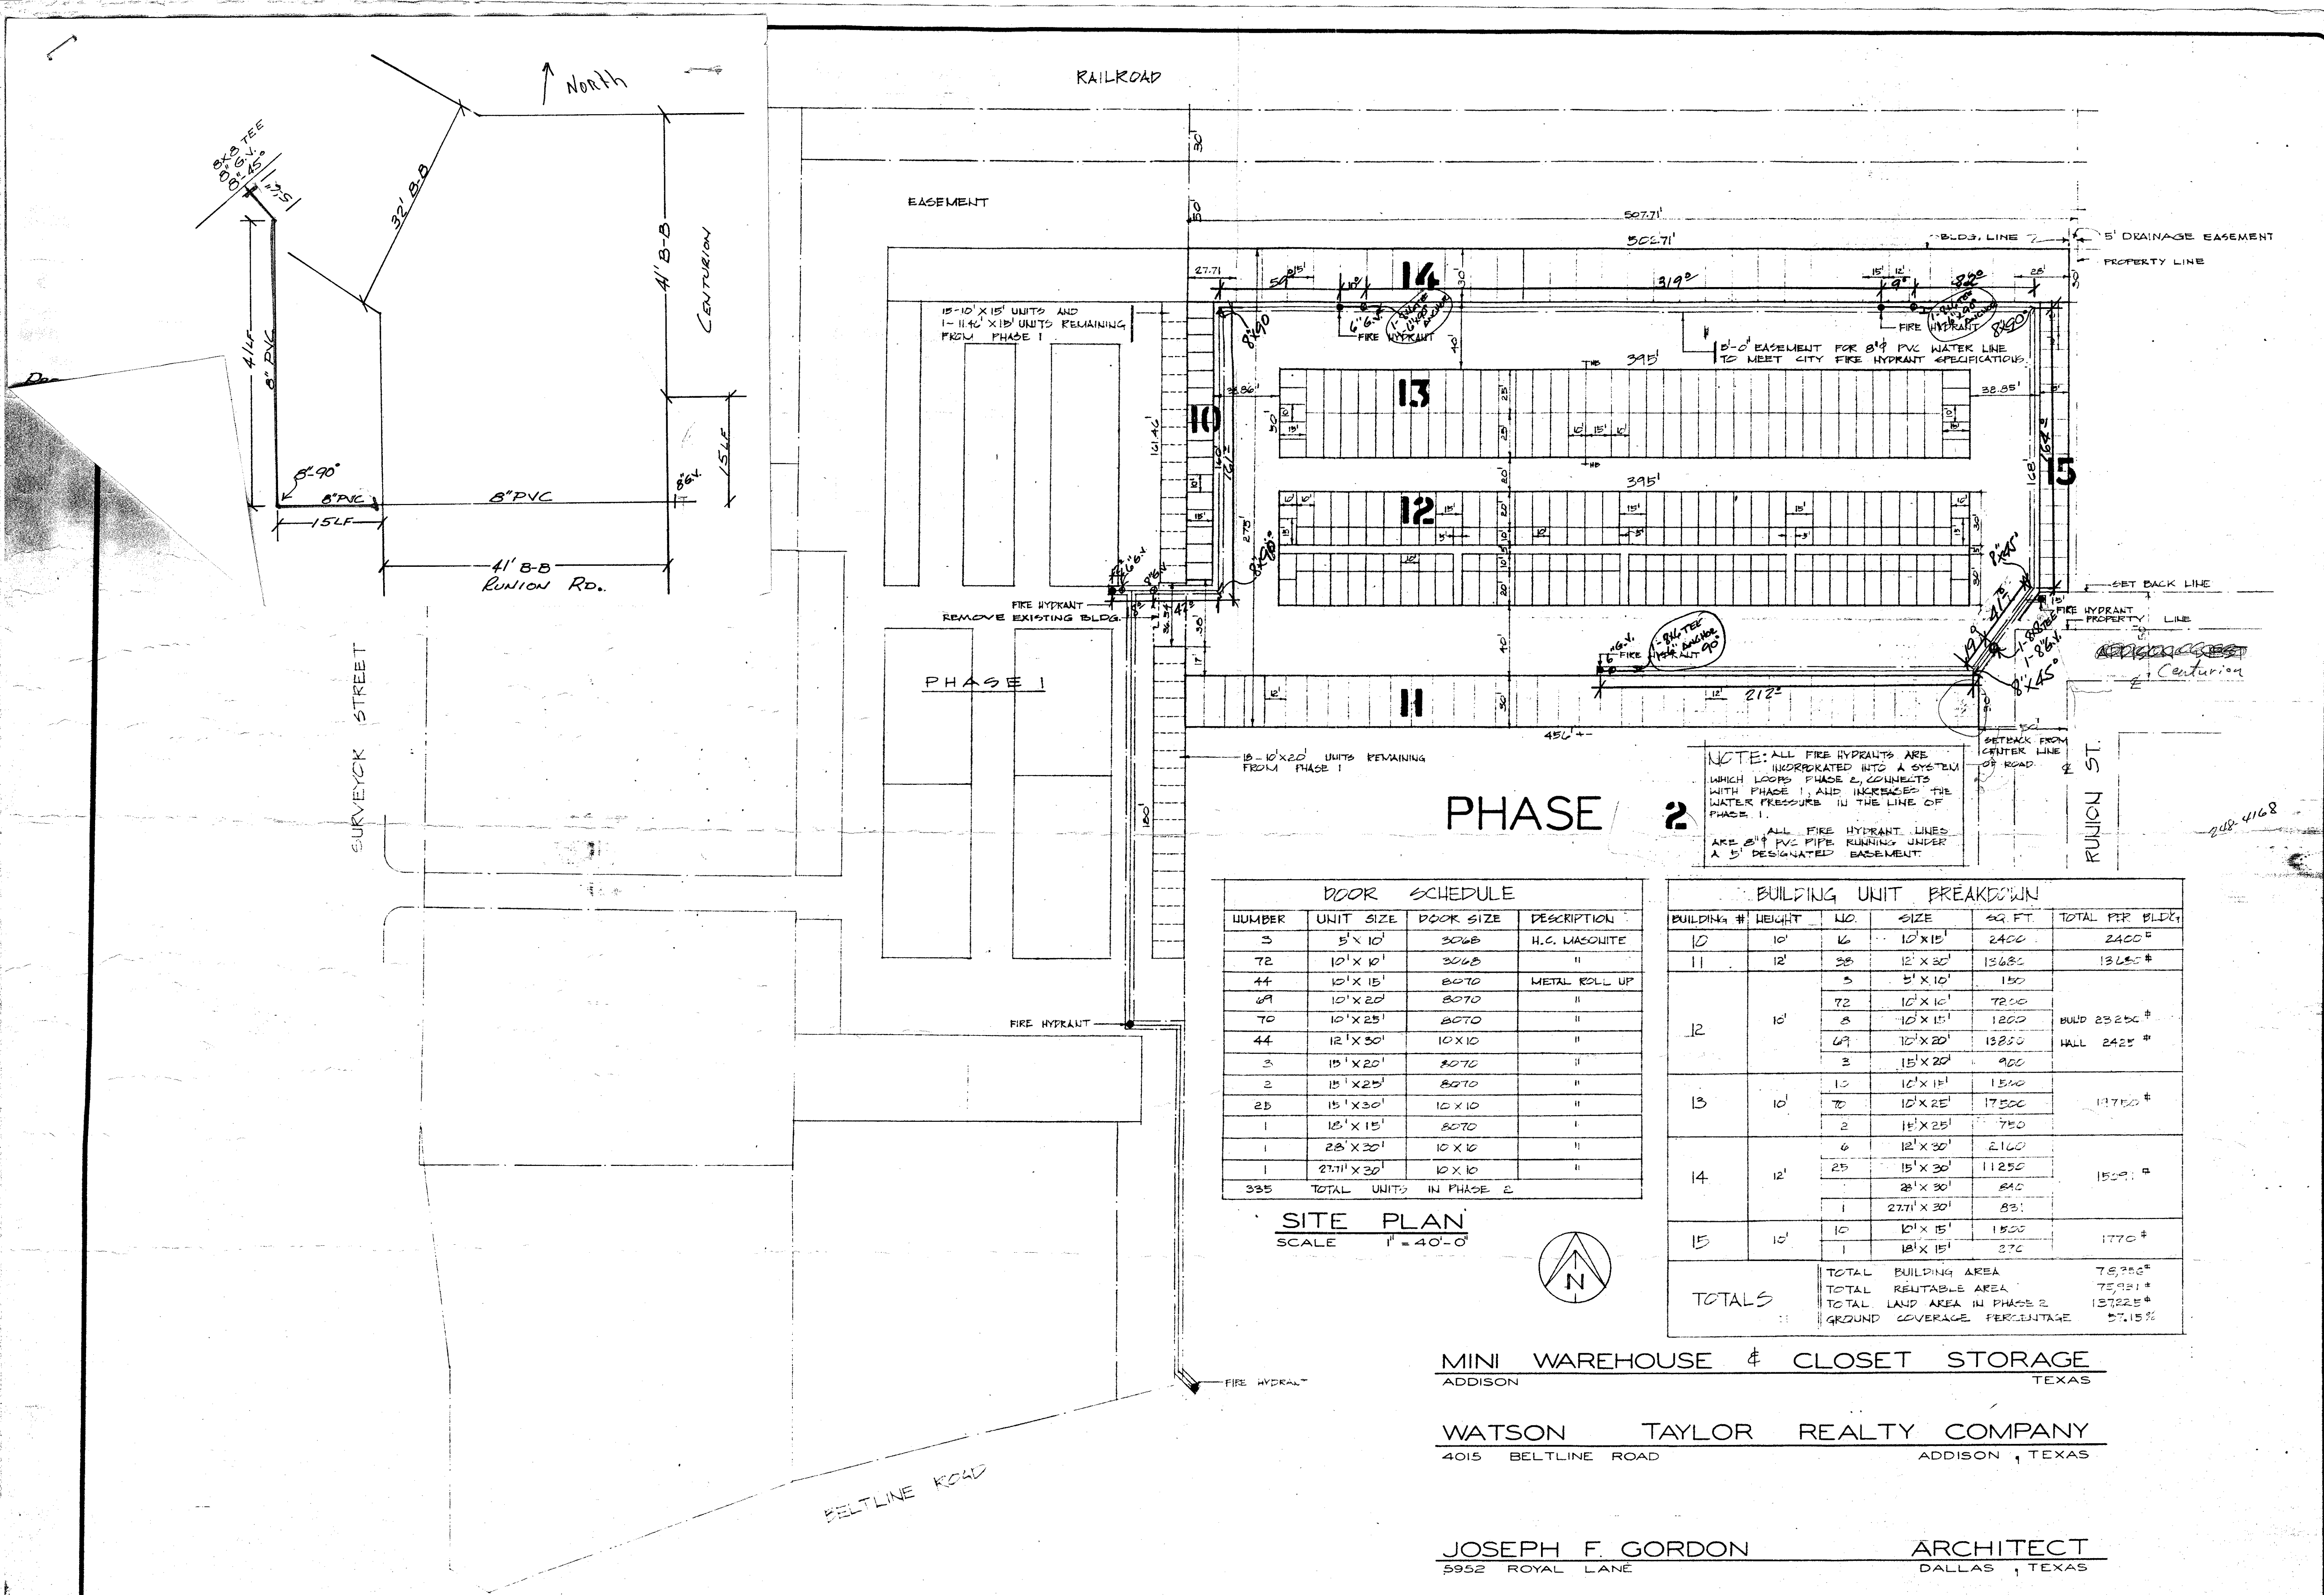

NOTE: ALL FIRE HYDRANTS ARE INCORPORATED INTO A SYSTEM WHICH LOOPS PHASE 2, CONNECTS WITH PHASE 1, AND INCREASES THE WATER PRESSURE IN THE LINE OF PHASE 1.

ALL FIRE HYDRANT LINES ARE 8" PVC PIPE RUNNING UNDER A 5' DESIGNATED BASEMENT.

DOOR SCHEDULE			
NUMBER	UNIT SIZE	DOOR SIZE	DESCRIPTION
3	5' X 10'	3068	H.C. LASONITE
72	10' X 10'	3068	"
44	10' X 15'	8070	METAL ROLL UP
69	10' X 20'	8070	"
70	10' X 25'	8070	"
44	12' X 30'	10 X 10	"
3	15' X 20'	8070	"
2	15' X 25'	8070	"
25	15' X 30'	10 X 10	"
1	18' X 15'	8070	"
1	28' X 30'	10 X 10	"
1	27'11" X 30'	10 X 10	"
335 TOTAL UNITS IN PHASE 2			

BUILDING UNIT BREAKDOWN					
BUILDING #	HEIGHT	NO.	SIZE	SQ. FT.	TOTAL PER BLDG.
10	10'	16	10' X 15'	2400	2400 #
11	12'	38	12' X 30'	13680	13680 #
12	10'	5	5' X 10'	150	BUILD 23250 # HALL 2425 #
		72	10' X 10'	7200	
		8	10' X 15'	1800	
		69	10' X 20'	13800	
13	10'	3	15' X 20'	900	14750 #
		10	10' X 15'	1500	
		70	10' X 25'	17500	
14	12'	2	15' X 25'	750	1509 #
		6	12' X 30'	2160	
		25	15' X 30'	11250	
15	10'	1	27'11" X 30'	831	1770 #
		10	10' X 15'	1500	
		1	18' X 15'	270	
TOTALS					
TOTAL BUILDING AREA					78,250 #
TOTAL RELEASABLE AREA					75,931 #
TOTAL LAND AREA IN PHASE 2					137,225 #
GROUND COVERAGE PERCENTAGE					57.15%

SITE PLAN
SCALE 1" = 40'-0"



MINI WAREHOUSE & CLOSET STORAGE
ADDISON TEXAS

WATSON TAYLOR REALTY COMPANY
4015 BELTLINE ROAD ADDISON, TEXAS

JOSEPH F. GORDON
5952 ROYAL LANE

ARCHITECT
DALLAS, TEXAS