



"AS BUILT"

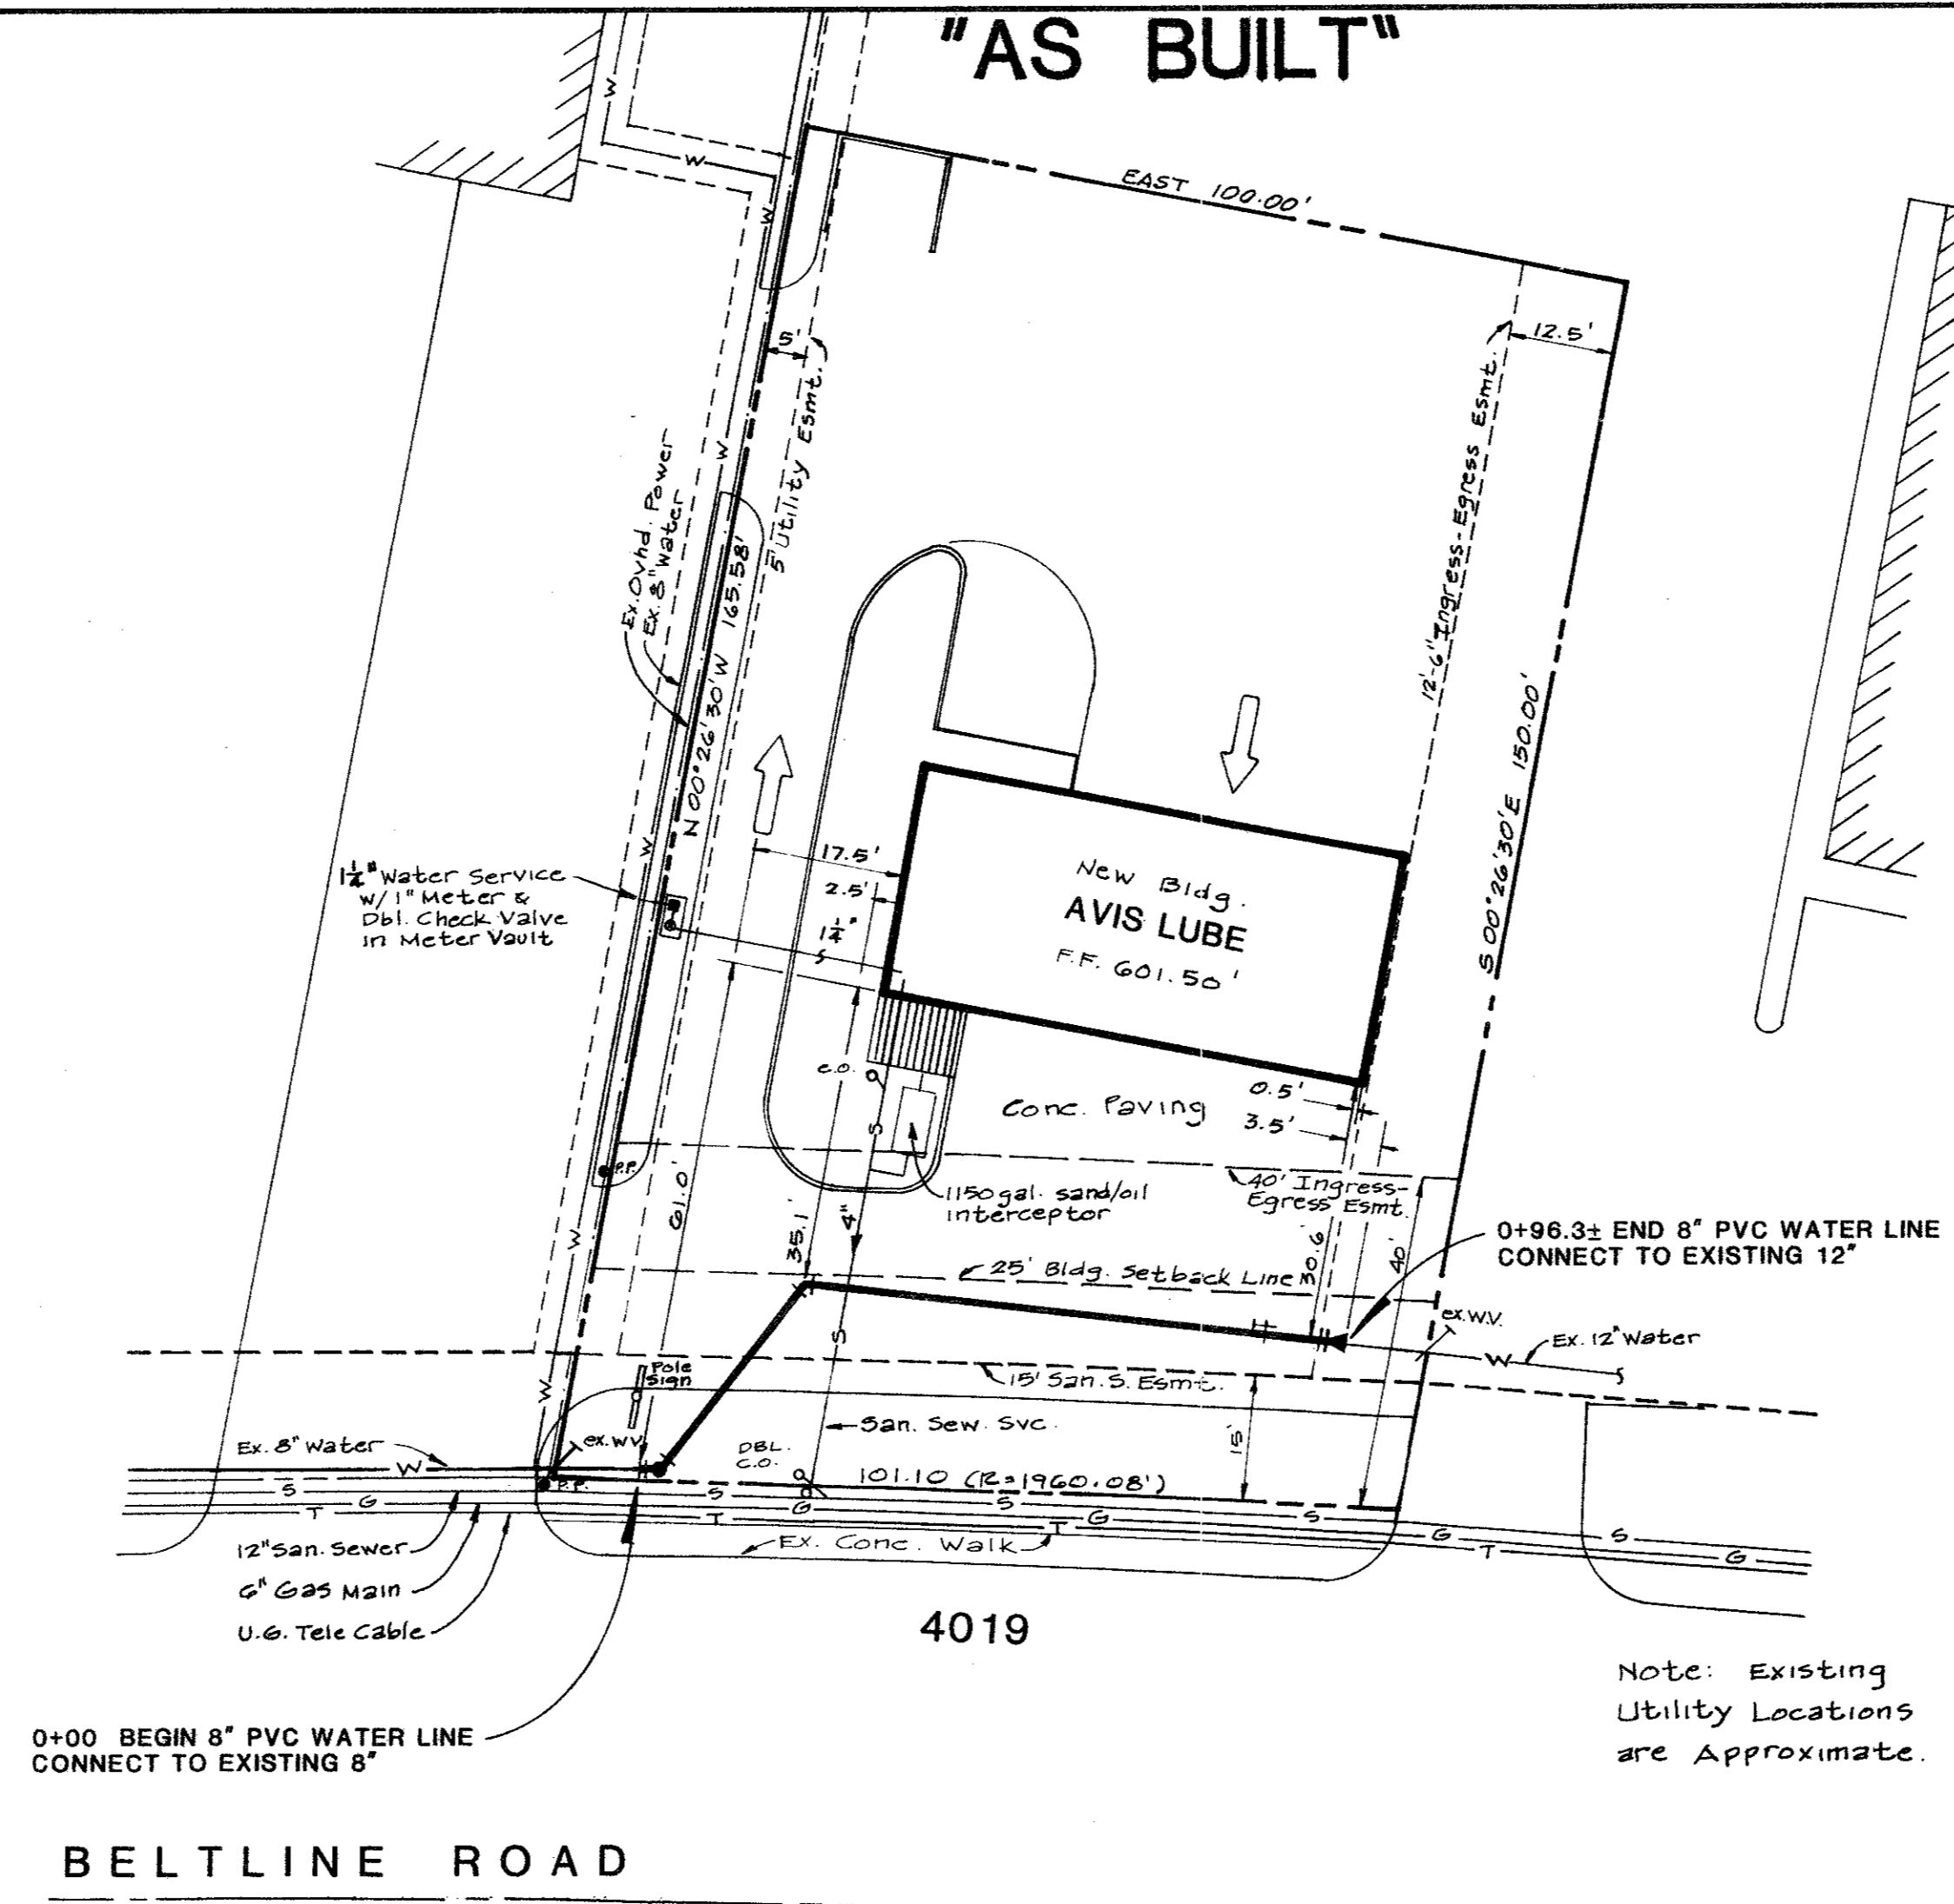


0+00 BEGIN 8" PVC WATER LINE  
CONNECT TO EXISTING 8"

Note: Existing  
Utility Locations  
are Approximate.

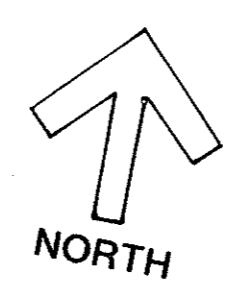

BELTLINE ROAD

SCALE: 1"=20' HORIZ.  
1"=2' VERT.

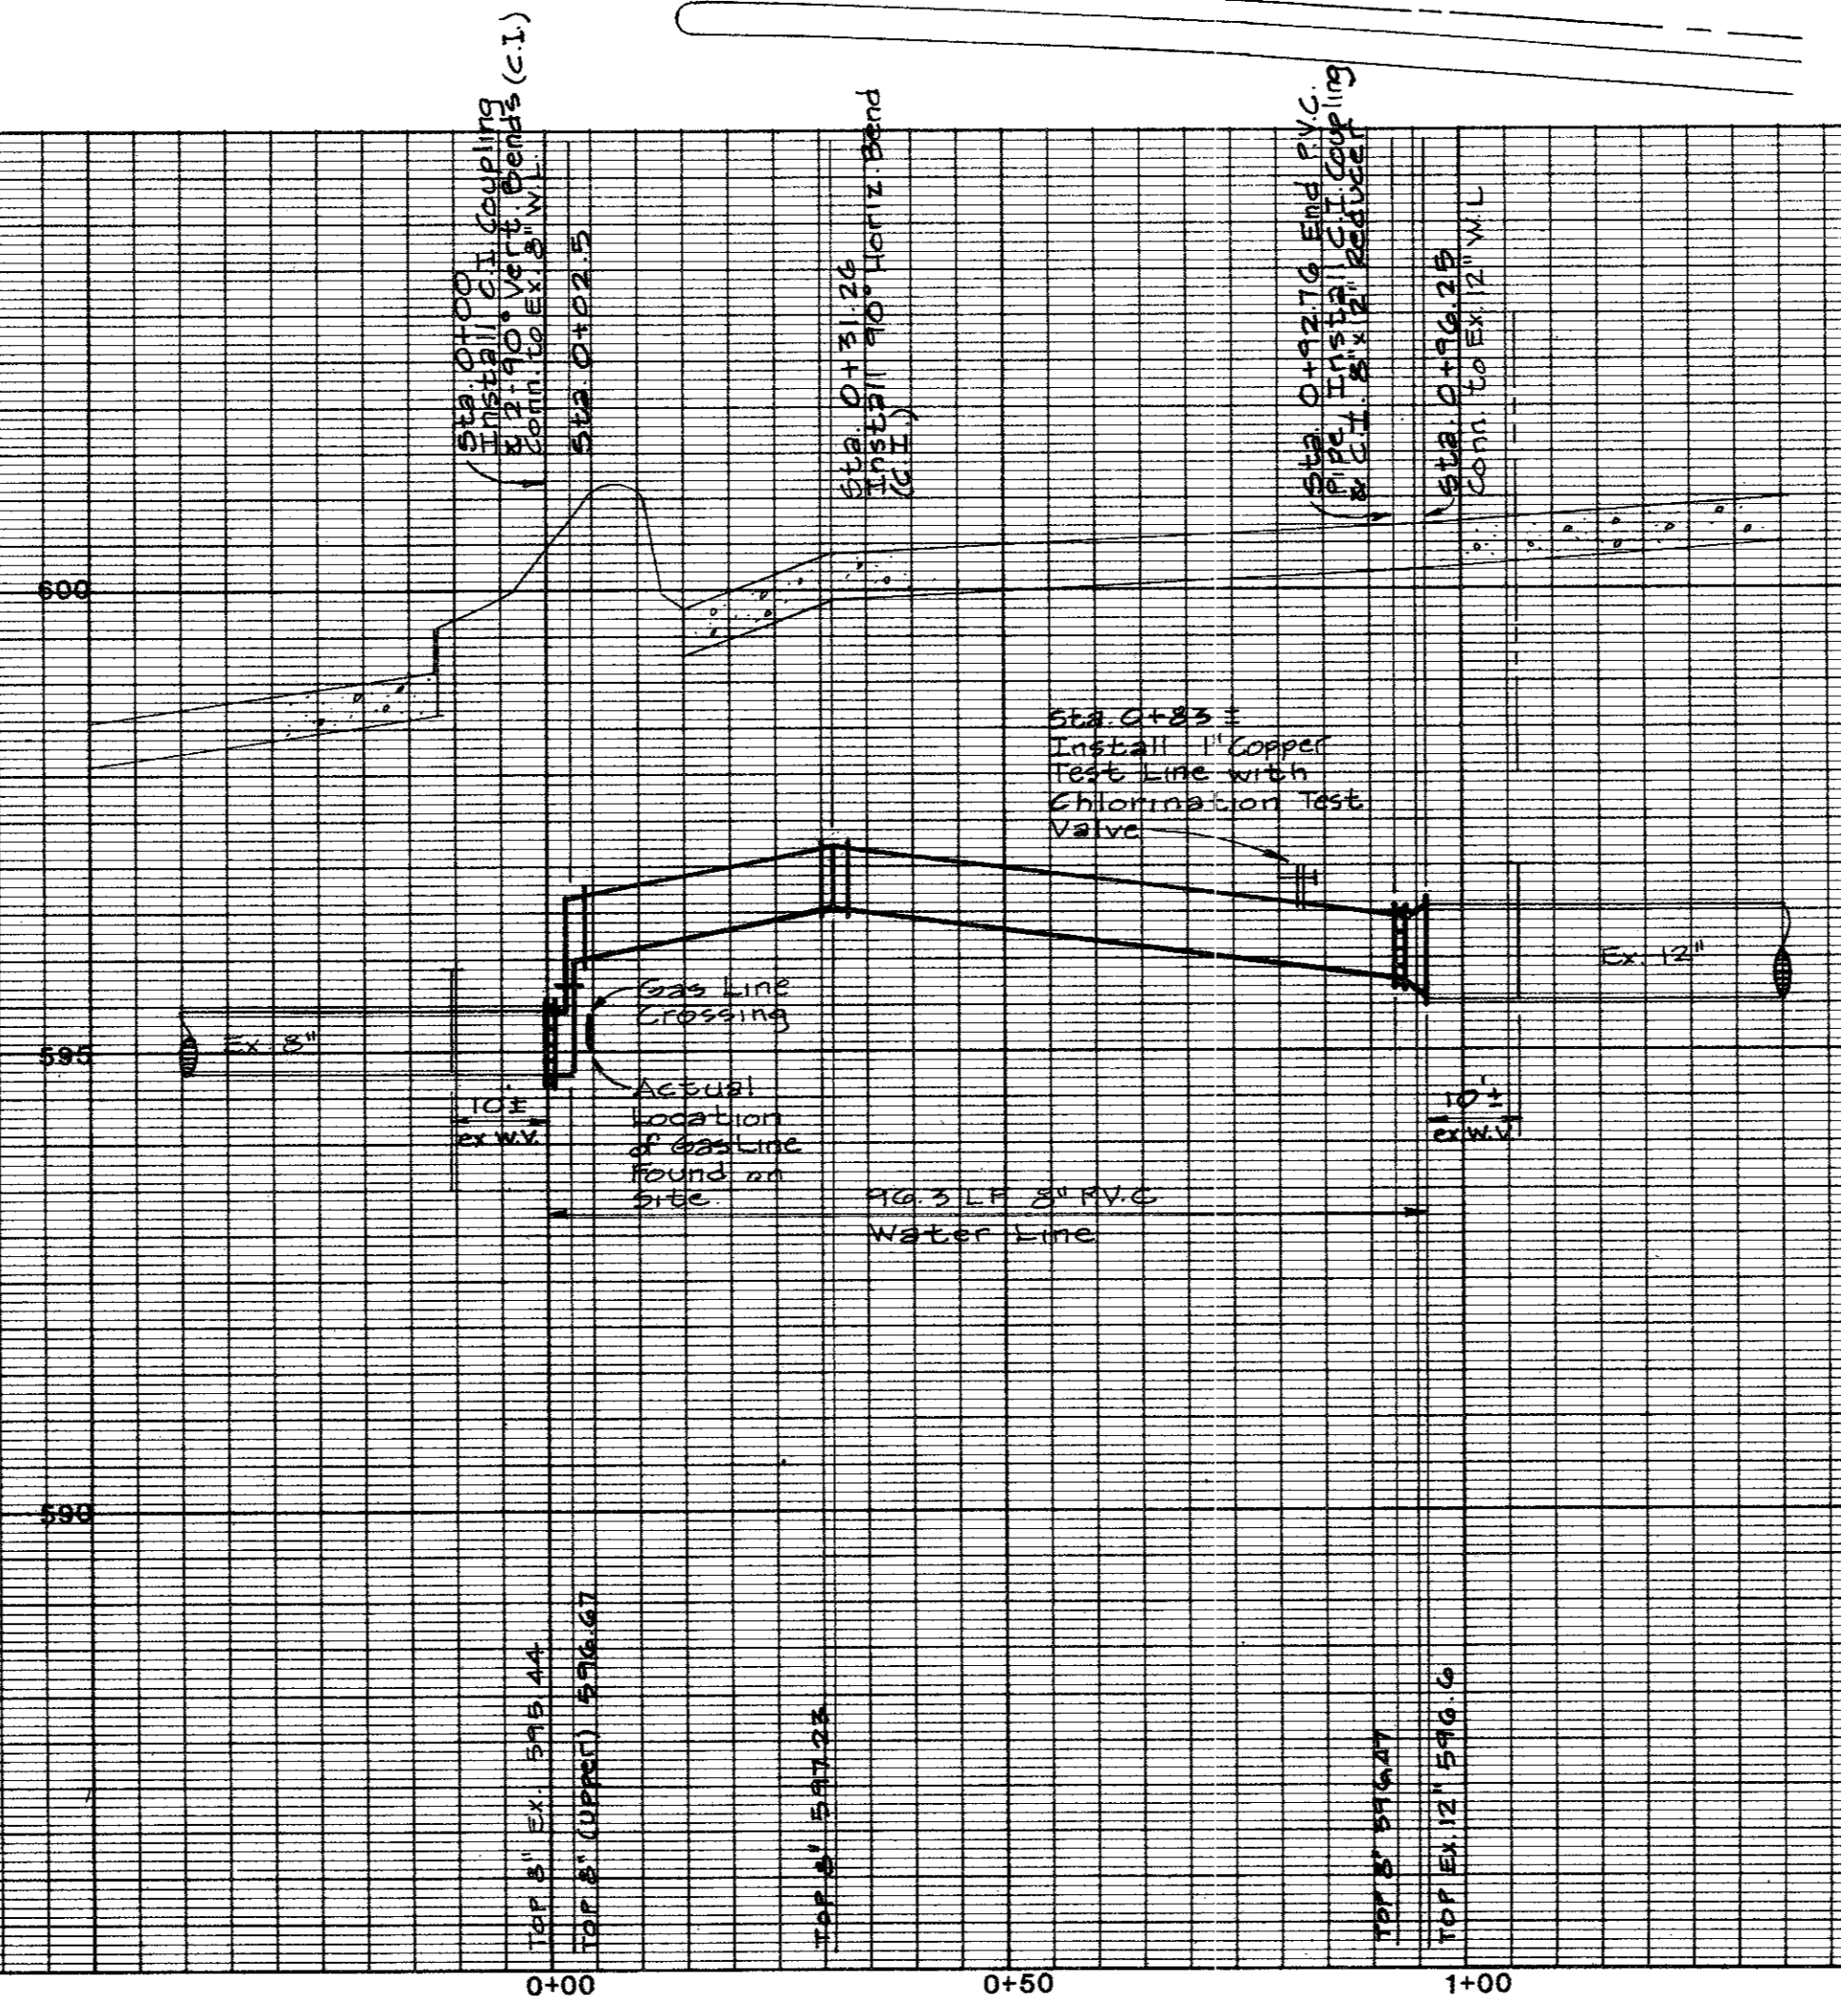

"AS BUILT"



<b>AVIS LUBE</b>			
FAST OIL CHANGE CENTER City of Addison, Texas			
<b>Water Main Plan &amp; Profile</b>			
MICHAEL PEEPLES ENGINEERS AND PLANNERS 14001 DALLAS PARKWAY SUITE 1155 DALLAS, TEXAS 75240 214 458 1968			
DESIGNED BY:	DRAWN BY:	DATE:	SCALE:
CES		1 OCT 89	AS SHOWN