



0+00 BEGIN 8" PVC WATER LINE
CONNECT TO EXISTING 8"

Note: Existing
Utility Locations
are Approximate.

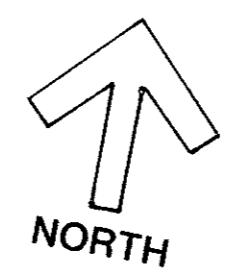


BELTLINE ROAD

SCALE: 1"=20' HORIZ.
1"=2' VERT.

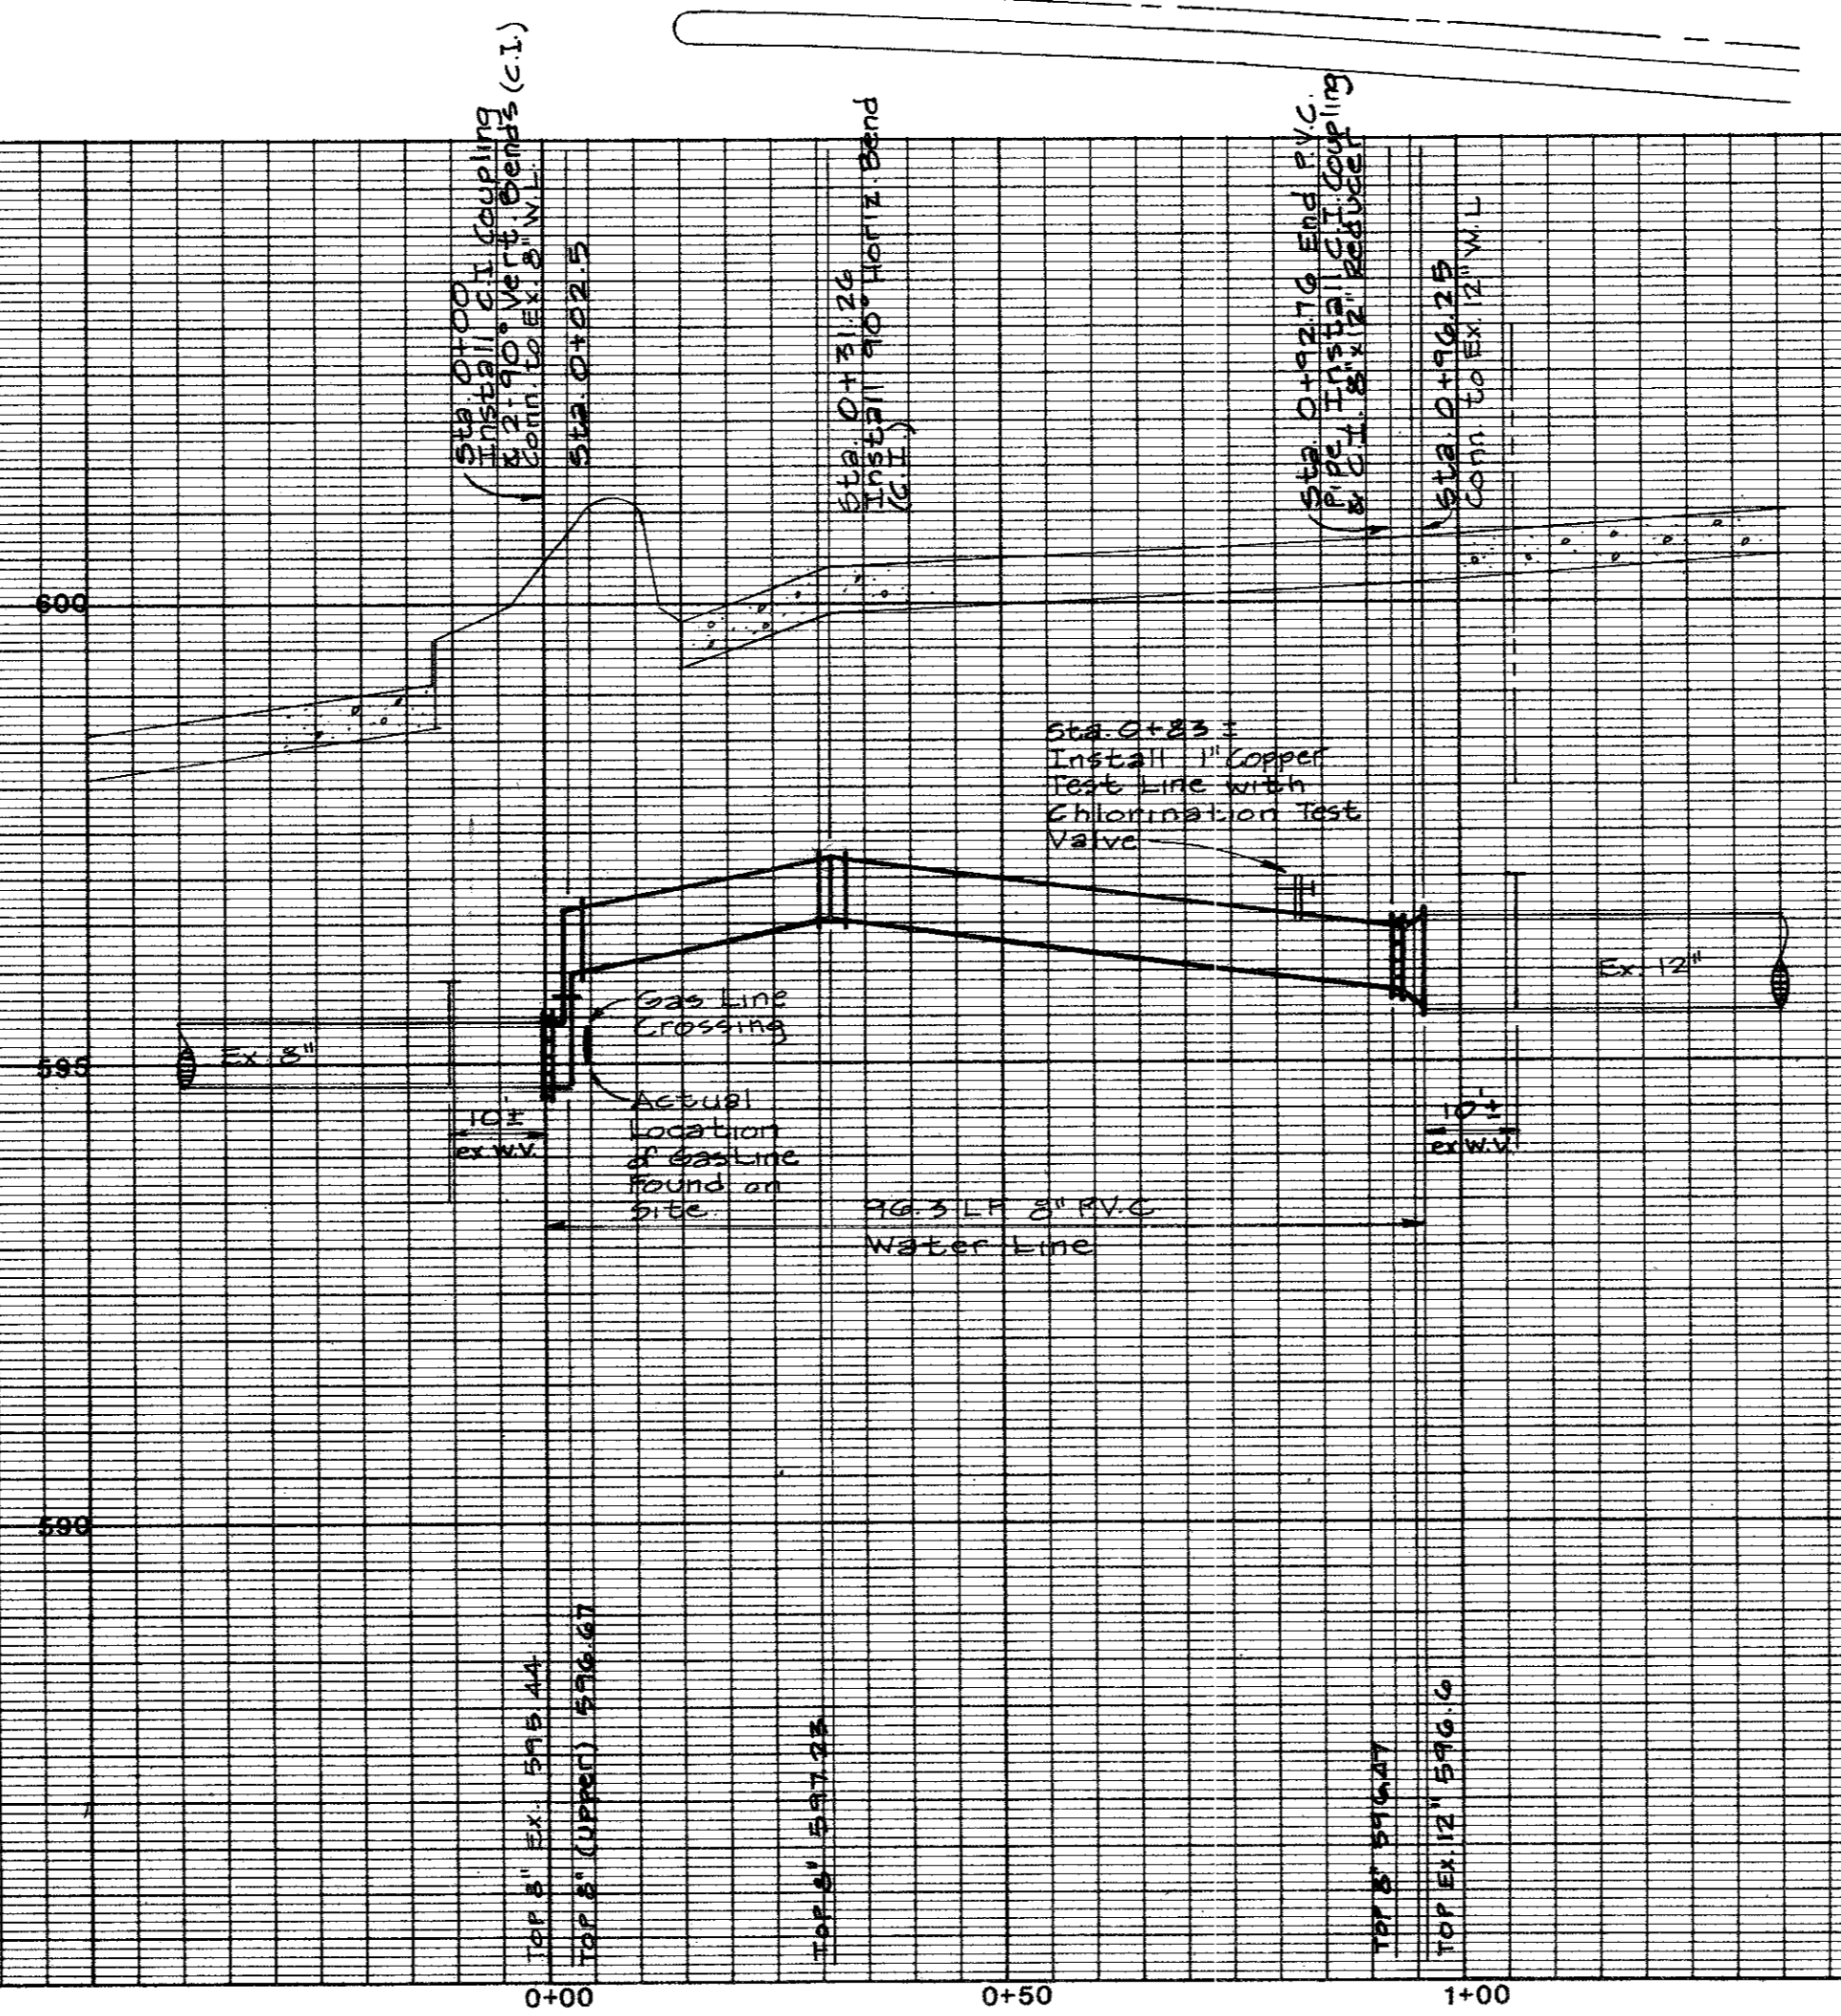

"AS BUILT"

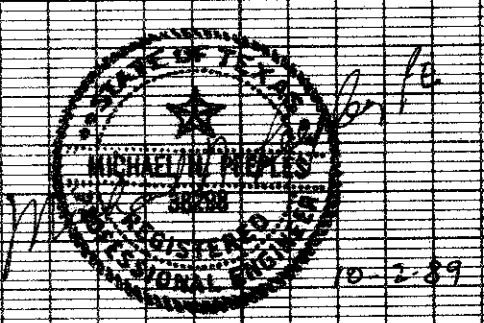

AVIS LUBE			
FAST OIL CHANGE CENTER City of Addison, Texas			
Water Main Plan & Profile			
MICHAEL PEEPLES ENGINEERS AND PLANNERS 14001 DALLAS PARKWAY SUITE 1155 DALLAS, TEXAS 75240 214 458 1968			
DESIGNED BY:	DRAWN BY:	DATE:	SCALE:
CES		1 OCT 89	AS SHOWN