



0+00 BEGIN 8" PVC WATER LINE  
CONNECT TO EXISTING 8"

Note: Existing  
Utility Locations  
are Approximate.

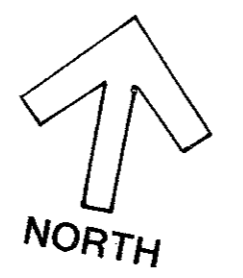

BELTLINE ROAD

SCALE: 1"=20' HORIZ.  
1"=2' VERT.

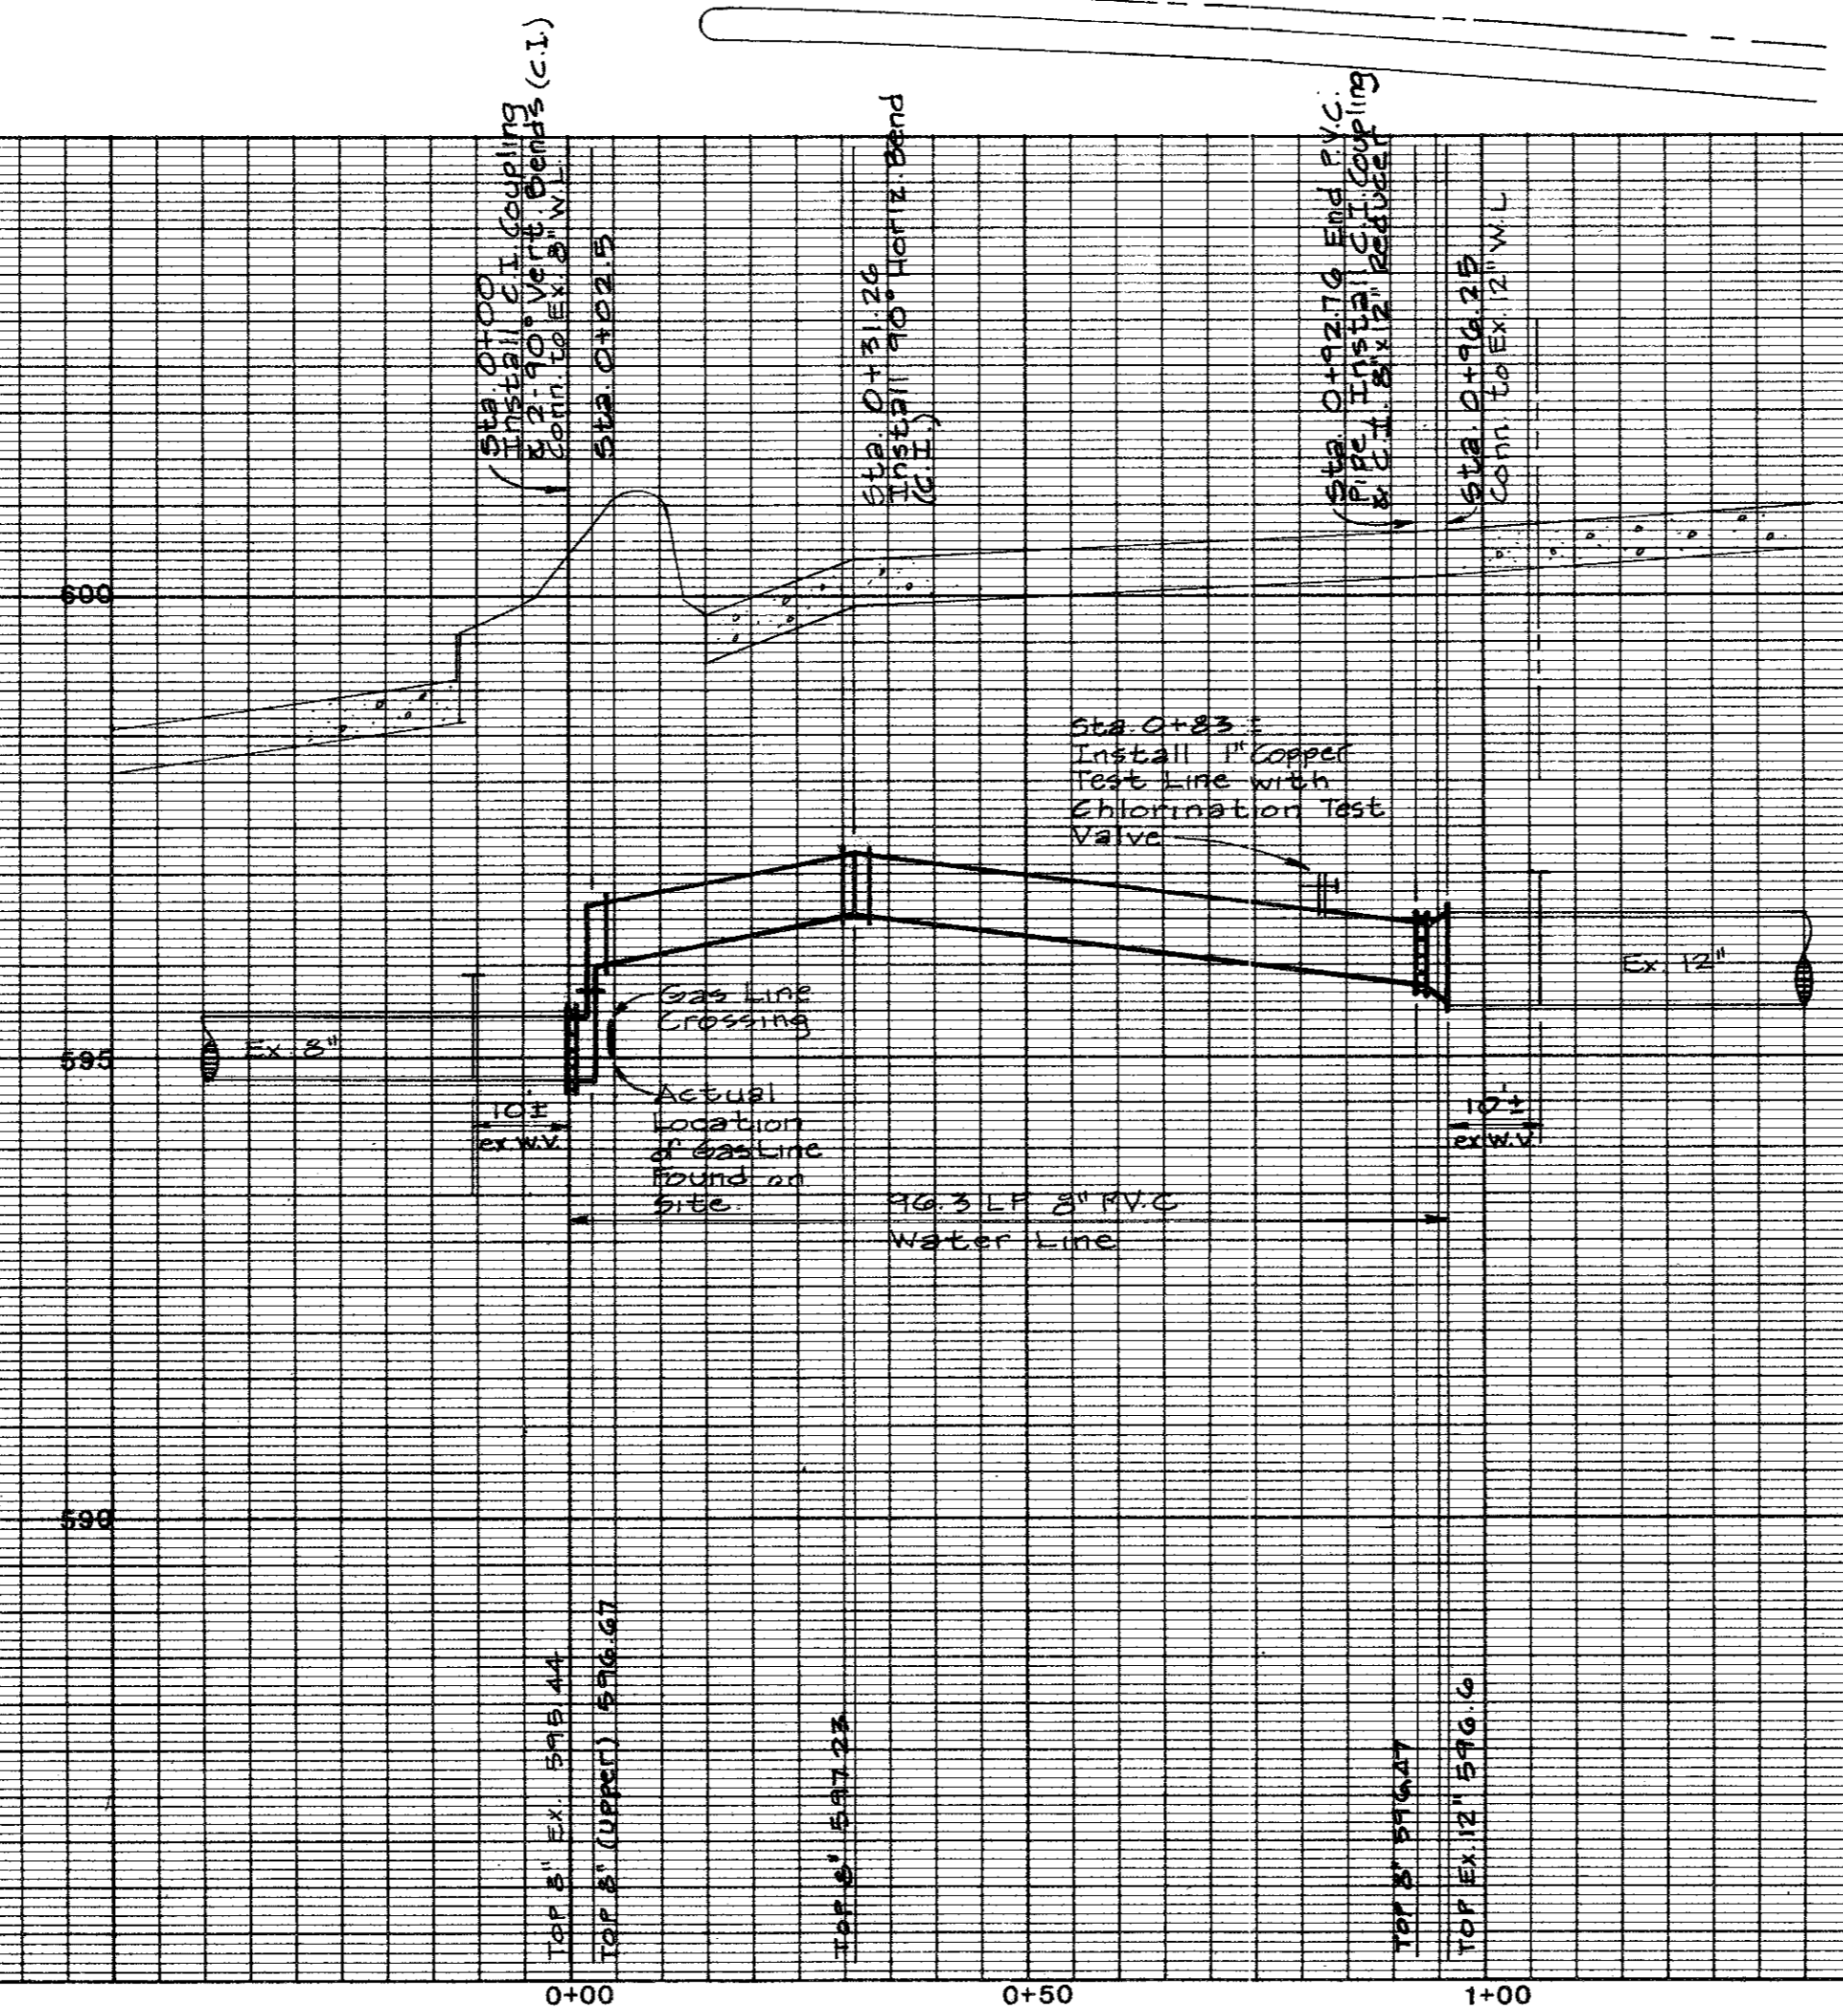

"AS BUILT"



|   |           |          |          |
|---|-----------|----------|----------|
| <b>AVIS LUBE</b>  |           |          |          |
| FAST OIL CHANGE CENTER<br>City of Addison, Texas  |           |          |          |
| <b>Water Main Plan &amp; Profile</b>  |           |          |          |
| MICHAEL PEEPLES ENGINEERS AND PLANNERS<br>14001 DALLAS PARKWAY SUITE 1155<br>DALLAS, TEXAS 75240 214 458 1968 |           |          |          |
| DESIGNED BY:  | DRAWN BY: | DATE:    | SCALE:   |
| CES   |           | 1 OCT 89 | AS SHOWN |