


4019

Note: Existing Utility Locations are Approximate.

BEGIN 8" PVC WATER LINE TO EXISTING 8"

LTLINE ROAD

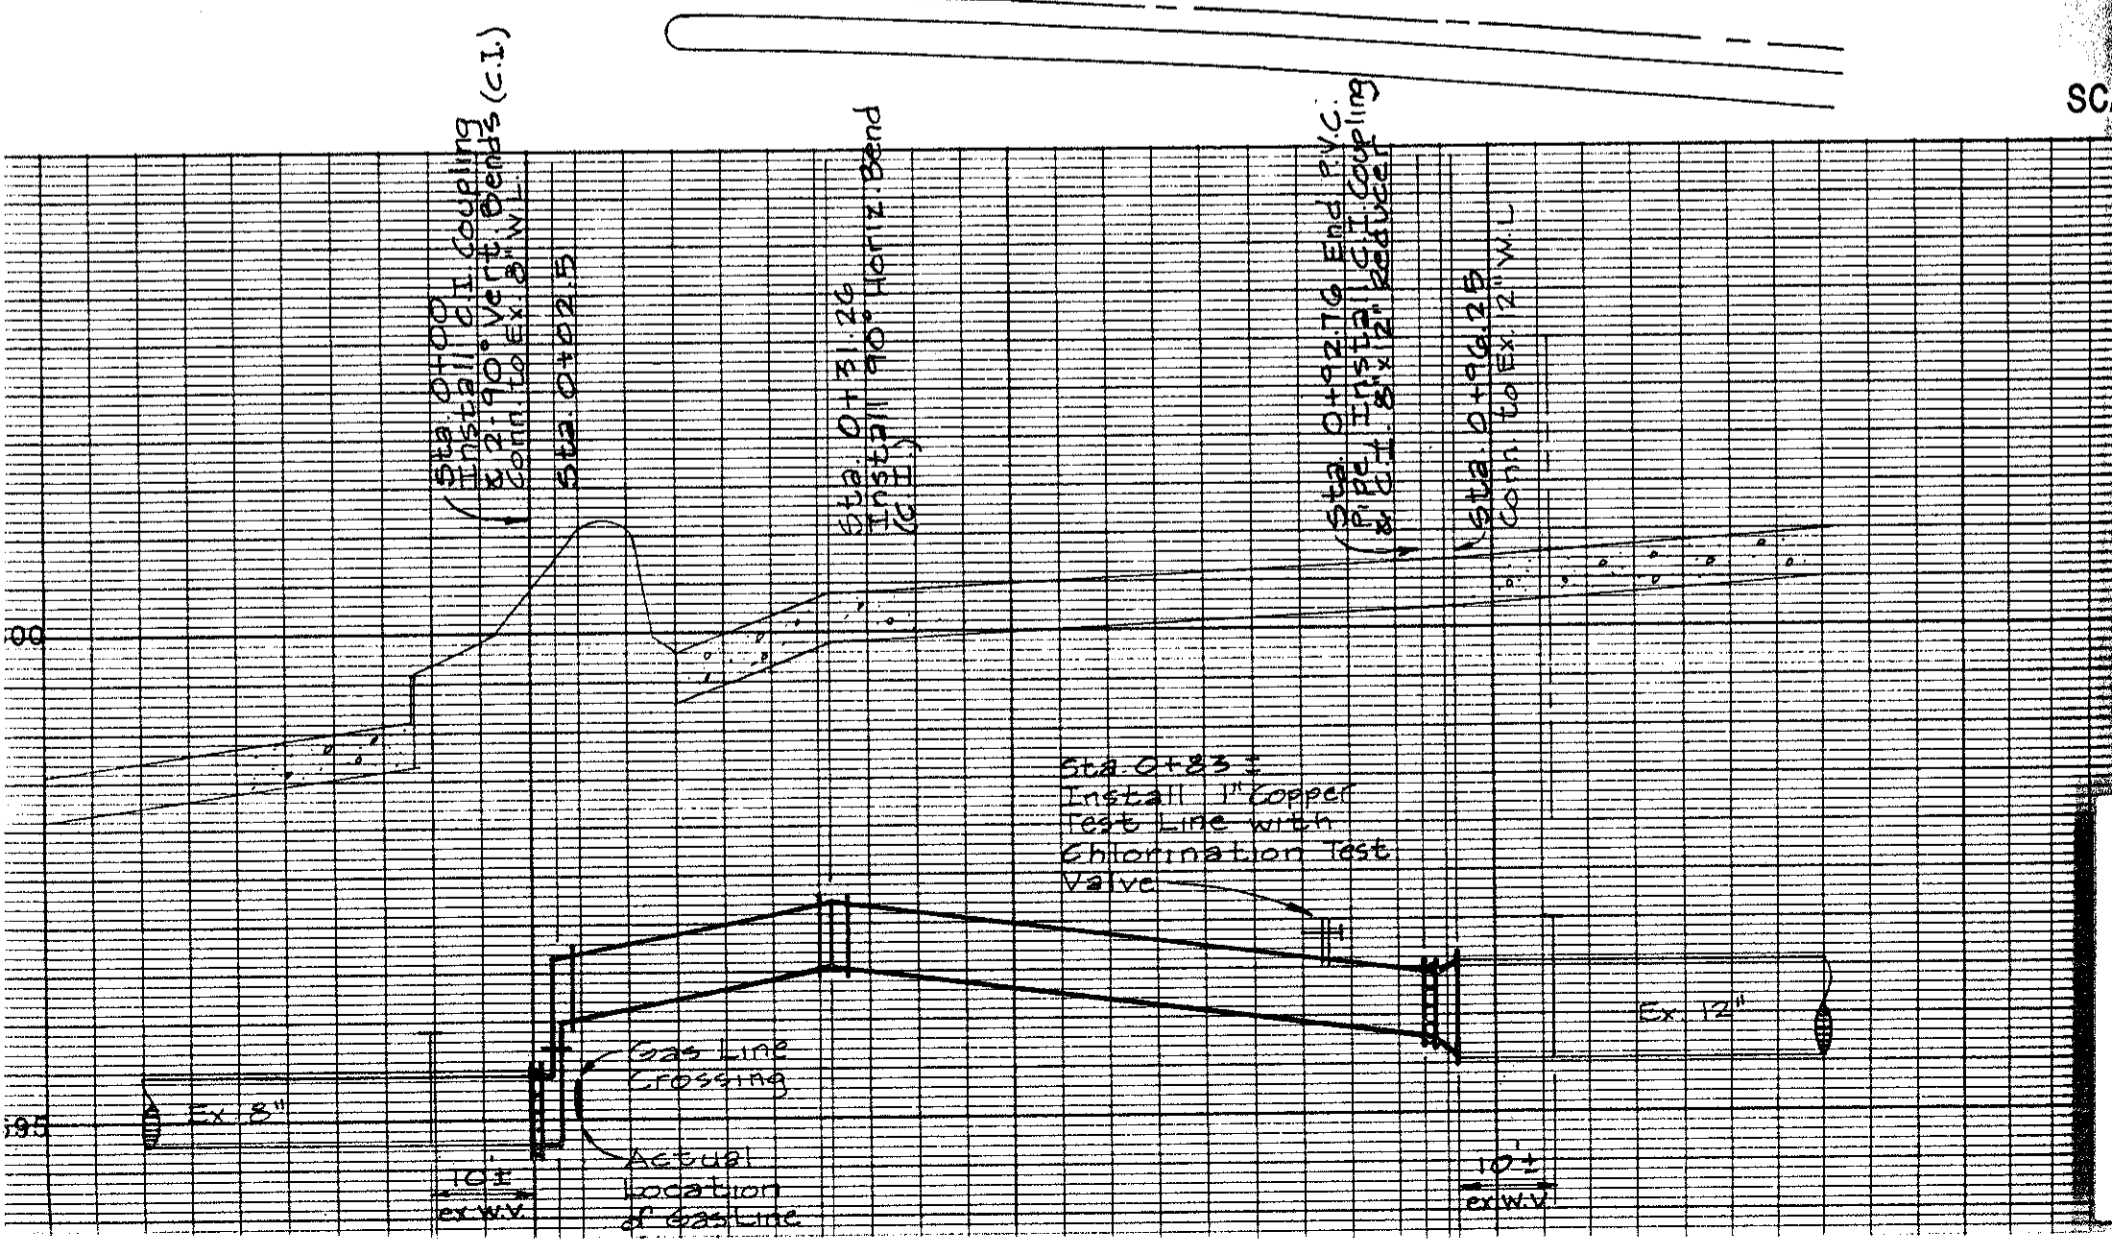

SC