

CITY OF ADDISON  
**APPROVED**  
 FOR CONSTRUCTION  
*[Signature]*  
 BUILDING DEPARTMENT  
 4-29-81

DATE: \_\_\_\_\_  
 NOTE: CONTRACTOR IS HEREBY INSTRUCTED TO EXERCISE CARE IN MEETING OR EXCEEDING ALL REQUIREMENTS OF BOTH NATIONAL AND LOCAL CODES AND ORDINANCES APPLICABLE TO HIS WORK. APPROVAL OF THESE DRAWINGS SHALL NOT BE CONSTRUED TO RELIEVE RESPONSIBILITY OR IMPLY WARRANTY TO SUCH CODES.

$\Delta = 07^{\circ}31'32''$   
 $T = 128.91$   
 $R = 1960.08$   
 $L = 257.45$

113.75 N 89° 51' 55" W

**BELT LINE ROAD**

Exist. Water Main

Install 1 1/2" Water Service

Install 6" Sani. Sew. Lateral to Exist. 12" Sani. Sewer

Double Check Valve to be Provided on Water Services

N 00° 26' 30" W 365.87

S 00° 08' 05" W

**RUNYON ROAD**

349.86

Exist. 12" Water

Install 6" Sani. Sew. Lateral to Exist. 12" Sani. Sewer

Install 1 1/2" Water Service

1-12" x 6" Tee  
 1-6" Valve  
 1-Fire Hydr.

2-12" 45° Bends Conn. to Exist. 12" Water

1-12" Valve  
 1-12" Plug

Exist. 12" Sani. Sew.

Inst. 12" Water


Exist. 12" Water


SUBDIVISION: PART OF LOT 4, WATSON & TAYLOR SUBD.  
 DESIGNED: \_\_\_\_\_ Date: \_\_\_\_\_  
 Ferguson-Deere, Inc., Engineers  
 R.O.W. APPROVED: \_\_\_\_\_ Date: \_\_\_\_\_  
 ENGINEER OF DESIGN: \_\_\_\_\_ Date: \_\_\_\_\_  
 Water Utilities Department  
 CONTRACT NO. \_\_\_\_\_

**WATER & SANITARY SEWER**  
**BELT LINE ROAD & RUNYON ROAD**

**WATER UTILITIES DEPARTMENT**  
**CITY OF ADDISON, TEXAS**

DESIGN	DRAWN	DATE	SCALE	NOTES	FILE	NO.
F. & D.	L. K.	DEC. 80	1"=30'	F. & D.		


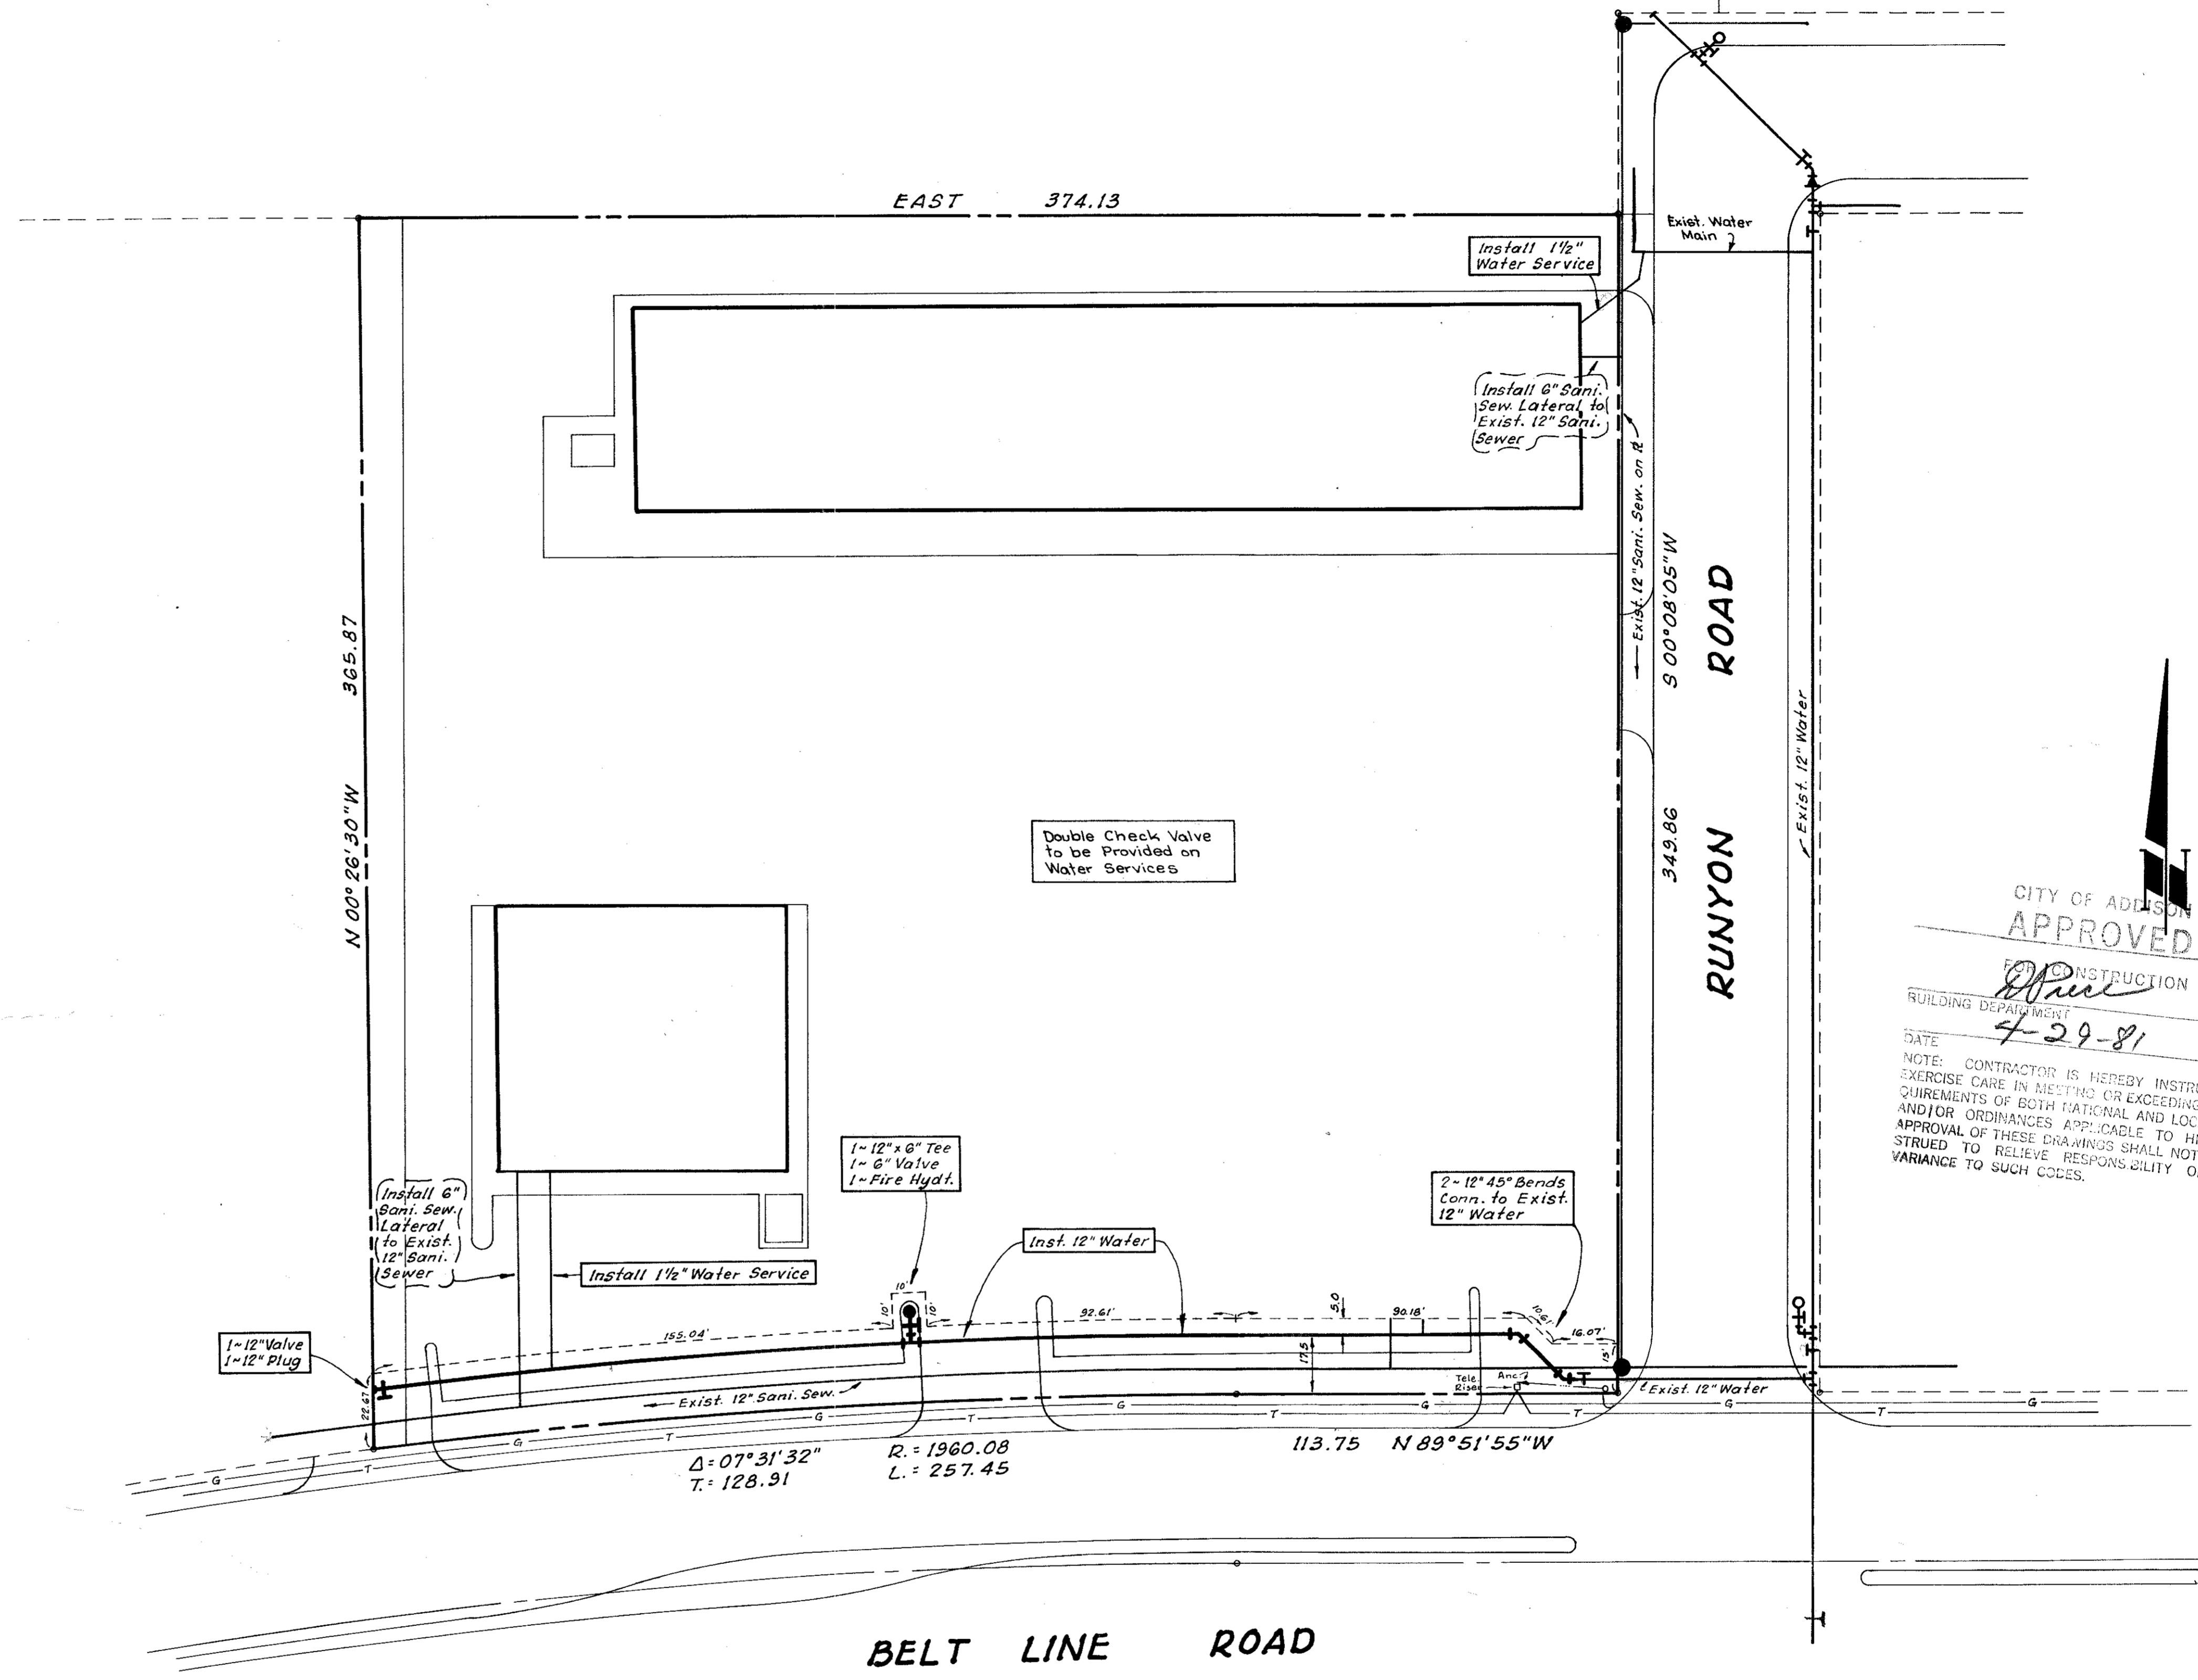


  
 CITY OF ADDISON  
**APPROVED**  
 FOR CONSTRUCTION  
*[Signature]*  
 BUILDING DEPARTMENT  
 DATE: 4-29-81  
 NOTE: CONTRACTOR IS HEREBY INSTRUCTED TO EXERCISE CARE IN MEETING OR EXCEEDING ALL REQUIREMENTS OF BOTH NATIONAL AND LOCAL CODES AND/OR ORDINANCES APPLICABLE TO HIS WORK. APPROVAL OF THESE DRAWINGS SHALL NOT BE CONSTRUED TO RELIEVE RESPONSIBILITY OR IMPLY VARIANCE TO SUCH CODES.

SUBDIVISION: PART OF LOT 4, WATSON & TAYLOR SUBD.  
 DESIGNED: Ferguson-Deere, Inc., Engineers Date: \_\_\_\_\_  
 R.O.W. APPROVED: \_\_\_\_\_ Date: \_\_\_\_\_  
 ENGINEER OF DESIGN: Water Utilities Department Date: \_\_\_\_\_  
 CONTRACT NO. \_\_\_\_\_

WATER & SANITARY SEWER						
BELT LINE ROAD & RUNYON ROAD						
WATER UTILITIES DEPARTMENT						
CITY OF ADDISON, TEXAS						
DESIGN	DRAWN	DATE	SCALE	NOTES	FILE	NO.
F. & D.	L. K.	DEC. 80	1"=30'	F. & D.		

Bldg. & Parking Revised 3-23-81 689

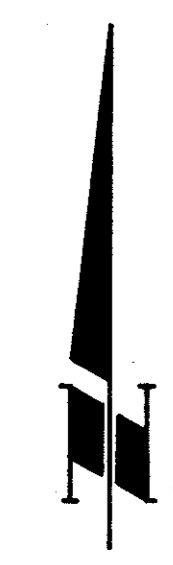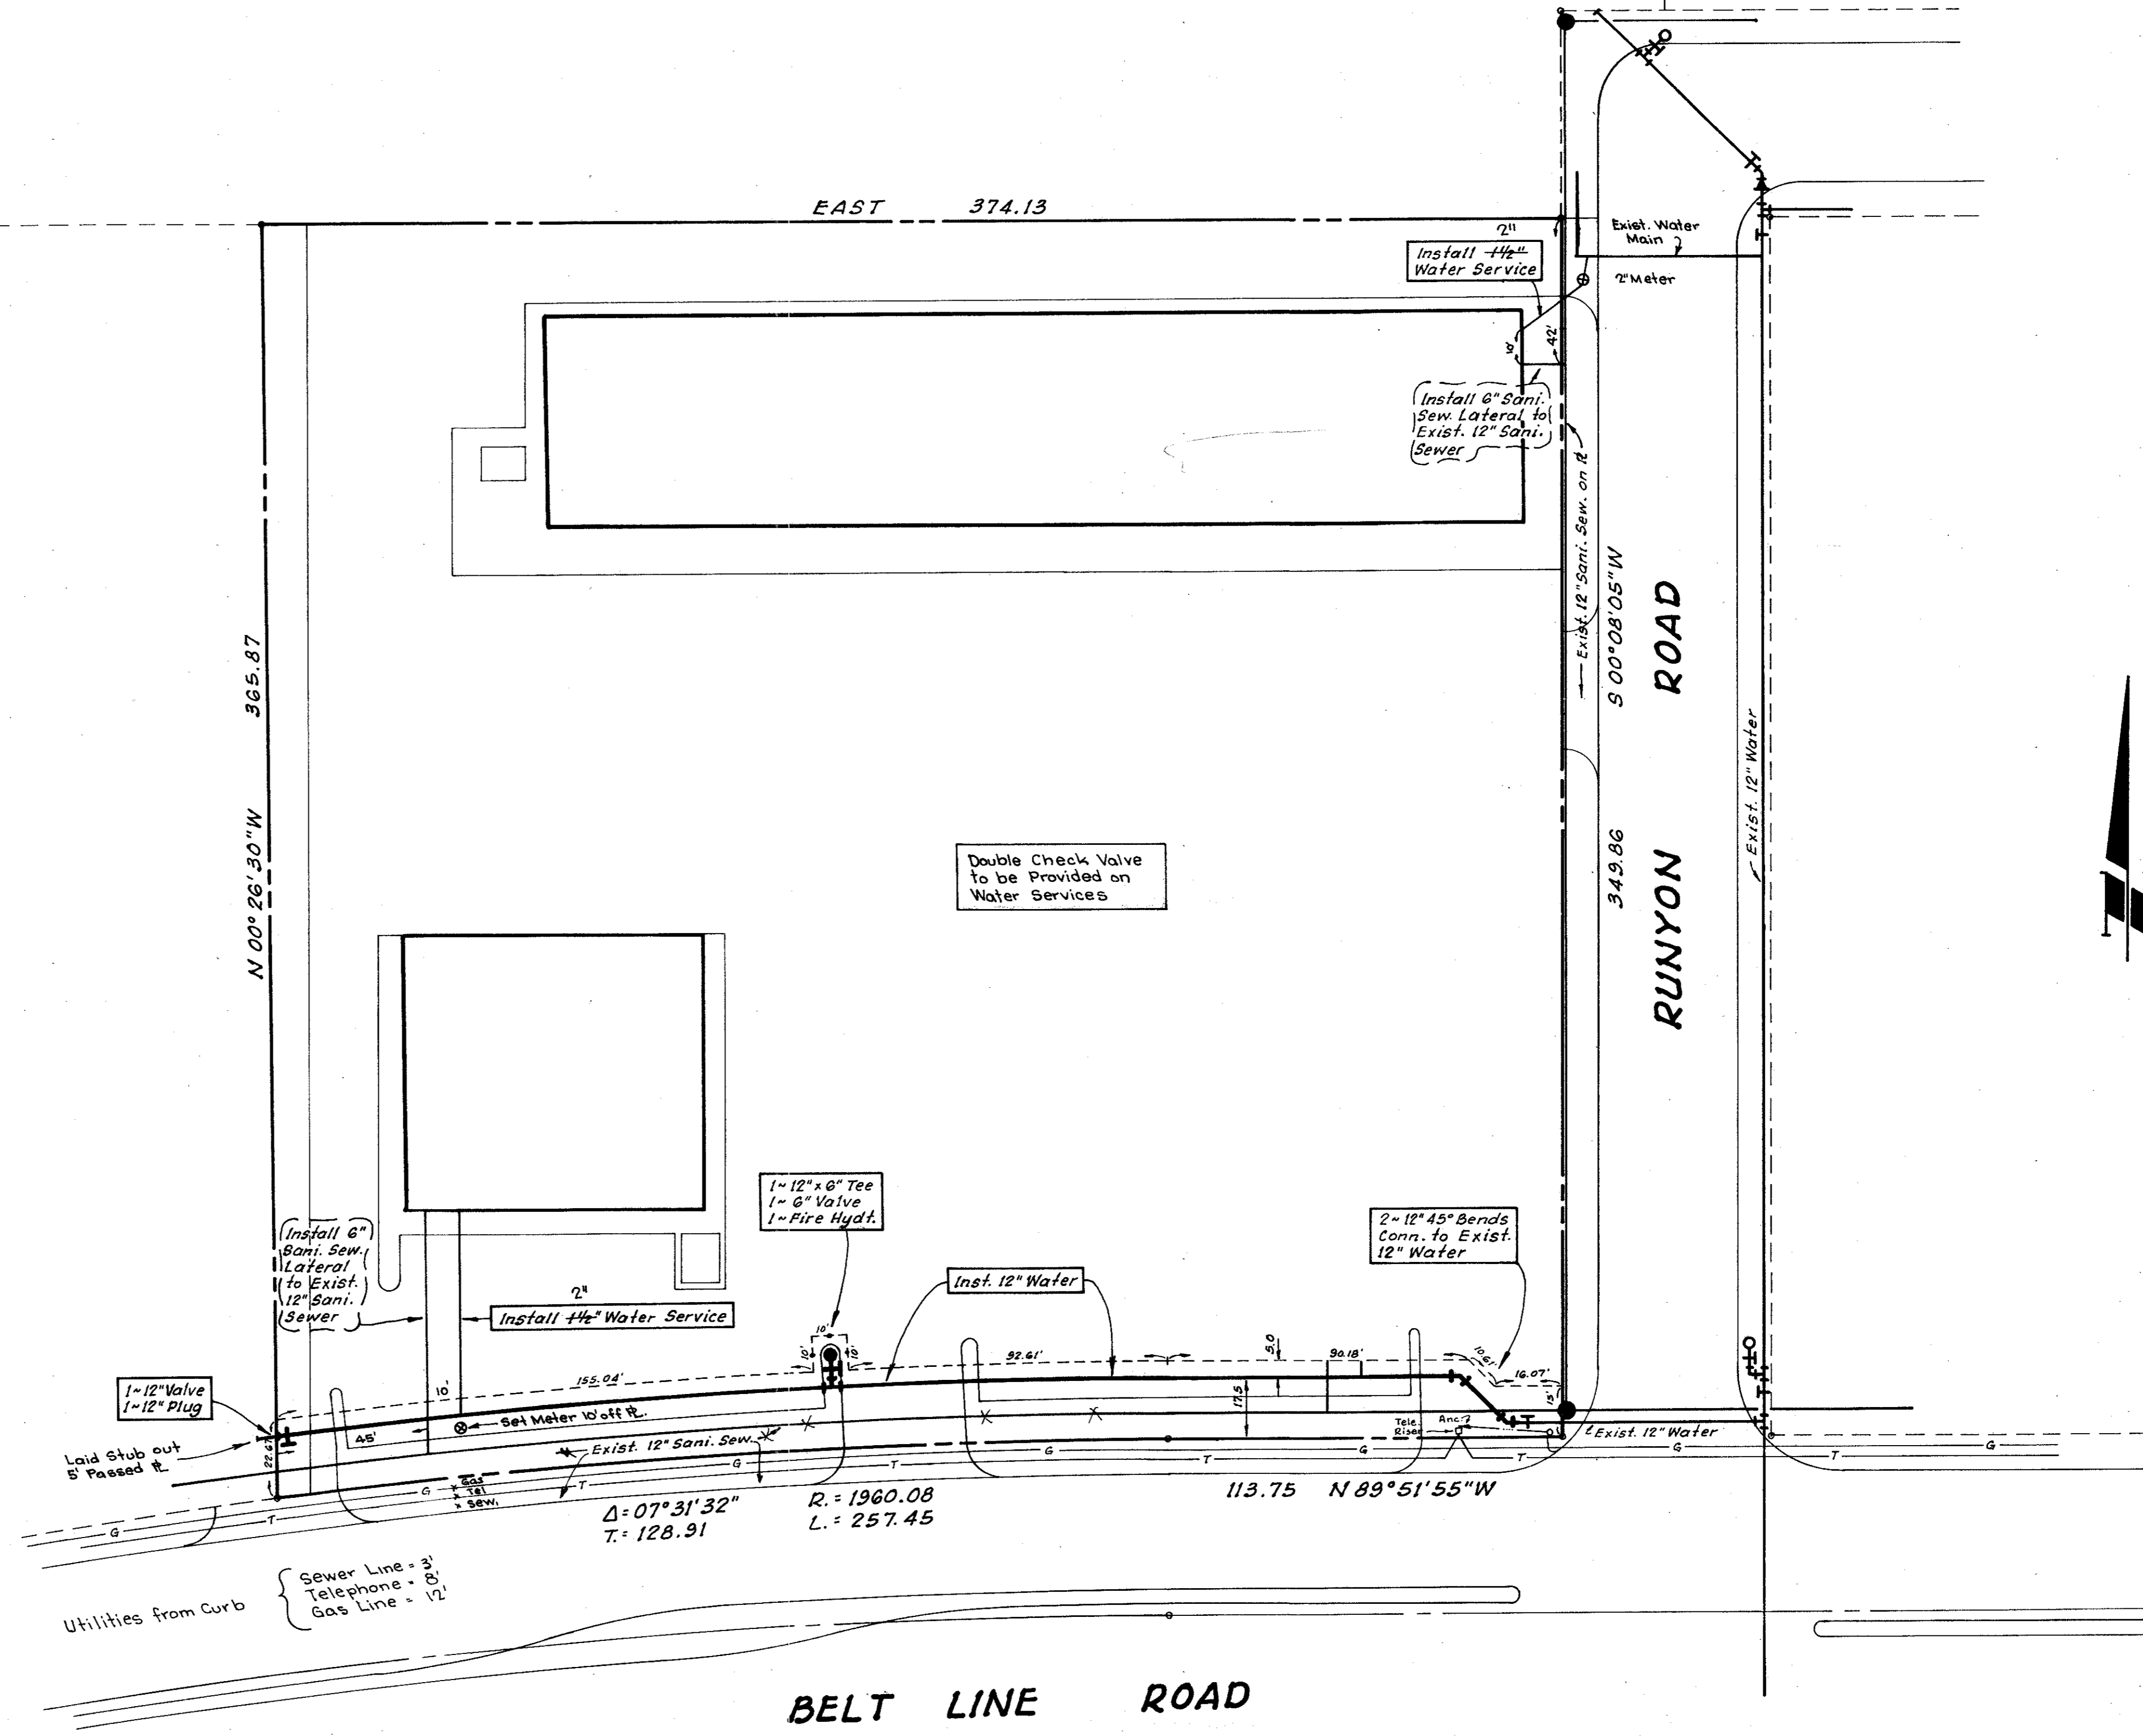


AS BUILT DRAWING  
4091 BELT LINE RD.  
6-23-81



SUBDIVISION: PART OF LOT 4, WATSON & TAYLOR SUBD.  
 DESIGNED: Ferguson-Deere, Inc., Engineers Date: \_\_\_\_\_  
 R.O.W. APPROVED: \_\_\_\_\_ Date: \_\_\_\_\_  
 ENGINEER OF DESIGN: Water Utilities Department Date: \_\_\_\_\_  
 CONTRACT NO. \_\_\_\_\_

Bldg. & Parking Revised 3-23-81 881

<b>WATER &amp; SANITARY SEWER</b>						
<b>BELT LINE ROAD &amp; RUNYON ROAD</b>						
<b>WATER UTILITIES DEPARTMENT</b>						
<b>CITY OF ADDISON, TEXAS</b>						
DESIGN	DRAWN	DATE	SCALE	NOTES	FILE	NO.
F.E.D.	L.K.	DEC. 80	1"=30'	F.E.D.		

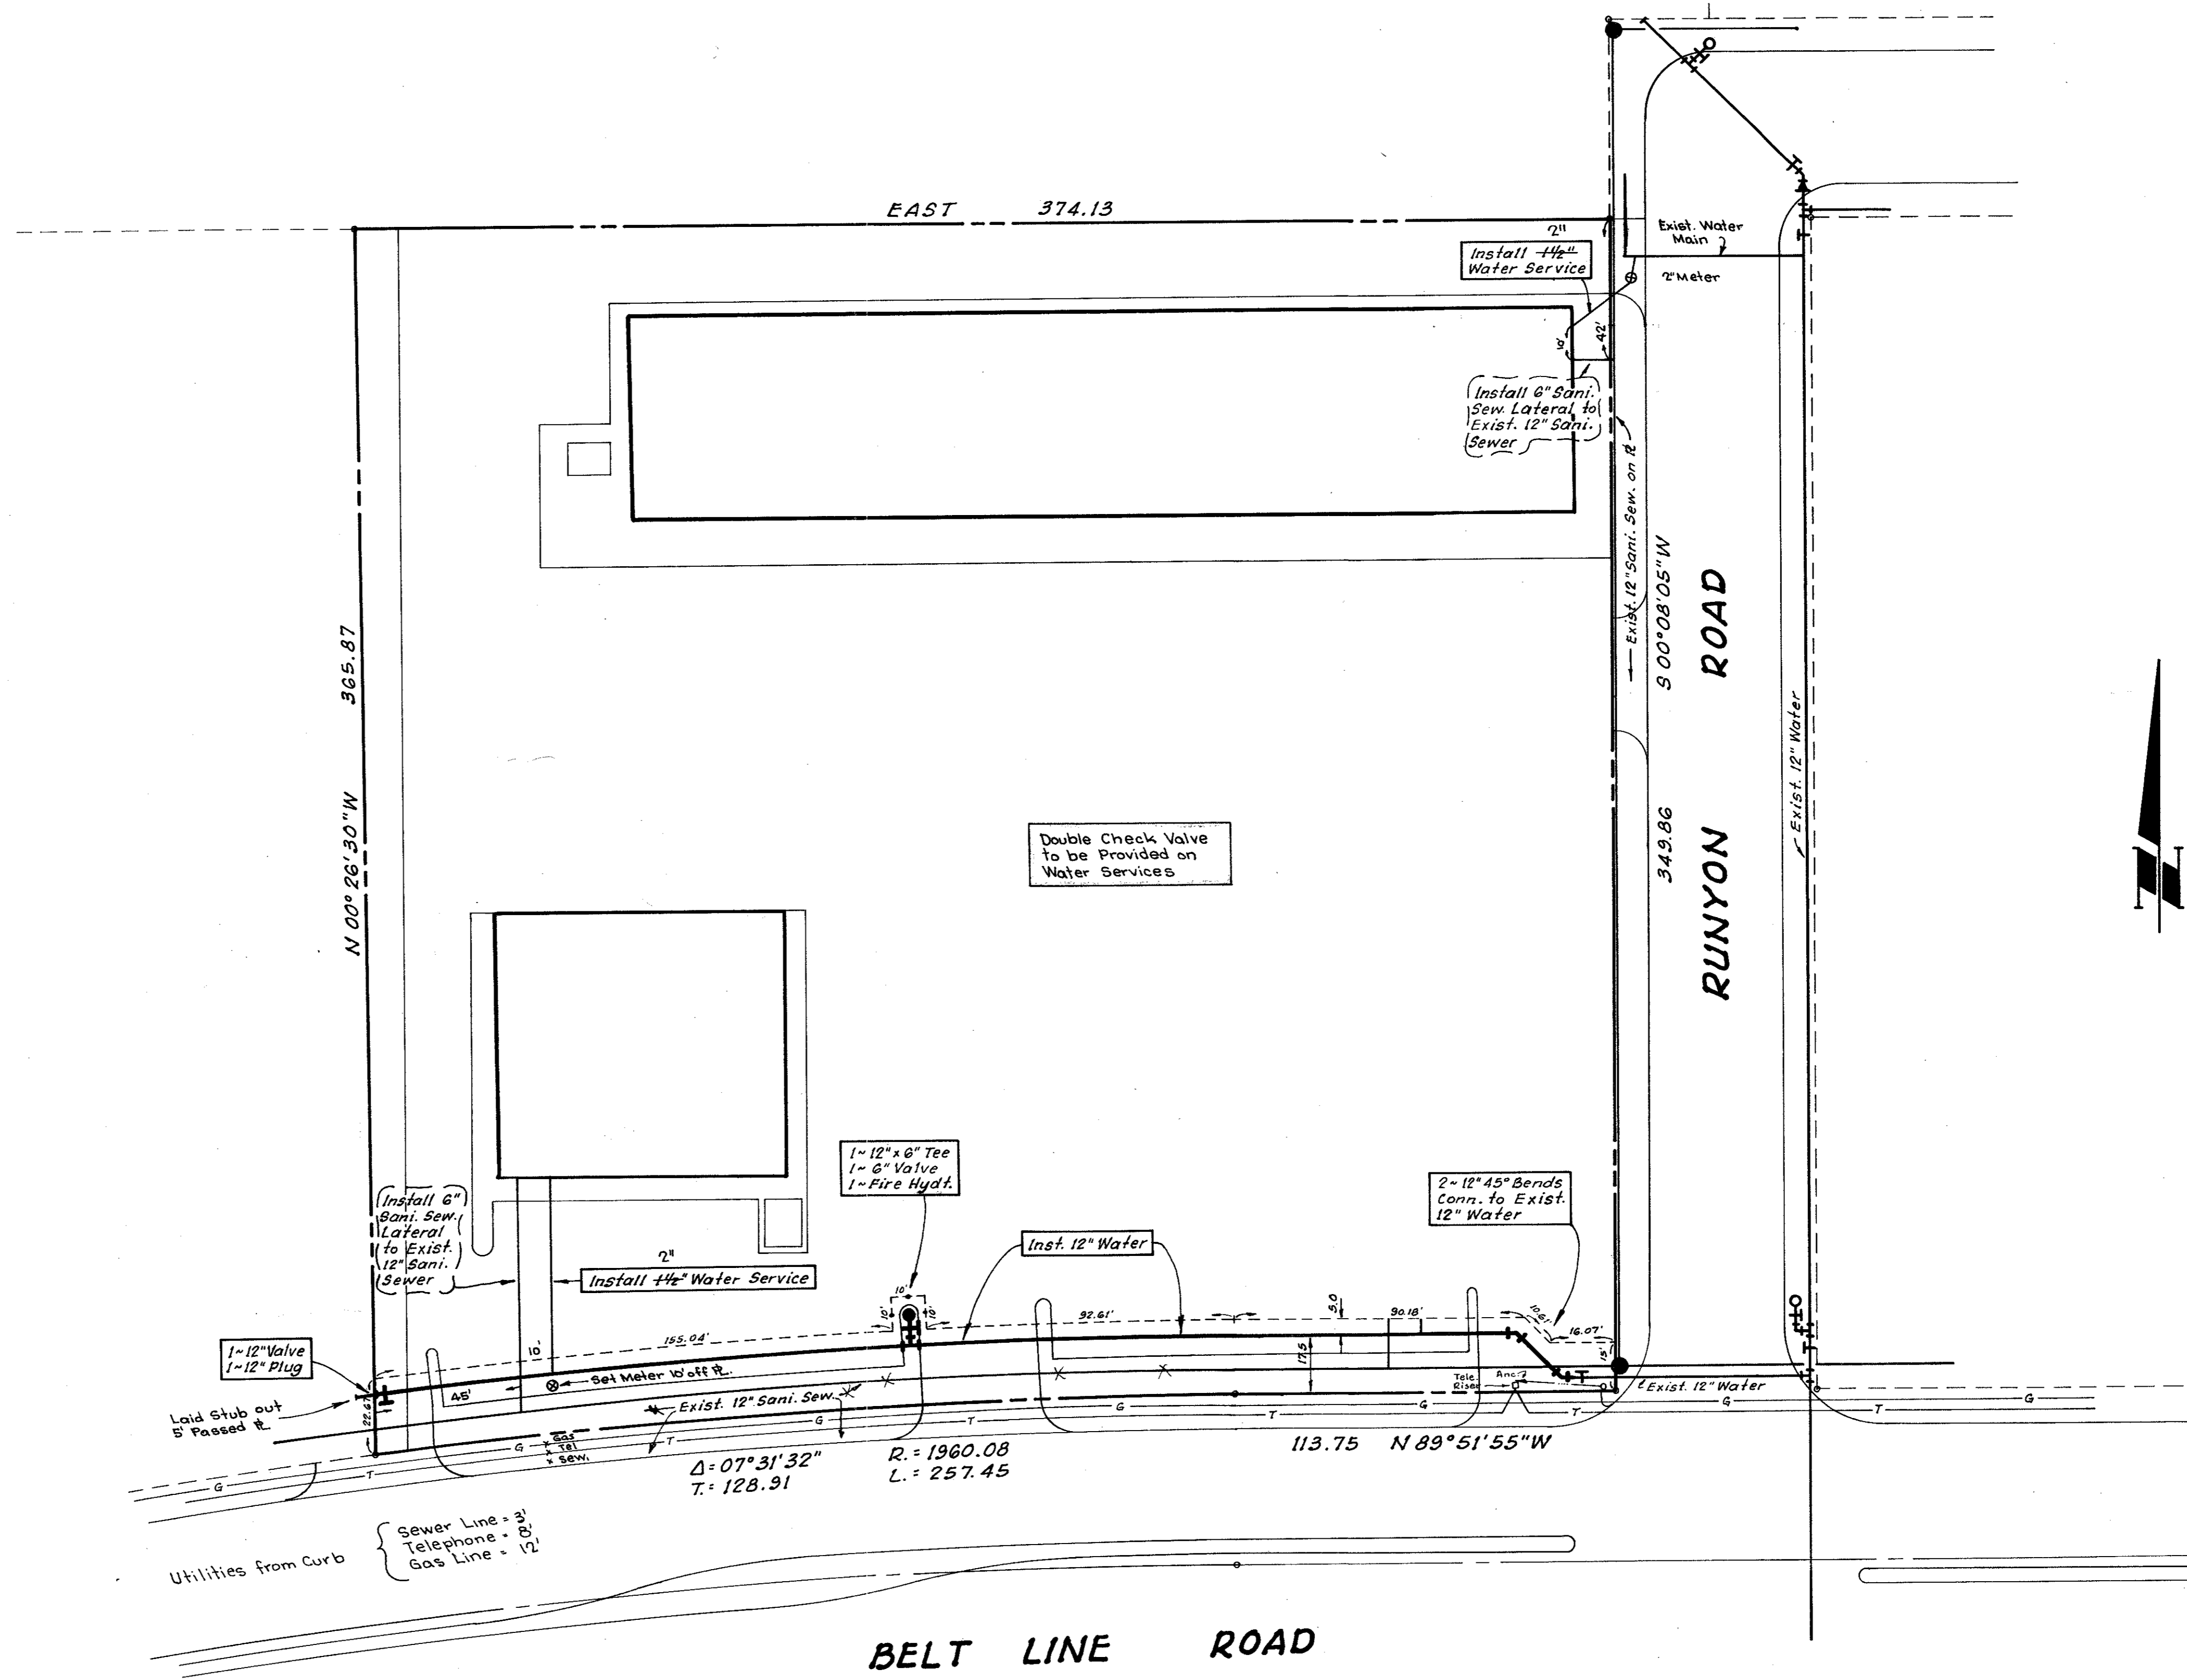

AS BUILT DRAWING  
4091 BELT LINE RD.  
G-23-81

SUBDIVISION: PART OF LOT 4, WATSON & TAYLOR SUBD.  
 DESIGNED: Ferguson-Deere, Inc., Engineers Date: \_\_\_\_\_  
 R.O.W. APPROVED: \_\_\_\_\_ Date: \_\_\_\_\_  
 ENGINEER OF DESIGN: \_\_\_\_\_ Date: \_\_\_\_\_  
 Water Utilities Department  
 CONTRACT NO. \_\_\_\_\_



WATER & SANITARY SEWER						
BELT LINE ROAD & RUNYON ROAD						
WATER UTILITIES DEPARTMENT						
CITY OF ADDISON, TEXAS						
DESIGN	DRAWN	DATE	SCALE	NOTES	FILE	NO.
F&D.	L.K.	DEC. 80	1"=30'	F&D.		

Bldg. & Parking Revised 3-23-81 681

63-1