

CONSTRUCTION PLANS

ADDISON WEST INDUSTRIAL PARK

4135 BELT LINE ROAD

AN ADDITION TO THE

TOWN OF ADDISON, TEXAS

ADDISON WEST INDUSTRIAL PARK

Index Of Drawings

Cover Sheet	Plat
C 1	Paving Plan
C 2	Grading Plan
C 3	Drainage Plan
C 4	Storm Sewer Profile
C 5	Water & Sewer Plan
C 6	Erosion Control Plan
C 7	Erosion Control Notes
C 8	Details


Prepared For

BELTLINE REALTY PARTNERS, INC.
 4311 OAK LAWN AVENUE, SUITE 400
 DALLAS, TEXAS 75219

Engineer



RLK ENGINEERING, LLC
 111 West Main
 Allen, Texas 75013
 (972) 359-1733 Off
 (972) 359-1833 Fax

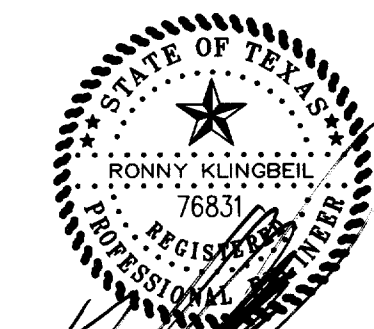


RECORD
 DRAWING

REVISED TO CONFORM TO
 CONSTRUCTION RECORDS

Ronny Klingbeil, P.E.

Date

1/3/07

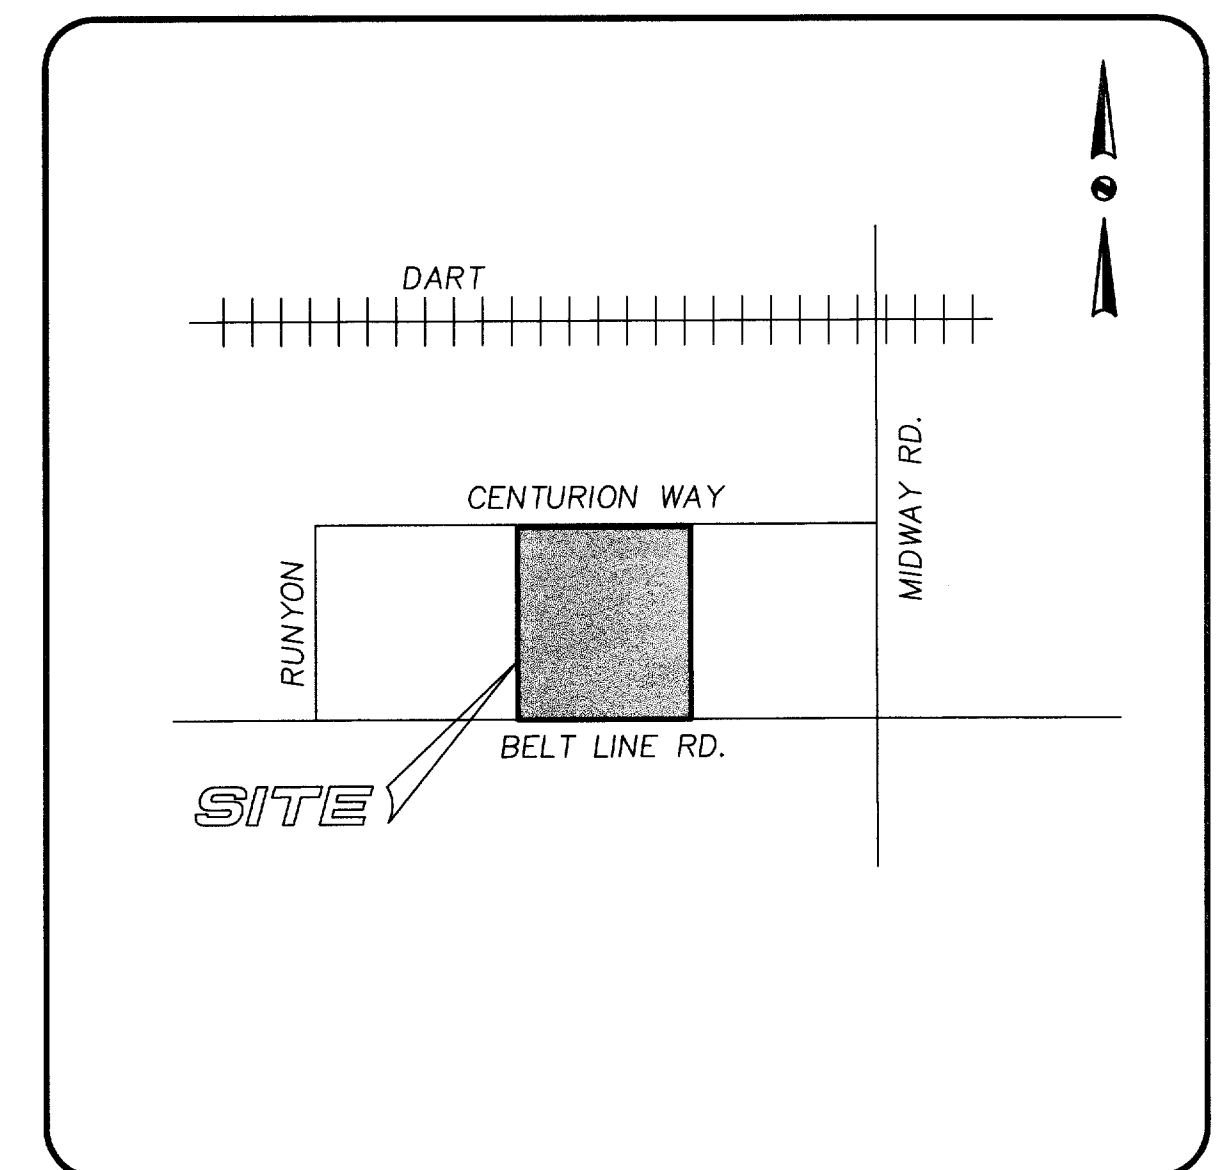

Location Map

FF-7