


!!! CAUTION !!!
 Existing Utility Lines In Area
 Contractor To Verify Existing Utility Locations
 Contact Appropriate Utility Companies
 48 Hrs. Prior To Any Construction

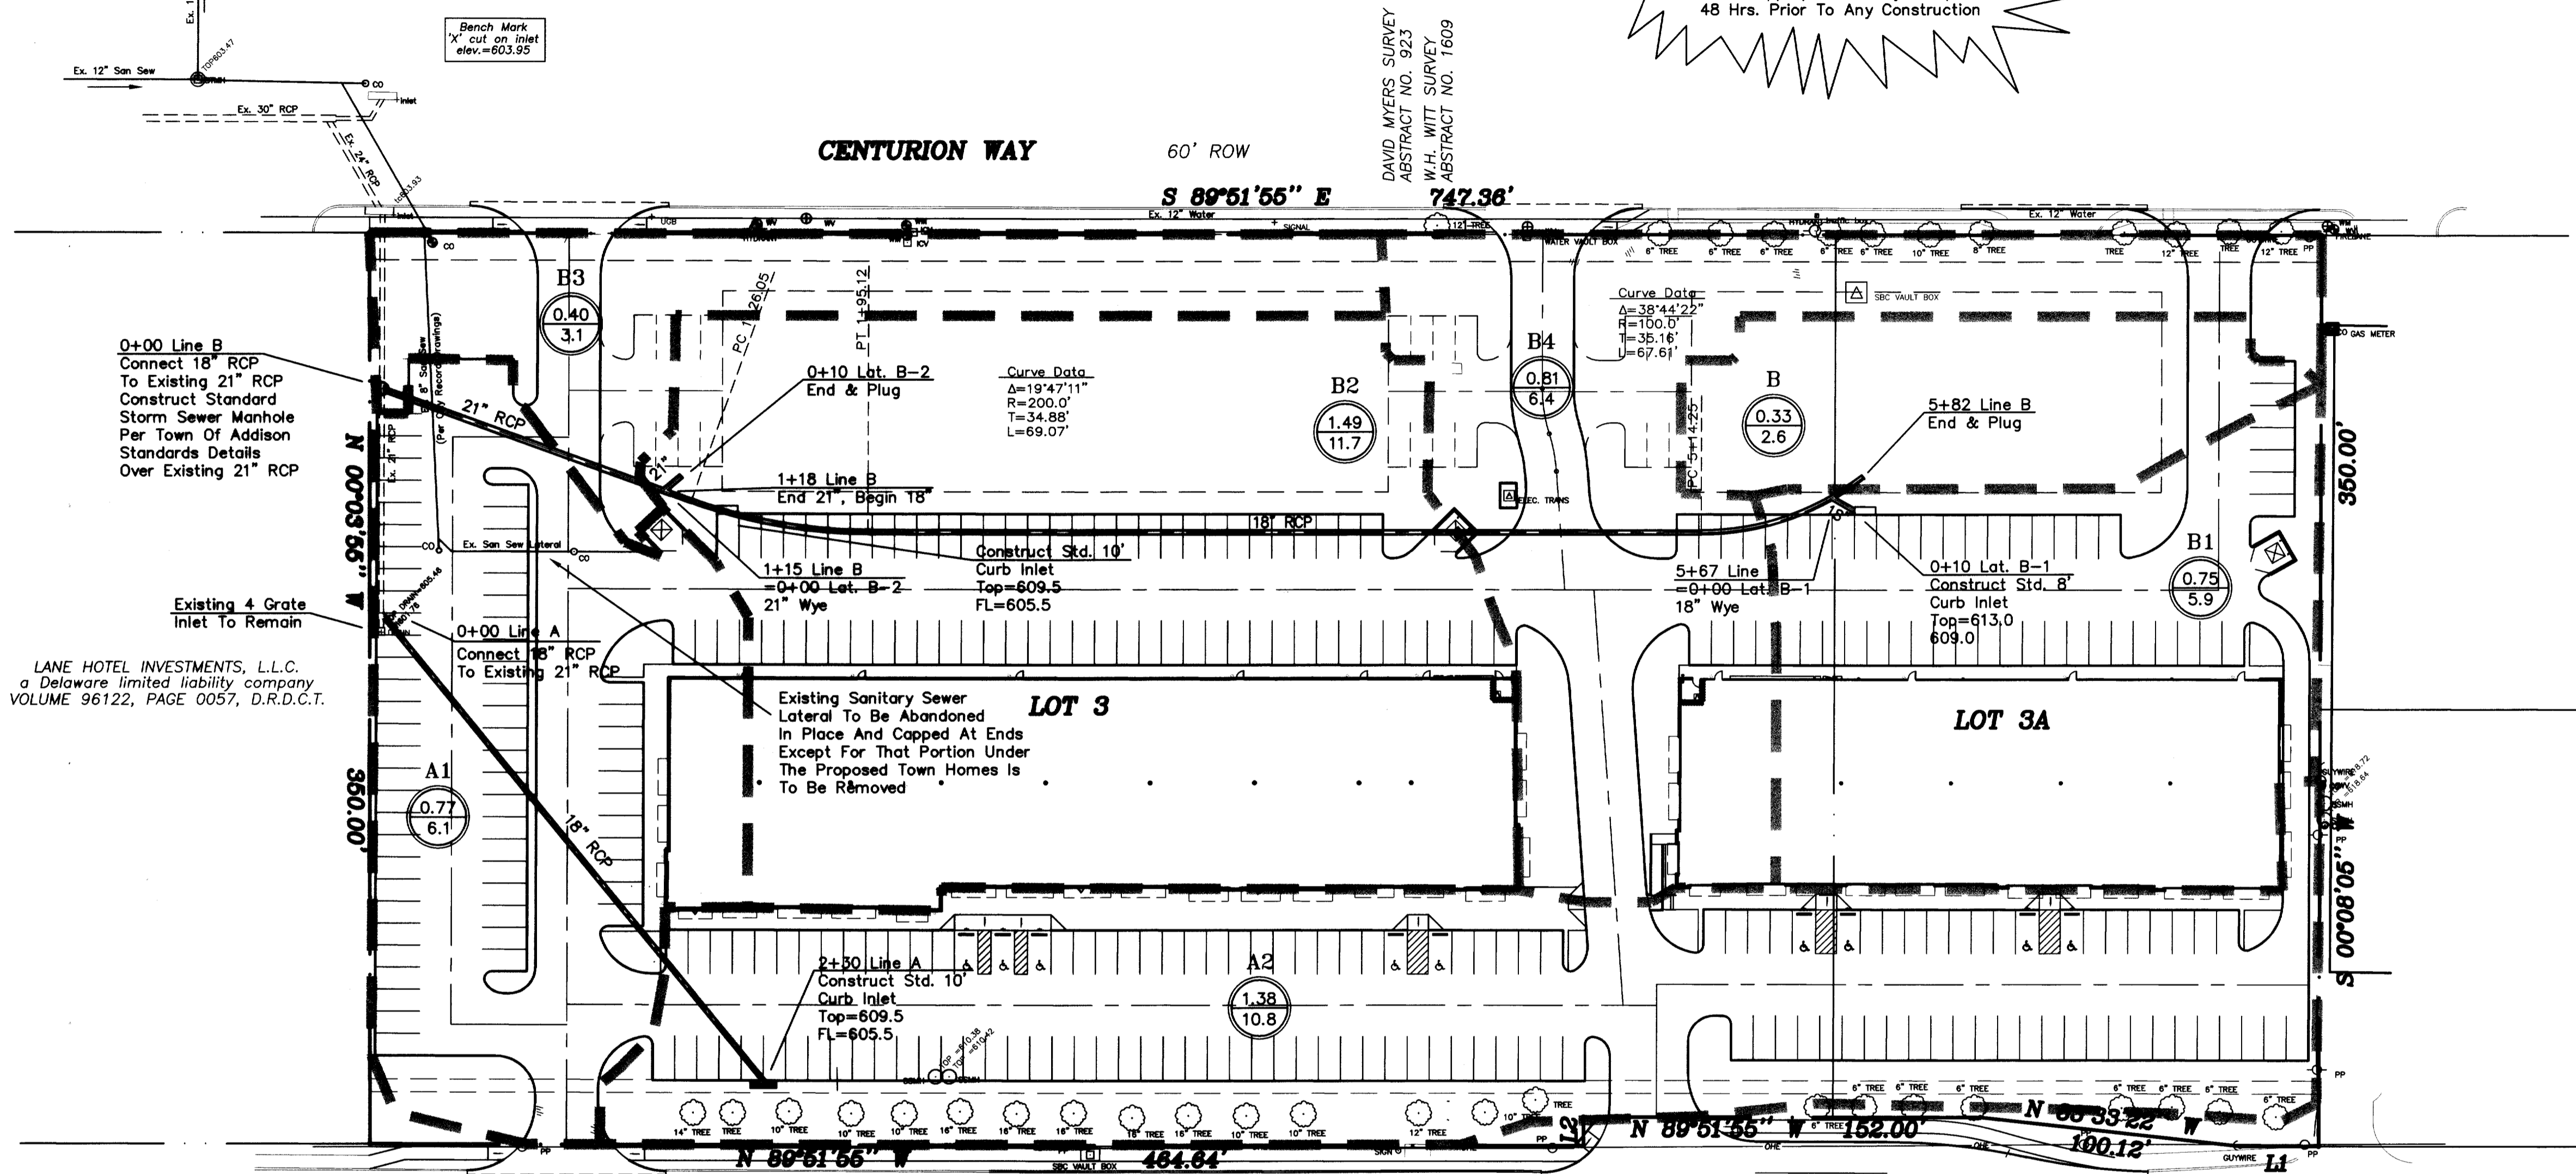

LANE HOTEL INVESTMENTS, L.L.C.
 Delaware limited liability company
 VOLUME 96122, PAGE 0057, D.R.D.C.T.


DAVID MYERS SURVEY
 ABSTRACT NO. 923
 W.H. WITT SURVEY
 ABSTRACT NO. 1609

General Notes

- All materials and construction shall be in accordance with the Town of Addison Standard Specifications and Construction Standards, and Standard Specifications for Public Works Construction prepared by North Central Texas Council of Governments (Latest Revision).
- Existing utilities are shown schematically and are for the contractor's guidance only. The location and/or elevation of existing utilities as shown on these plans are based on records of the various utility companies, and, where possible, measurements taken in the field. The contractor must call the appropriate utility company at least 48 hours prior to any excavation to request exact field location of utilities.
- The contractor shall be responsible for protecting all existing improvements in the construction of this project. The contractor is responsible for repairs of damage to any existing improvements during construction. Repairs shall be equal to or better than condition prior to construction.
- All storm sewer pipe 18" and larger shall be Class III RCP. All storm sewer pipe 15" and smaller shall be HDPE drainage pipe or approved equal.
- Contractor shall be responsible for maintaining trench safety requirements in accordance with the latest standards of O.S.H.A. or any other agency having jurisdiction for excavation and trenching procedures. Contractor shall provide and implement a trench safety plan complying with O.S.H.A.

DRAINAGE CRITERIA

$Q = C I A$
 $C = 0.9$
 $I_{100} = 8.74$
 $t_c = 10 \text{ min.}$

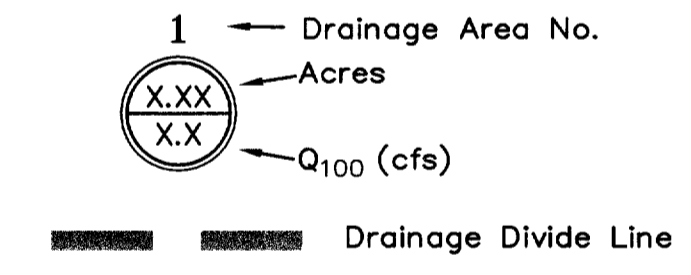

DRAINAGE AREA CALCULATIONS

| Drainage Area No. | Drainage Area (Acres) | C | t _c (min) | I ₁₀₀ (in/hr) | Q ₁₀₀ (cfs) | Notes |
|-------------------|-----------------------|-----|----------------------|--------------------------|------------------------|-------|
| A1 | 0.55 | 0.9 | 10 | 8.74 | 4.3 | |
| A2 | 1.38 | 0.9 | 10 | 8.74 | 10.8 | |
| B | 0.33 | 0.9 | 10 | 8.74 | 2.6 | |
| B1 | 0.75 | 0.9 | 10 | 8.74 | 5.9 | |
| B2 | 1.49 | 0.9 | 10 | 8.74 | 11.7 | |
| B3 | 0.40 | 0.9 | 10 | 8.74 | 3.1 | |
| B4 | 0.81 | 0.9 | 10 | 8.74 | 6.4 | |

!!! CAUTION !!!
 Existing Private Utility Lines On Site
 Contractor To Verify Existing Utility Locations
 Field Verify Both Location & Depth
 Visibly Mark All Existing Utilities
 Prior To Any Construction
 These Markings Are To Be Maintained
 And Remain During The Entire
 Construction Process

EXISTING FLOW TO CENTURION WAY

Existing Area Sheet Flowing to System in Centurion Way
 Area = 3.79 Ac
 $C = 0.90$
 $T_c = 10 \text{ min}$
 $I_{100} = 8.74 \text{ in/hr}$
 $Q_{100} = 29.8 \text{ cfs}$

Existing Area to 21" RCP on West Property Line
 Area = 1.91 Ac
 $C = 0.90$
 $T_c = 10 \text{ min}$
 $I_{100} = 8.74 \text{ in/hr}$
 $Q_{100} = 15.0 \text{ cfs}$

Total Existing Flow to Centurion Way =
 Sheet Flow + Run-off to Catch Basin =
 $29.8 + 15.0 = 44.8 \text{ cfs}$

PROPOSED FLOW TO CENTURION WAY

Proposed Area Sheet Flowing to System in Centurion Way
 Areas B3 and B4 = 9.5 cfs

Proposed Area to 21" RCP on West Property Line
 Areas A1, A2, B, B1, B2 = 35.3 cfs

Total Proposed Flow to Centurion Way =
 Sheet Flow + Run-off to Catch Basin =
 $9.5 + 35.3 = 44.8 \text{ cfs}$

Total Existing Flow to Centurion Way (44.8 cfs) =
 Proposed Flow to Centurion Way (44.8 cfs)
 Therefore, Total Run-off to Centurion Way is Unchanged

However, Sheet Flow to Centurion Way has been reduced
 (30.6 cfs to 9.5 cfs) by 21.1 cfs. Run-off to existing 21"
 RCP at West Property Line has been increased to reduce
 gutter flow in Centurion way.

RECORD DRAWING
 REVISED TO CONFORM TO CONSTRUCTION RECORDS


Ronny Klingbeil, P.E.
 Date: 11/3/07

| NUMBER | DIRECTION | DISTANCE |
|--------|---------------|----------|
| L1 | N 89°51'55" W | 30.00' |
| L2 | S 00°08'05" W | 11.00' |

| MISC. INFORMATION | REVISION | DATE | DESCRIPTION |
|---|----------|------|-------------|
| NOTE: Prior to beginning any construction or construction staking, it shall be the Contractor's responsibility to contact the civil engineer to insure that all parties are in possession of the most current set of construction documents. | | | |



RLK ENGINEERING, LLC
 111 West Main
 Allen, Texas 75013
 (972) 359-1733 Off
 (972) 359-1833 Fax

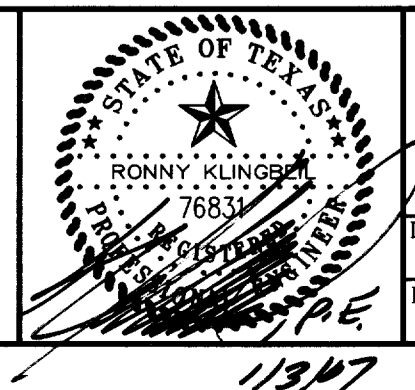

DRAINAGE PLAN
 ADDISON WEST INDUSTRIAL PARK
 4135 BELT LINE ROAD
 ADDISON, TEXAS

| | | | | |
|---------------------------------|---------------------|---------------------------------|----------------------------|--------------------|
| DESIGNED BY: RLK Engineering | TECH REVIEW: RLK | DRAWING FILE: 04090 DRG2.dwg | DRAWING SCALE: 1" = 40' | SHEET: C 3 OF 8 |
| DRAWN BY: RLK Engineering | PEER REVIEW: RLK | DRAWING DATE: 01/03/07 | PROJECT NUMBER: 04090 | |