

STORM SEWER LINE B

**RECORD
DRAWING**

REVISED TO CONFORM TO
CONSTRUCTION RECORDS

Ronny Klingbeil, P.E.

Date 1/31/07


MISC. INFORMATION

NOTE:


Prior to beginning any construction or construction staking, it shall be the Contractor's responsibility to contact the civil engineer to insure that all parties are in possession of the most current set of construction documents.

CITY BENCHMARK
SQUARE CUT ON INLE NORTHEAST CORNER
OF INTERSECTION BELTLINE AND MIDWAY
ELEV. 627.93

REVISION	DATE	DESCRIPTION

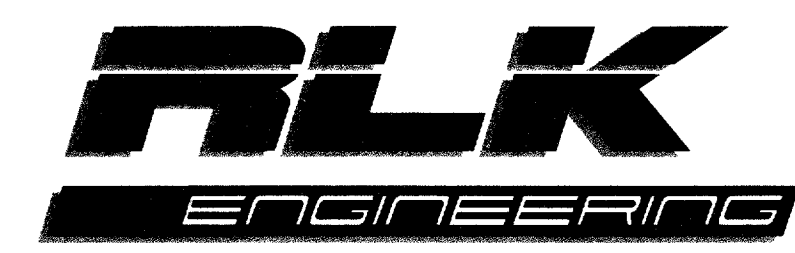

RLK ENGINEERING, LLC
111 West Main
Allen, Texas 75013
(972) 359-1733 Off
(972) 359-1833 Fax

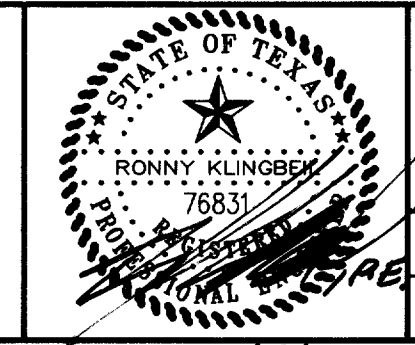

STORM SEWER PROFILE
ADDISON WEST INDUSTRIAL PARK
4135 BELT LINE ROAD
ADDISON, TEXAS

DESIGNED BY: RLK Engineering	TECH REVIEW: RLK	DRAWING FILE: 04090 DETAILS.dwg	DRAWING SCALE: 1" = 40'
DRAWN BY: RLK Engineering	PEER REVIEW: RLK	DRAWING DATE: 01/03/07	PROJECT NUMBER: RLK 04090

SHEET: **C 4** OF 8

1/31/07