


BM# 72 - cut set (3-2016) on the southeast corner of a concrete curb inlet located on the east side of Runyun Road approximately 80 feet south of the centerline of Belt Line Road.
Elev. = 606.23

BM# 73 - cut set (3-2016) on the northwest corner a recessed concrete curb inlet located at the easterly terminus of Runyun Road approximately 400 feet south of the centerline of Belt Line Road.
Elev. = 615.05

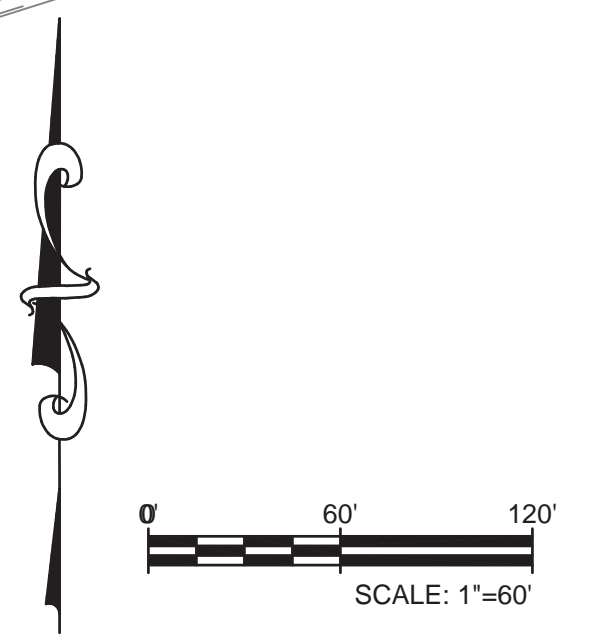

NO.	REVISION	BY	DATE

**TOWN OF ADDISON
DALLAS COUNTY, TEXAS**
 IMPROVEMENT PLANS
 ADDISON GROVE
 OVERALL PLAN & PROJECT CONTROL

SAWYER ENGINEERING, LLC
 1520 OLIVER STREET
 HOUSTON, TEXAS 77007
 TBPE: F-9171 (832) 553-5948

PROJECT	DESIGN	DRAWN	DATE	FILE	SHEET
	CDP	JDS	MAY 2017		2