
## DRAINAGE AREA COMPUTATIONS - SYSTEM B

## STORM PROFILES - SYSTEM B

## COMPUTATIONS FOR STORM DRAINS SYSTEM B ADDISON GROVES

				Sf Q cap Q 100 V 100 H v												O Avail	Delta O	Q reg	Street / Alley	/					HE	AD LOSS AT	CHANGE	N SECTION			IIE	Elev Differ	rence								
FROM	то	AREA	TOTAL AREA	С	Тс	I <sub>10</sub>	<b>Q</b> <sub>10</sub>	I <sub>100</sub>	<b>Q</b> <sub>100</sub>	FROM	то	SLOPE	DESIGN Q	<b>Q</b> <sub>100</sub>	ACTUAL V	VELOCITY HEAD	FROM	то	Q <sub>10</sub>	REA	LINE		Q <sub>100</sub>	Qdesign Q10	- Q100 -	Delta Q Q avail		Frictional Slope	UPST. H.G.L.	DNST. H.G.L. (F	V1 low In) (F	V2 Flow Out)					of Hj2	Hj Elev o	of Hyd	TC - HG	GL
MH 200	MH 202	(AC) 0.23	(AC) 0.23	0.88	(MIN) 10.00	(IN/HR) 6.54	(CFS) 1.33	(IN/HR) 9.27	(CFS) 1.89	MH 200	MH 202	(%) 0.177	(CFS)	(CFS) 1.89	(FPS) 1.07	(FT) 0.02	MH 200	MH 202				(CFS			(CFS) 0.56	(CFS) -2.54	(CFS) 81.63	(FT / FT) 0.0003	(FT) 617.20		(fps)		(fps) (fps	os) (const)	0.02					(FT) (I	
202	202	0.00	0.23	0.88	10.33	6.47	1.33	9.17	1.87	202	202	0.177	4.4	1.87	1.07	0.02	202	202				4.4			0.54	-2.56	75.98	100	617.01		1.07		0.02 0.0		0.02	10					7.35
204	205	0.00	0.51	0.88	10.65	6.40	2.86	9.08	4.05	204	205	0.177	4.4	4.05	2.29	0.08	204	205			20 18	9.7		6.80	1.20	-5.60	119.84	-	616.07	-	1.06	2.29	0.08 0.0	=	0.08	1 3					7.70
205	206	0.00	1.04	0.88	11.02	6.32	5.77	8.97	8.19	205	206	0.177	4.4	8.19	4.64	0.33	205	206	5.77	7 49	9 21	23.6	8.19	17.79	2.42	-15.37	45.63	0.0027	615.38	615.25	2.29	3.41	0.18 0.0	08 0.36	0.15	0.10	0.01 0	).16 61	15.41 62	622.11 6	6.70 Ma
206	207	0.00	1.47	0.88	11.10	6.30	8.17	8.95	11.61	206	207	0.177	4.4	11.61	6.57	0.67	206	207	8.17	7 130	30 24	7.9	11.61	-0.28	3.43	3.72	76.28	0.0027	615.25	614.91	3.41	3.69	0.21 0.1	18 0.30	0.16	0.10	0.02 0	).18 61	15.09 62	621.64 6	6.55 Ma
207	208	0.00	2.48	0.88	11.96	6.13	13.35	8.71	18.99	207	208	0.177	4.4	18.99	10.74	1.79	207	208	13.35	5 50	0 30	12.3	18.99	-1.02	5.64	6.65	35.91	0.0022	614.91	614.80	3.69	3.87	0.23 0.2	21 0.10	0.02		(	).02 61	14.83 62	620.36 5	5.53
208	210	0.00	2.48	0.88	12.30	6.06	13.35	8.63	18.80	208	210	0.177	4.4	18.80	10.64	1.76	208	210	13.35	5 85	5 30	12.3	3 18.80	-1.02	5.45	6.46	51.45	0.0021	614.80	614.63	3.87	3.83	0.23 0.2	23 0.70	0.16		C	0.16 614	14.79 62	620.65 5	5.86
210	212	0.00	2.97	0.88	12.86	5.96	15.58	8.48	22.19	210	212	0.177	4.4	22.19	12.56	2.45	210	212	15.58	8 118	18 33	14.0	22.19	-1.55	6.61	8.16	100.53	0.0018	614.63	614.42	3.83	3.74	0.22 0.2	23 0.10	0.02		C	).02 614	14.44 62	620.91 6	6.47
212	214	0.00	4.03	0.88	13.69	5.81	20.58	8.28	29.34	212	214	0.177	4.4	29.34	16.60	4.28	212	214	20.58	8 66	6 36	17.7	7 29.34	-2.89	8.76	11.65	29.83	0.0019	614.42	614.29	3.74	4.15	0.27 0.2	22 0.10	0.02		C	0.02 614			7.28
214	216	0.00	4.03	0.88	14.13	5.73	20.58	8.18	28.98	214	216	0.177	4.4	28.98	16.40	4.18	214	216	_	_	5 36	17.7	_	-2.89	8.40	11.29	21.34	-	614.23		4.15		0.26 0.2		0.12						7.72
216	218	0.00	7.47	0.88	14.36	5.69	37.41	8.13	53.40	216	218	0.177	4.4	53.40	30.22	14.18	216	218		9		161.0			15.99	-107.60	50.71	777777	611.39	***************************************	4.10		0.28 0.2		0.06		0.18 0	24.			0.81
218	219	0.38	9.81	0.88	14.69	5.64	48.68 50.45	8.05 8.04	69.50 72.05	218	219	0.177 0.177	4.4	69.50 72.05	39.33 40.77	24.02 25.81	218	219			3 60	200 - 200 -		212.42	20.83	-191.60 -189.05	234.99	4,00,000,000	610.88 610.83		4.25 3.54		0.19 0.2 0.21 0.1	28 0.10 19 0.30	0.03	-					7.47 6.09
220	222	0.00	10.19	0.88	14.81	5.62	50.45	8.03	71.97	220	222	0.177	4.4	71.97	40.77	25.75	220	222	5.7000 Bee	and a second				-0.91	21.52	22.43	553.83		CHARGE EXILE	E. MORE CONTRACTOR	3.67	100000000	0.21 0.1	200-	0.15			2 4332		o etc. occur	5.74
222	118	0.00	10.19	0.88	16.04	5.43	50.45	7.77	69.63	220		0.177	71	71.07	40.70	20.70	222	118		_					19.18		4495.10		610.66	111	3.67		0.09 0.2		0.01					616.55 5	14
								<u> </u>		inlet 350	205	0.177	4.4	1.89	1.07	0.02	1 1							1																	
inlet 350	205	0.14	0.14	0.88	10.00	6.54	0.80	9.27	1.13								inlet 350	205	0.80	29	9 18	4.4	1.13	3.63	0.33	-3.30	73.52	0.0001	615.88	615.88	-	0.64	0.01 -	1.25	0.01	1	0	0.01 615	15.89 62	622.54 6	.65
										224	226	0.177	4.4	0.95	0.54	0.00	224	226	0.67	7 45	5 18	12.9	0.95	12.23	0.28	-11.94	94.44	0.0001	618.34	618.34	-	0.54	0.00 -	1.25	0.01		ľ	0.01 618	18.34 62	325.01	3.67
224	226	0.12	0.12	0.88	10.00	6.54	0.67	9.27	0.95	226	204	0.177	4.4	2.24	1.27	0.02	226	204	1.58	3 51	1 18	16.4	1 2.24	14.84	0.66	-14.18	88.26	0.0005	617.02	617.00	0.54	1.27	0.02 0.0	JO -	0.02		(	0.02 617	17.02 62	624.36 7	7.34
226	204	0.16	0.28	0.88	10.10	6.52	1.58	9.24	2.24								222	234	2.51	. 52	3 18	4.4	3.56	1.92	1.05	-0.87	65.80	0.0012	617.95	617 90		2.01	0.06 -	- 1.25	0.08			0.08 617	17.97 62	622.10 4	4 12
								-		232	234	0.177	4.4	3.56	2.01	0.06	232	206	_	-				1	1.03	-0.91	58.36	1	-	615.25	2 01		0.06 0.0		0.00			- 111		622.47 7	
232	234	0.44	0.44	0.88	10.00	6.54	2.51	9.27	3.56	234	206	0.177	4.4	3.52	1.99	0.06																									
234	206	0.00	0.44	0.88	10.35	6.46	2.51	9.17	3.52					4.00			236	238	1.36	3 132	32 18	4.4	1.93	3.07	0.57	-2.50	PARK	-	615.09		-		0.02 -	- 1.25		-	0			618.00 2	<u> </u>
226	220	0.24	0.24	0.00	10.00	6.54	1.36	0.27	1.02	236	238 inlet 354	0.177 0.177	4.4	1.93 3.75	1.09	0.02	238	inlet 3	_	_		-			1.11	-0.69	PARK	<u>-</u>	615.05		- <u>- u</u>		0.07 0.0	7.0	0.06			_		618.00 2	
236	238 inlet 354		0.24	0.88	10.88	6.35	2.64	9.27	1.93 3.75	inlet 354	207	0.177	4.4	5.01	2.83	0.12	inlet 354	207	3.52	2 28	8 18	4.4	5.01	0.91	1.48	0.57	46.59	0.0023	614.97	614.91	2.12	2.83	0.12 0.0	-	0.07			0.07 614	14.98 62	20.08 5	.10
inlet 354	207	0.17	0.64	0.88	11.27	6.27	3.52	8.90	5.01		201	0.177		0.01	2.00	0.12	inlet 356	207	2.09	15	5 18	4.4	2.97	2.34	0.87	-1.46	46.04	0.0008	614.92	614.91	-	1.68	0.04 -	- 1.25	0.05		C	0.05 614	14.97 62	520.08	j.11
Manager Selection C. P.	100000	Control of all of			Sales of Charles		2000000000	A SARSON AT C.S.	WHITE CORES AT	inlet 356	207	0.177	4.4	2.97	1.68	0.04	240	242	0.31	1 32	2 18	4.4	0.44	4.12	0.13	-3.99	72.24	0.0000	615.29	615 20	_	0.25	0.00 -	- 1.25	0.00			0.00 615	15.29 62	622.16 6	3.87
inlet 356	207	0.36	0.36	0.88	10.00	6.54	2.09	9.27	2.97								242	244		7	2000			C.Manusco	0.13	-2.68	153.27		615.04		0.25		0.02 0.0		0.00			_		621.87 6	
						1				240	242	0.177	4.4	0.44	0.25	0.00	244	246							1.16	-0.50	53.59			614.84			0.08 0.0		0.07		-			621.81 6	10
240	242	0.05	0.05	0.88	10.00	6.54	0.31	9.27	0.44	242	244	0.177	4.4	1.75	0.99	0.02	246	210	2.77	7 31	1 18	10.5	5 3.90	7.76	1.13	-6.63	41.15	0.0014	614.67	614.63	2.23	2.21	0.08 0.0	08 -	0.00		(	0.00 614	14.62 62	321.67 7	7.05
242	244	0.16	0.22	0.88	10.21	6.49	1.23	9.21	1.75	244	246	0.177	4.4	3.93	2.23	0.08																									
244	246	0.28	0.50	0.88	10.87	6.35	2.77	9.01	3.93	246	210	0.177	4.4	3.90	2.21	0.08	248	250 252				12.0			0.23	-3.65 -10.53	108.98		619.62 617.74		0.44		0.00 -	1.25	0.00		_			625.88 6 626.76 9	3
246	210	0.00	0.50	0.88	11.14	6.29	2.77	8.94	3.90		0.50			0.70			252	254	1 5,110,50					17007 0017 17	Particular Control	-7.72	157.90	Production of the Control of the Con	COLUMN PROPERTY AND	615.62	17/2.18/24/2		0.08 0.0		0.01					624.37 8	
240	250	0.10	0.10	0.00	10.00	6.54	0.55	9.27	0.78	248 250	250	0.177 0.177	4.4	0.78	0.44	0.00	254	212							2.45	-16.82	48.33	-	614.56		2.27		0.18 0.0		0.15					622.76 8	
248	250 252	0.10	0.10	0.88	10.35	6.46	1.04	9.17	1.48	252	254	0.177	4.4	4.01	2.27	0.01																									
252	254	0.32	0.50	0.88	10.69	6.39	2.82	9.07	4.01	254	212	0.177	4.4	8.30	4.70	0.34	inlet 256	250	0.23	3 18	8 18	4.4	0.33	4.20	0.10	-4.10	55.43	0.0000	614.65	614.65	-	0.18	0.00 -	- 1.25	0.00	1	C	0.00 614	14.65 62	20.08 5	.43
254	212	0.55	1.05	0.88	11.10	6.30	5.84	8.95	8.30								Ex Inlet 1	Ex Inle	et 2 9.21	1 56	6 24	50.9	13.06	41.65	3.85	-37.81	EX	0.0034	617.42	617.23	-	4.16	0.27 -	- 1.25	0.34		(	0.34 617	17.57 62	322.63	5.06
								)		inlet 256	250	0.177	4.4	0.33	0.18	0.00	Ex Inlet 2	2 258	16.30	0 102	02 33	84.3	3 23.11	68.02	6.81	-61.21	PARK	0.0019	615.59	615.40	4.16	3.89	0.24 0.2	27 -	0.08		[	0.08 615	15.48 62	520.90 5	5.42
inlet 256	250	0.04	0.04	0.88	10.00	6.54	0.23	9.27	0.33						II.	П	258	216	19.69	9 71	1 36	87.9	27.91	68.26	8.23	-60.04	49.96	0.0018	614.30	614.17	3.89	3.95	0.24 0.2	24 0.10	0.02		(	0.02 614	14.20 62	521.95 7	.75
										Ex Inlet 1	Ex Inlet 2	0.177	4.4	13.06	7.39	0.85																									
Ex Inlet 1	Ex Inlet 2	1.60	1.60	0.88	10.00	6.54	9.21	9.27	13.06	Ex Inlet 2	258	0.177	4.4	23.11	13.08	2.65																									
Ex Inlet 2	258	1.24	2.84	0.88	10.06	6.53	16.30	9.25	23.11	258	216	0.177	4.4	27.91	15.80	3.87																									
258	216	0.60	3.44	0.88	10.18	6.50	19.69	9.22	27.91																											P					

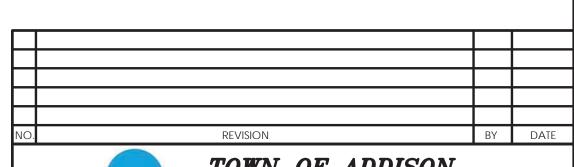

Comments

Inlet at Beginning of Line

Incoming Opposing Flows

Pipe Enlargement

Change in Direction at Manhole

Pipe Enlargement

Pipe Enlargement

Change in Direction at Manhole

Pipe Enlargement + 45° WYE

Pipe Enlargement

Manhole with Lateral

Change in Direction at Manhole

Manhole

Inlet at Beginning of Line

Inlet at Beginning of Line

Inlet

Inlet at Beginning of Line

Inlet

Inlet at Beginning of Line

Inlet

Inlet

Inlet at Beginning of Line

Inlet at Beginning of Line

Inlet at Beginning of Line

Inlet with Multiple Entering Flows

Inlet at Beginning of Line

Inlet at Beginning of Line

Pipe Enlargement

622.11 6.70 Manhole with Lateral + Pipe Enlargement

621.64 6.55 Manhole with Lateral + Pipe Enlargement



TOWN OF ADDISON DALLAS COUNTY, TEXAS

IMPROVEMENT PLANS **ADDISON GROVE** 

DRAINAGE AREA CALCULATIONS -DRAINAGE SYSTEM B

ENGINEERING, LLC TBPE: F-9171 SAWYER

SAWYER ENGINEERING, LLC TBPE FIRM NUMBER F—9171

1520 OLIVER STREET HOUSTON, TEXAS 77007 (832) 553-5948

PROJECT DESIGN DRAWN SHEET MAY 20 CDP JDS