


RUNYON ROAD WEST

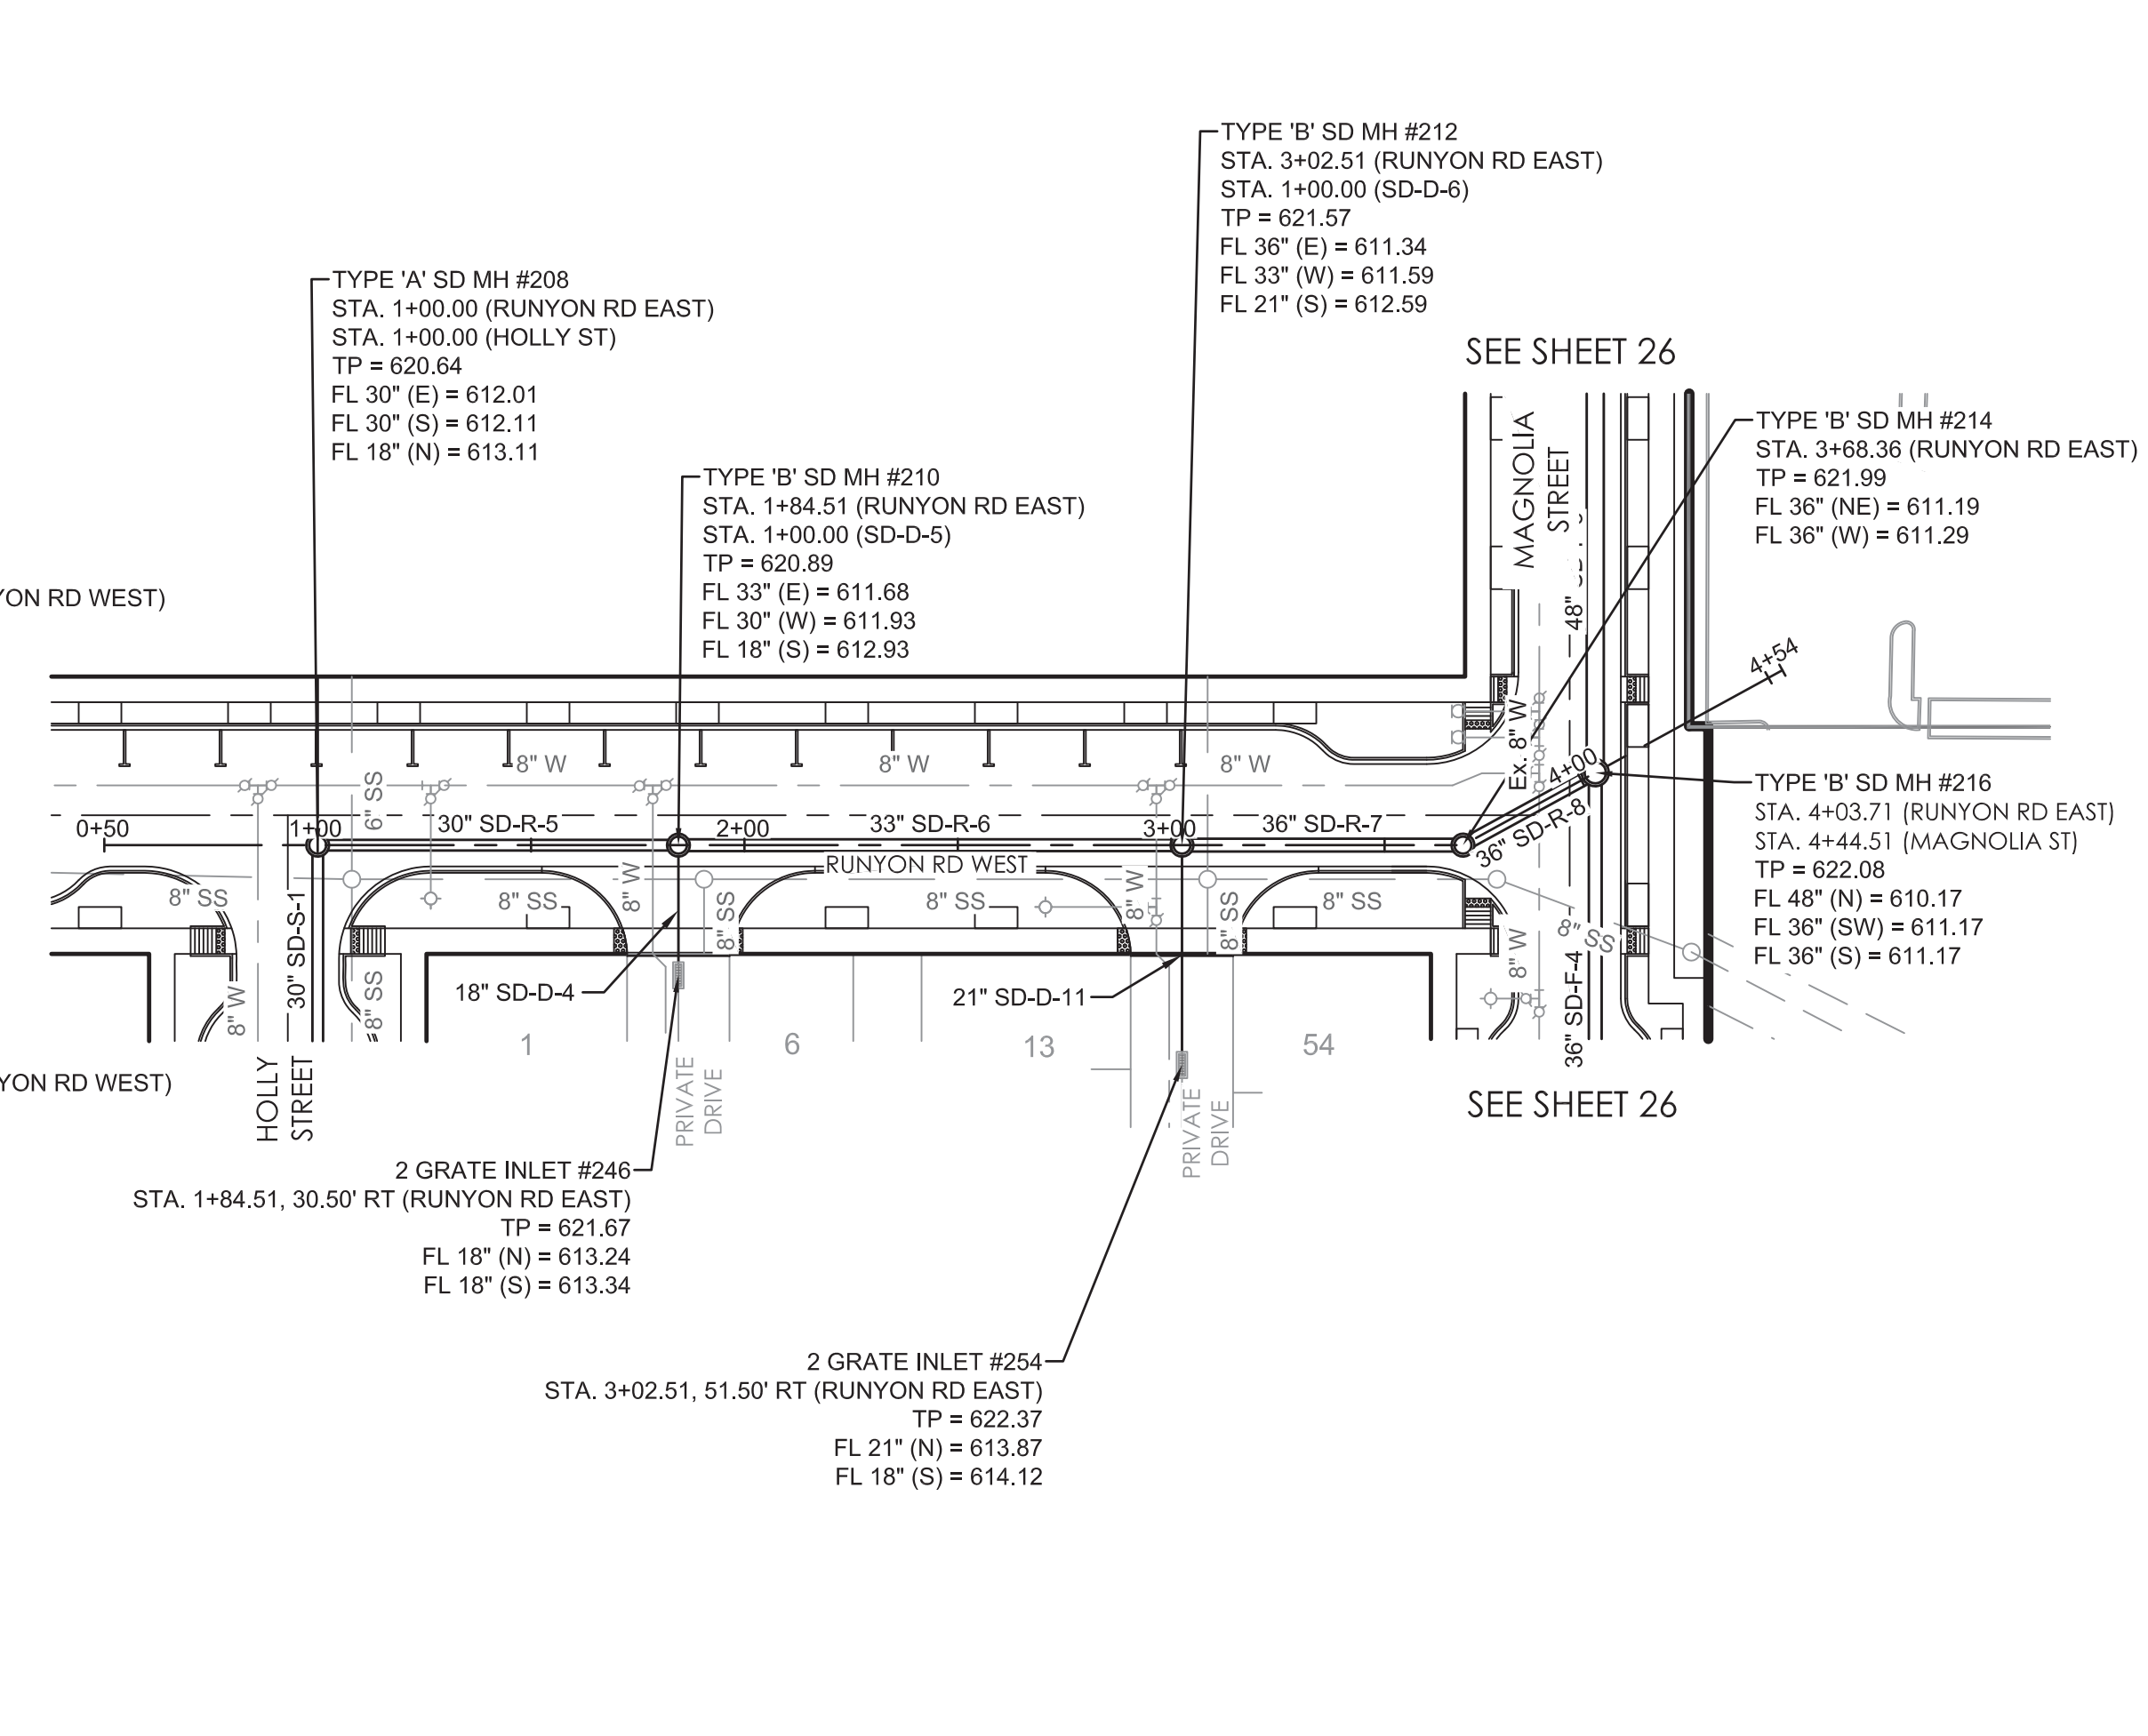

RUNYON ROAD EAST

STORM DRAIN LEGEND



- SANITARY SEWER AND MANHOLE
- SANITARY SEWER AND CLEANOUT
- EXISTING SANITARY SEWER AND MANHOLE
- PROPOSED FIRE HYDRANT ASSEMBLY
- PROPOSED WATERLINE WITH GATE VALVE AND BOX WITH 10' W.L.E.
- EXISTING WATERLINE WITH GATE VALVE AND BOX
- PROPOSED STORM SEWER WITH MANHOLE AND INLETS
- PROPOSED PRIVATE STORM SEWER
- EXISTING STORM SEWER AND MANHOLE
- EXISTING INLET
- PROPOSED TREE WELL
- 2x6 TRUNCATED DOME PANEL

CONTRACTOR TO CONNECT 4" PERFORATED PVC DRAINAGE PIPE TO BACK OF STORM DRAIN INLETS. CONTRACTOR TO DETERMINE FREQUENCY AND LOCATION OF CONNECTIONS TO ALLOW ADEQUATE DRAINAGE OF STRUCTURAL SOIL.



SAWYER ENGINEERING, LLC  
TBPE FIRM NUMBER F-9171

ONE-CALL NOTIFICATION SYSTEM  
CALL BEFORE YOU DIG  
1-800-545-6005  
OR OTHER UTILITY LOCATING SERVICES AT  
LEAST 48 HOURS PRIOR TO  
CONSTRUCTION ACTIVITIES.

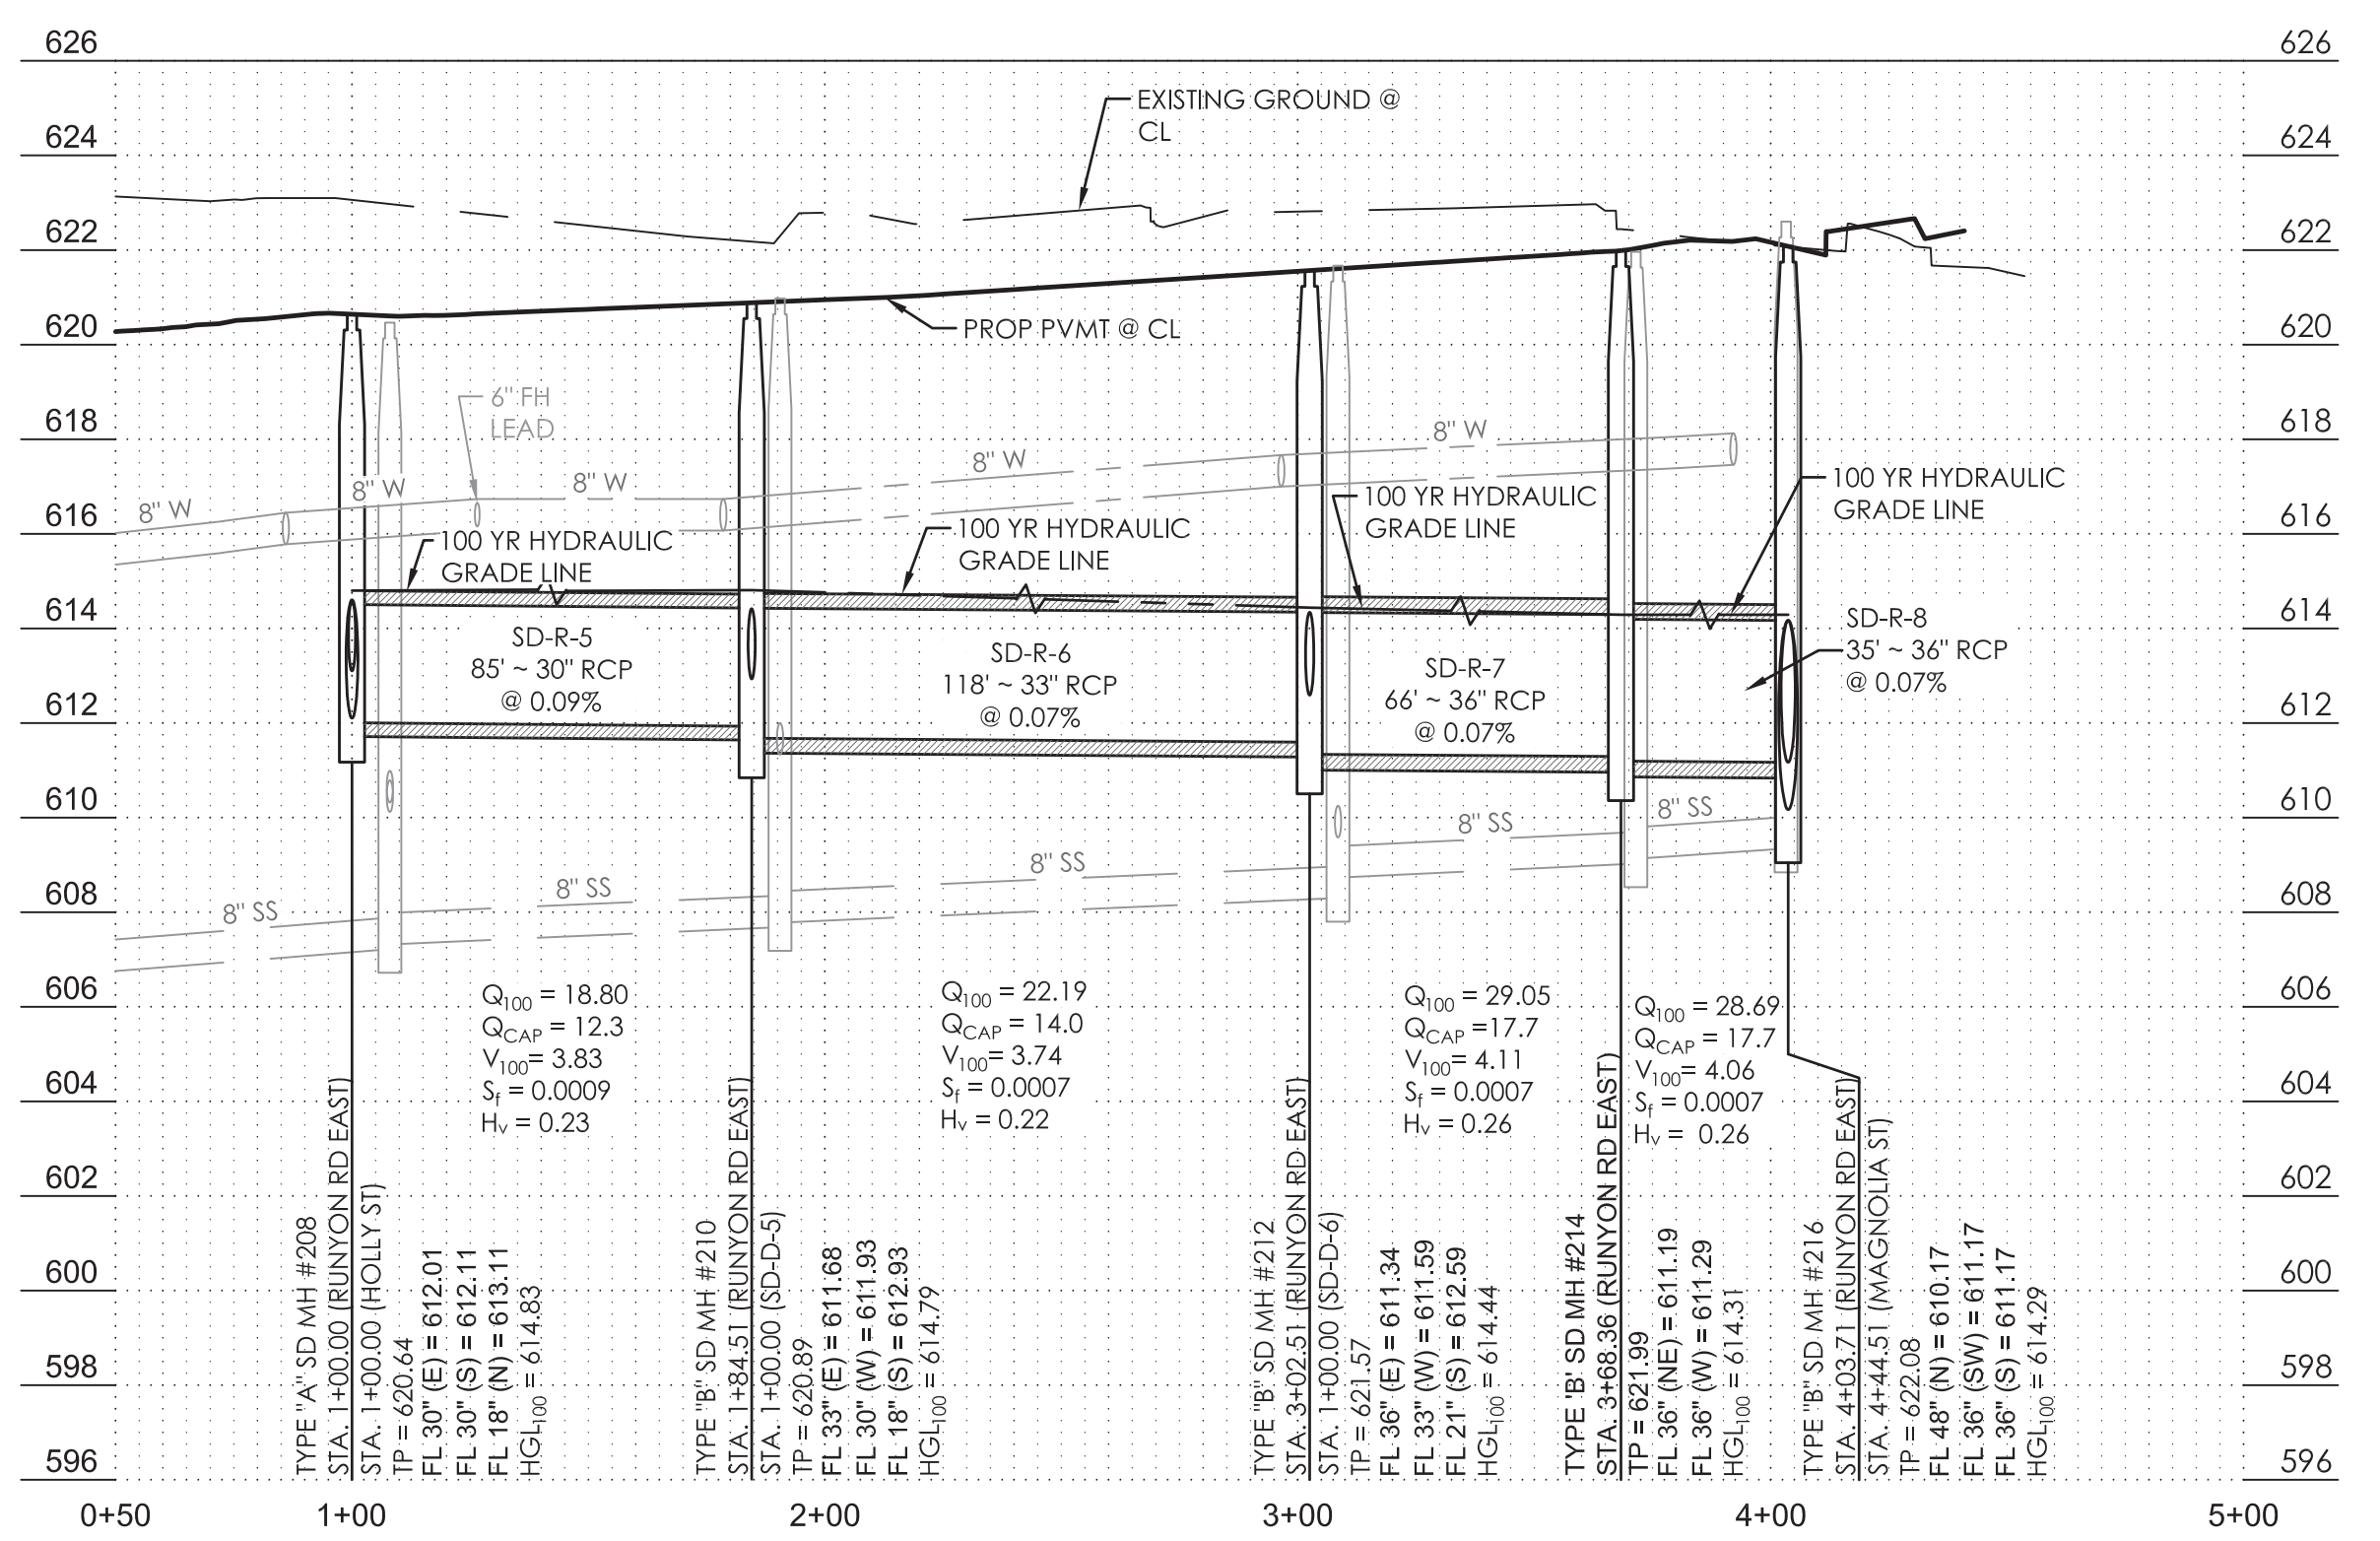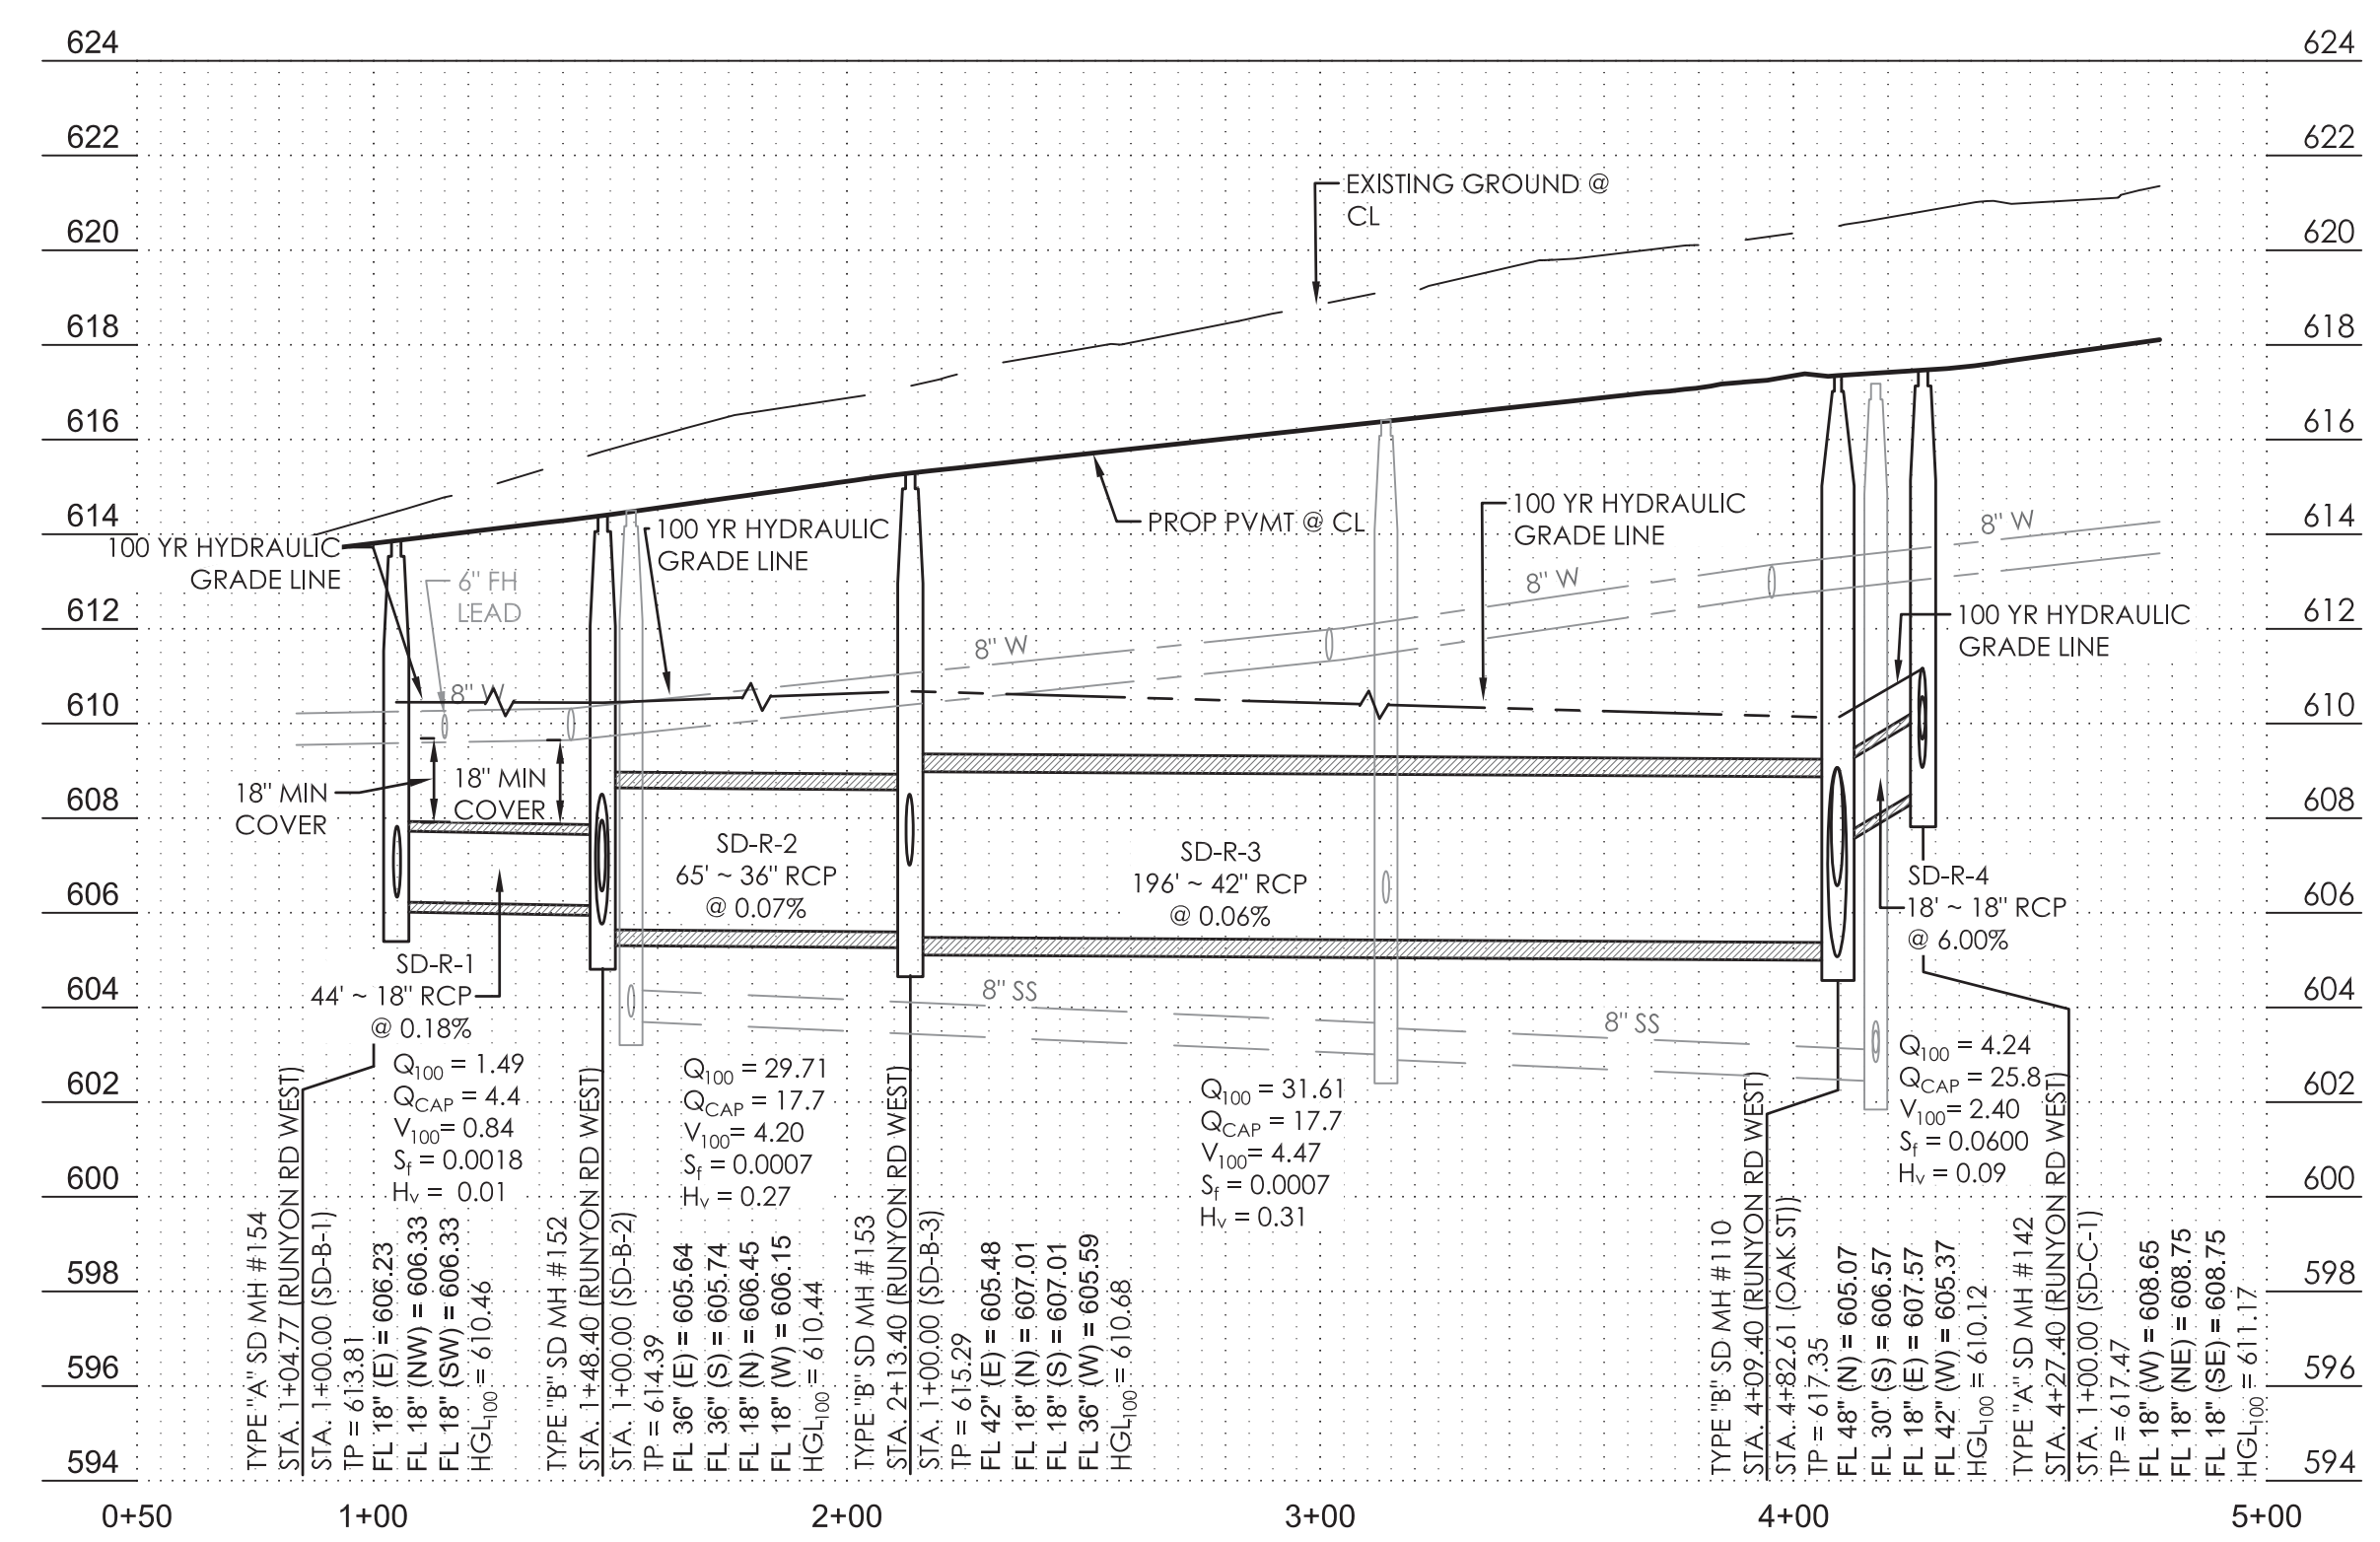

NO.		REVISION	BY	DATE
<b>TOWN OF ADDISON</b> <b>DALLAS COUNTY, TEXAS</b>				
<b>IMPROVEMENT PLANS</b> <b>ADDISON GROVE</b>				
<b>STORM DRAIN PLAN &amp; PROFILE - RUNYON ROAD</b>				
SAWYER		ENGINEERING, LLC TBPE: F-9171	1520 OLIVER STREET HOUSTON, TEXAS 77007 (832) 553-5948	
PROJECT	DESIGN	DRAWN	DATE	FILE
	CDP	JDS	MAY 2017	
				SHEET
				24