

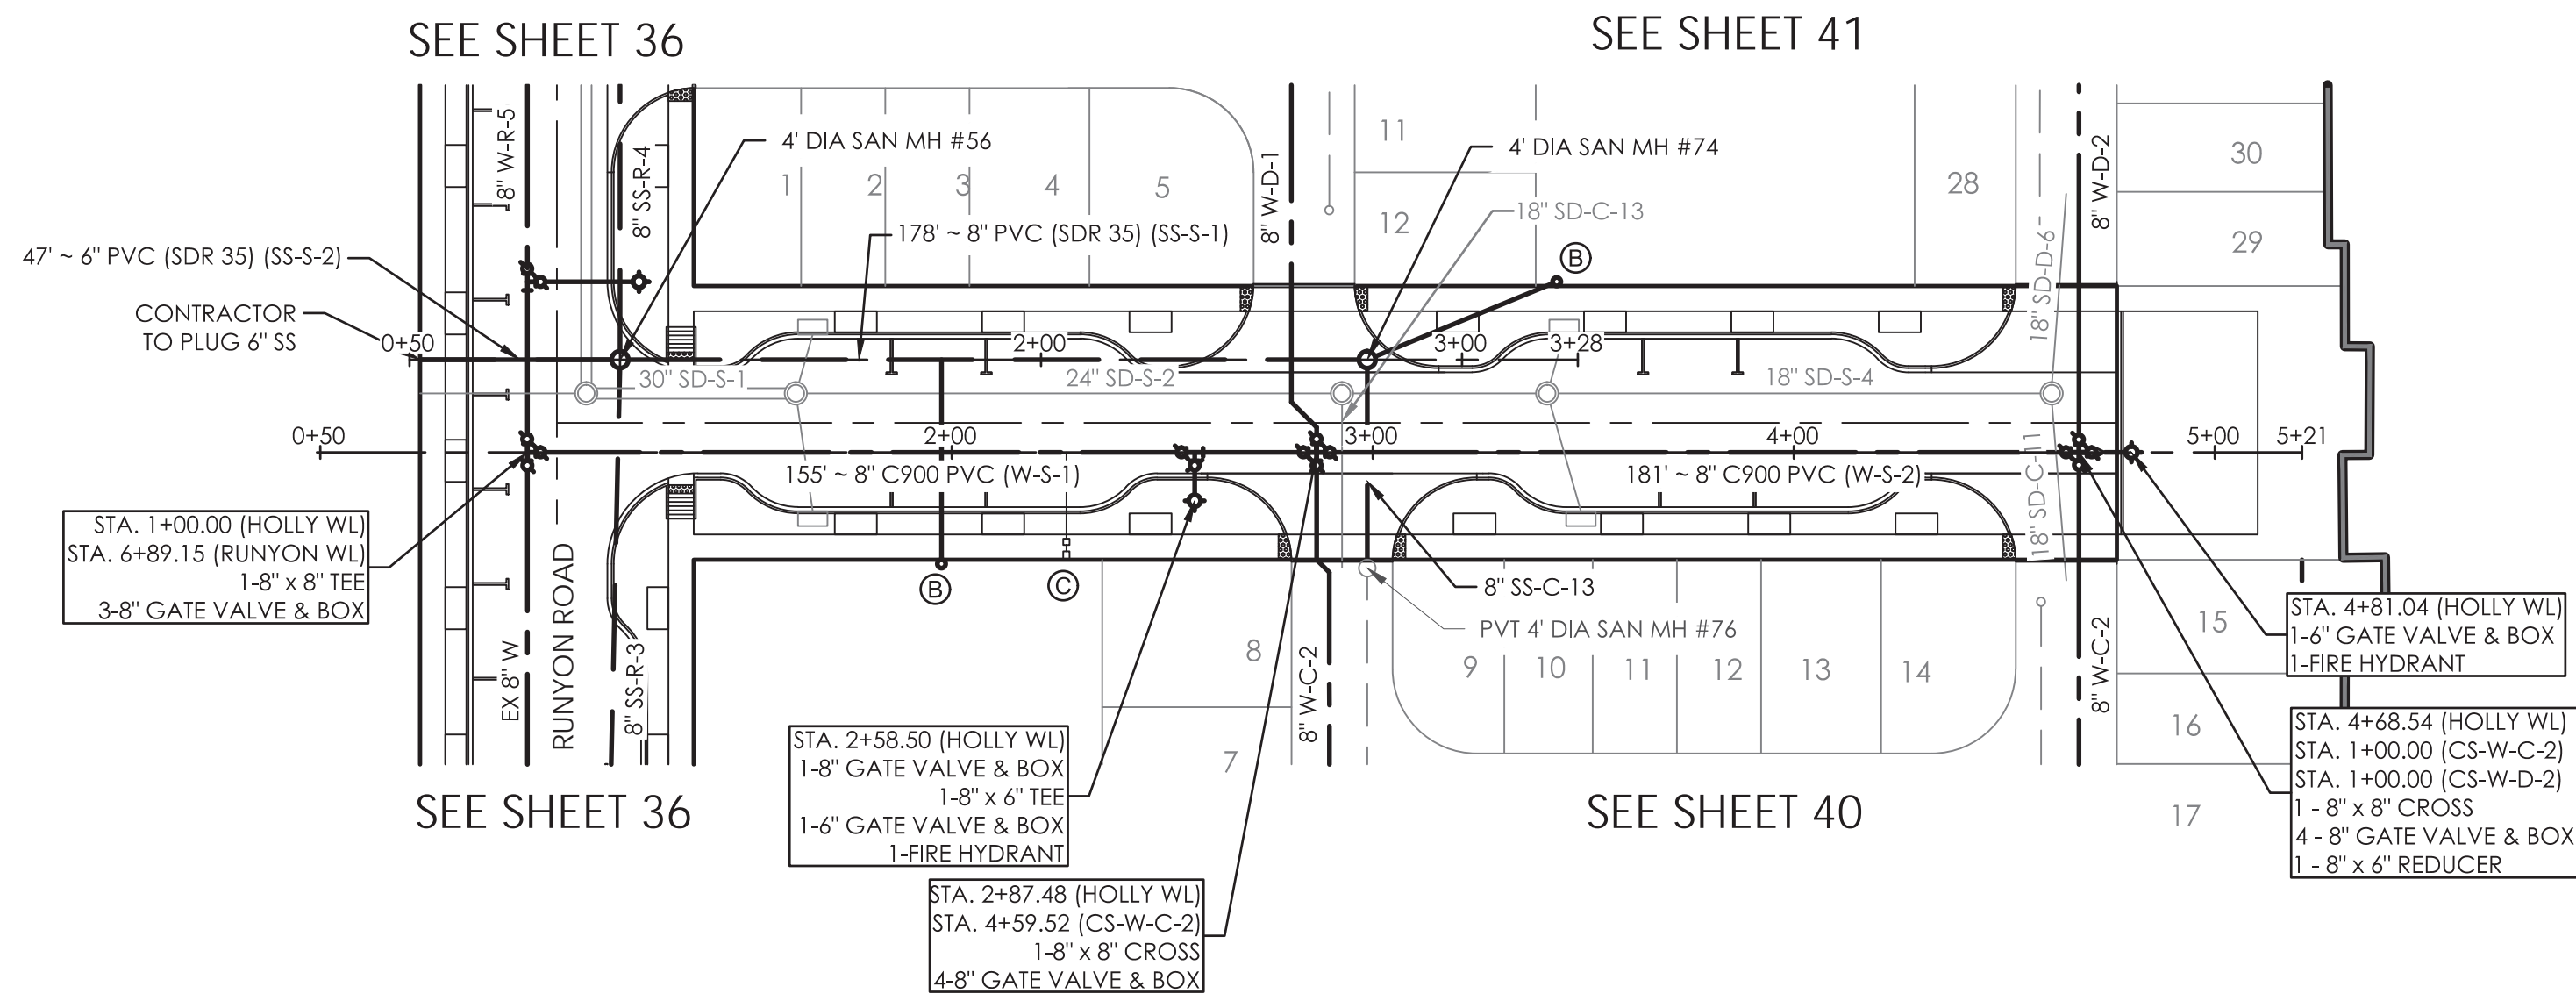


SANITARY SEWER AND WATERLINE LEGEND

- SANITARY SEWER AND MANHOLE
- SANITARY SEWER AND CLEANOUT
- EXISTING SANITARY SEWER AND MANHOLE
- PROPOSED FIRE HYDRANT ASSEMBLY
- PROPOSED WATERLINE WITH GATE VALVE AND BOX WITH 10' W.L.E.
- EXISTING WATERLINE WITH GATE VALVE AND BOX
- PROPOSED STORM SEWER WITH MANHOLE AND INLETS
- PROPOSED PRIVATE STORM SEWER
- EXISTING STORM SEWER AND MANHOLE
- EXISTING INLET
- PROPOSED TREE WELL
- 2x6 TRUNCATED DOME PANEL
-
-

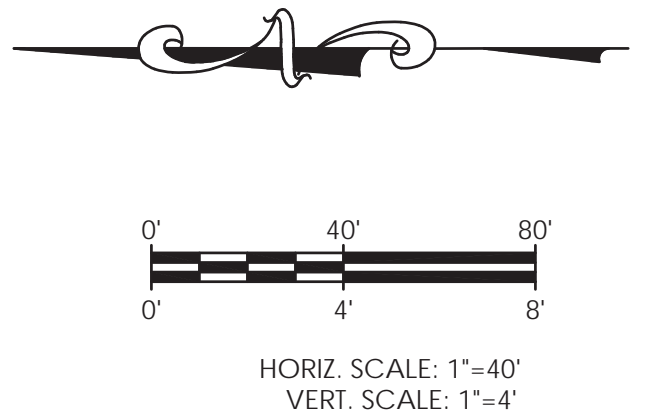

CONSTRUCTION OF SANITARY SEWER AND STORM SEWER WITHIN THE RIGHT-OF-WAY TO BE CONSIDERED PUBLIC UTILITIES INCLUDING THE TRUNK LINE EXTENDING TO THE FIRST MANHOLE OR INLET OUTSIDE THE RIGHT-OF-WAY. THE MANHOLE OR INLET OUTSIDE OF THE RIGHT-OF-WAY IS TO BE CONSIDERED PRIVATE.

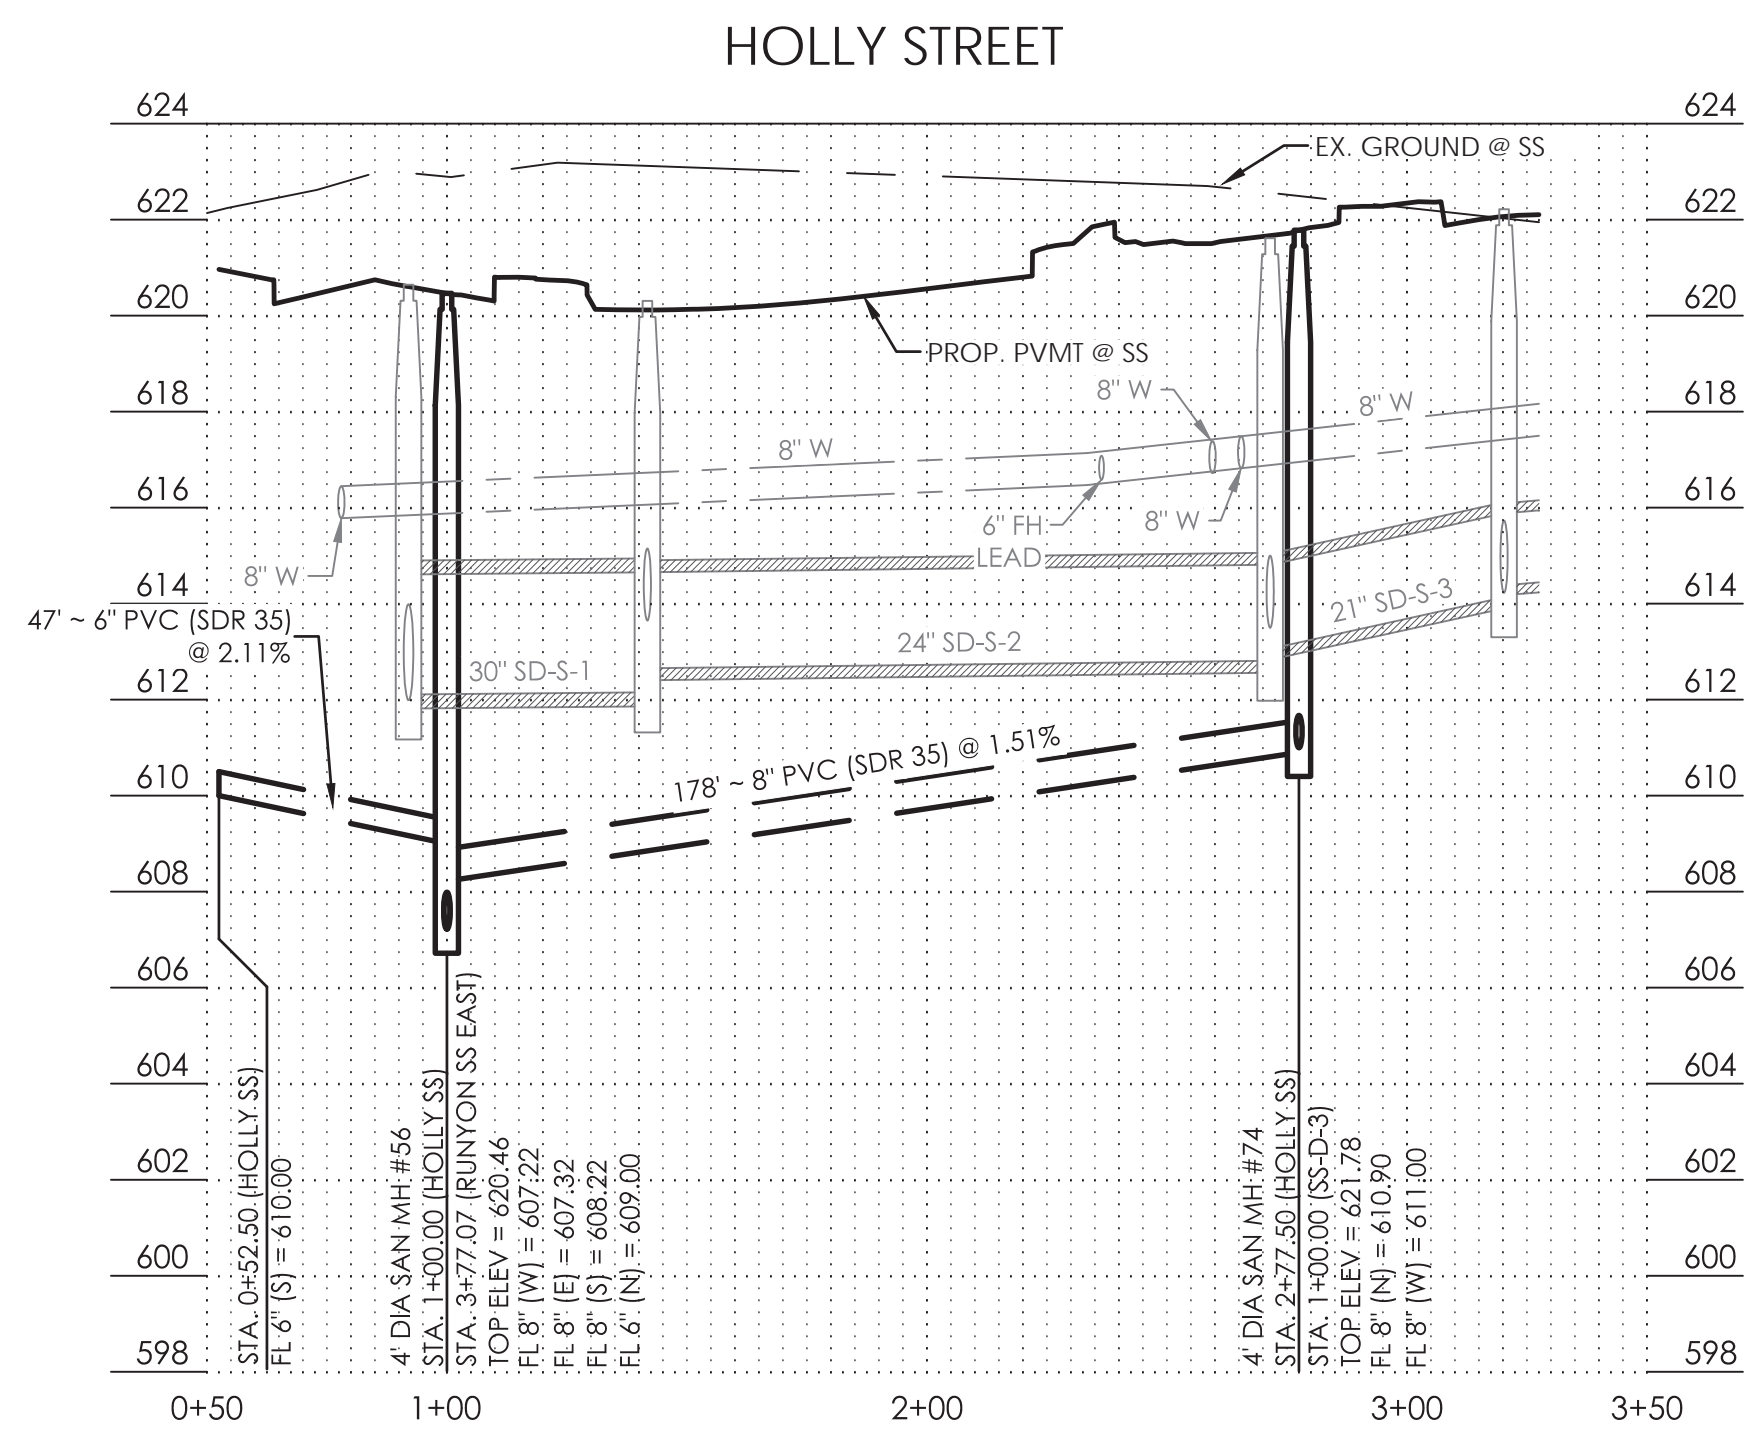

2017/12/22

ONE-CALL NOTIFICATION SYSTEM
CALL BEFORE YOU DIG
 1-800-545-6005
 OR OTHER UTILITY LOCATING SERVICES AT
 LEAST 48 HOURS PRIOR TO
 CONSTRUCTION ACTIVITIES.

NO.	REVISION	BY	DATE
TOWN OF ADDISON DALLAS COUNTY, TEXAS			
IMPROVEMENT PLANS ADDISON GROVE			
WATER LINE AND SANITARY SEWER PLAN & PROFILE - HOLLY STREET			
SAWYER ENGINEERING, LLC TBPE FIRM NUMBER F-9171		1520 OLIVER STREET HOUSTON, TEXAS 77007 (832) 553-5948	
PROJECT	DESIGN	DRAWN	DATE
	CDP	JDS	MAY 2017
FILE	SHEET		
	37		