
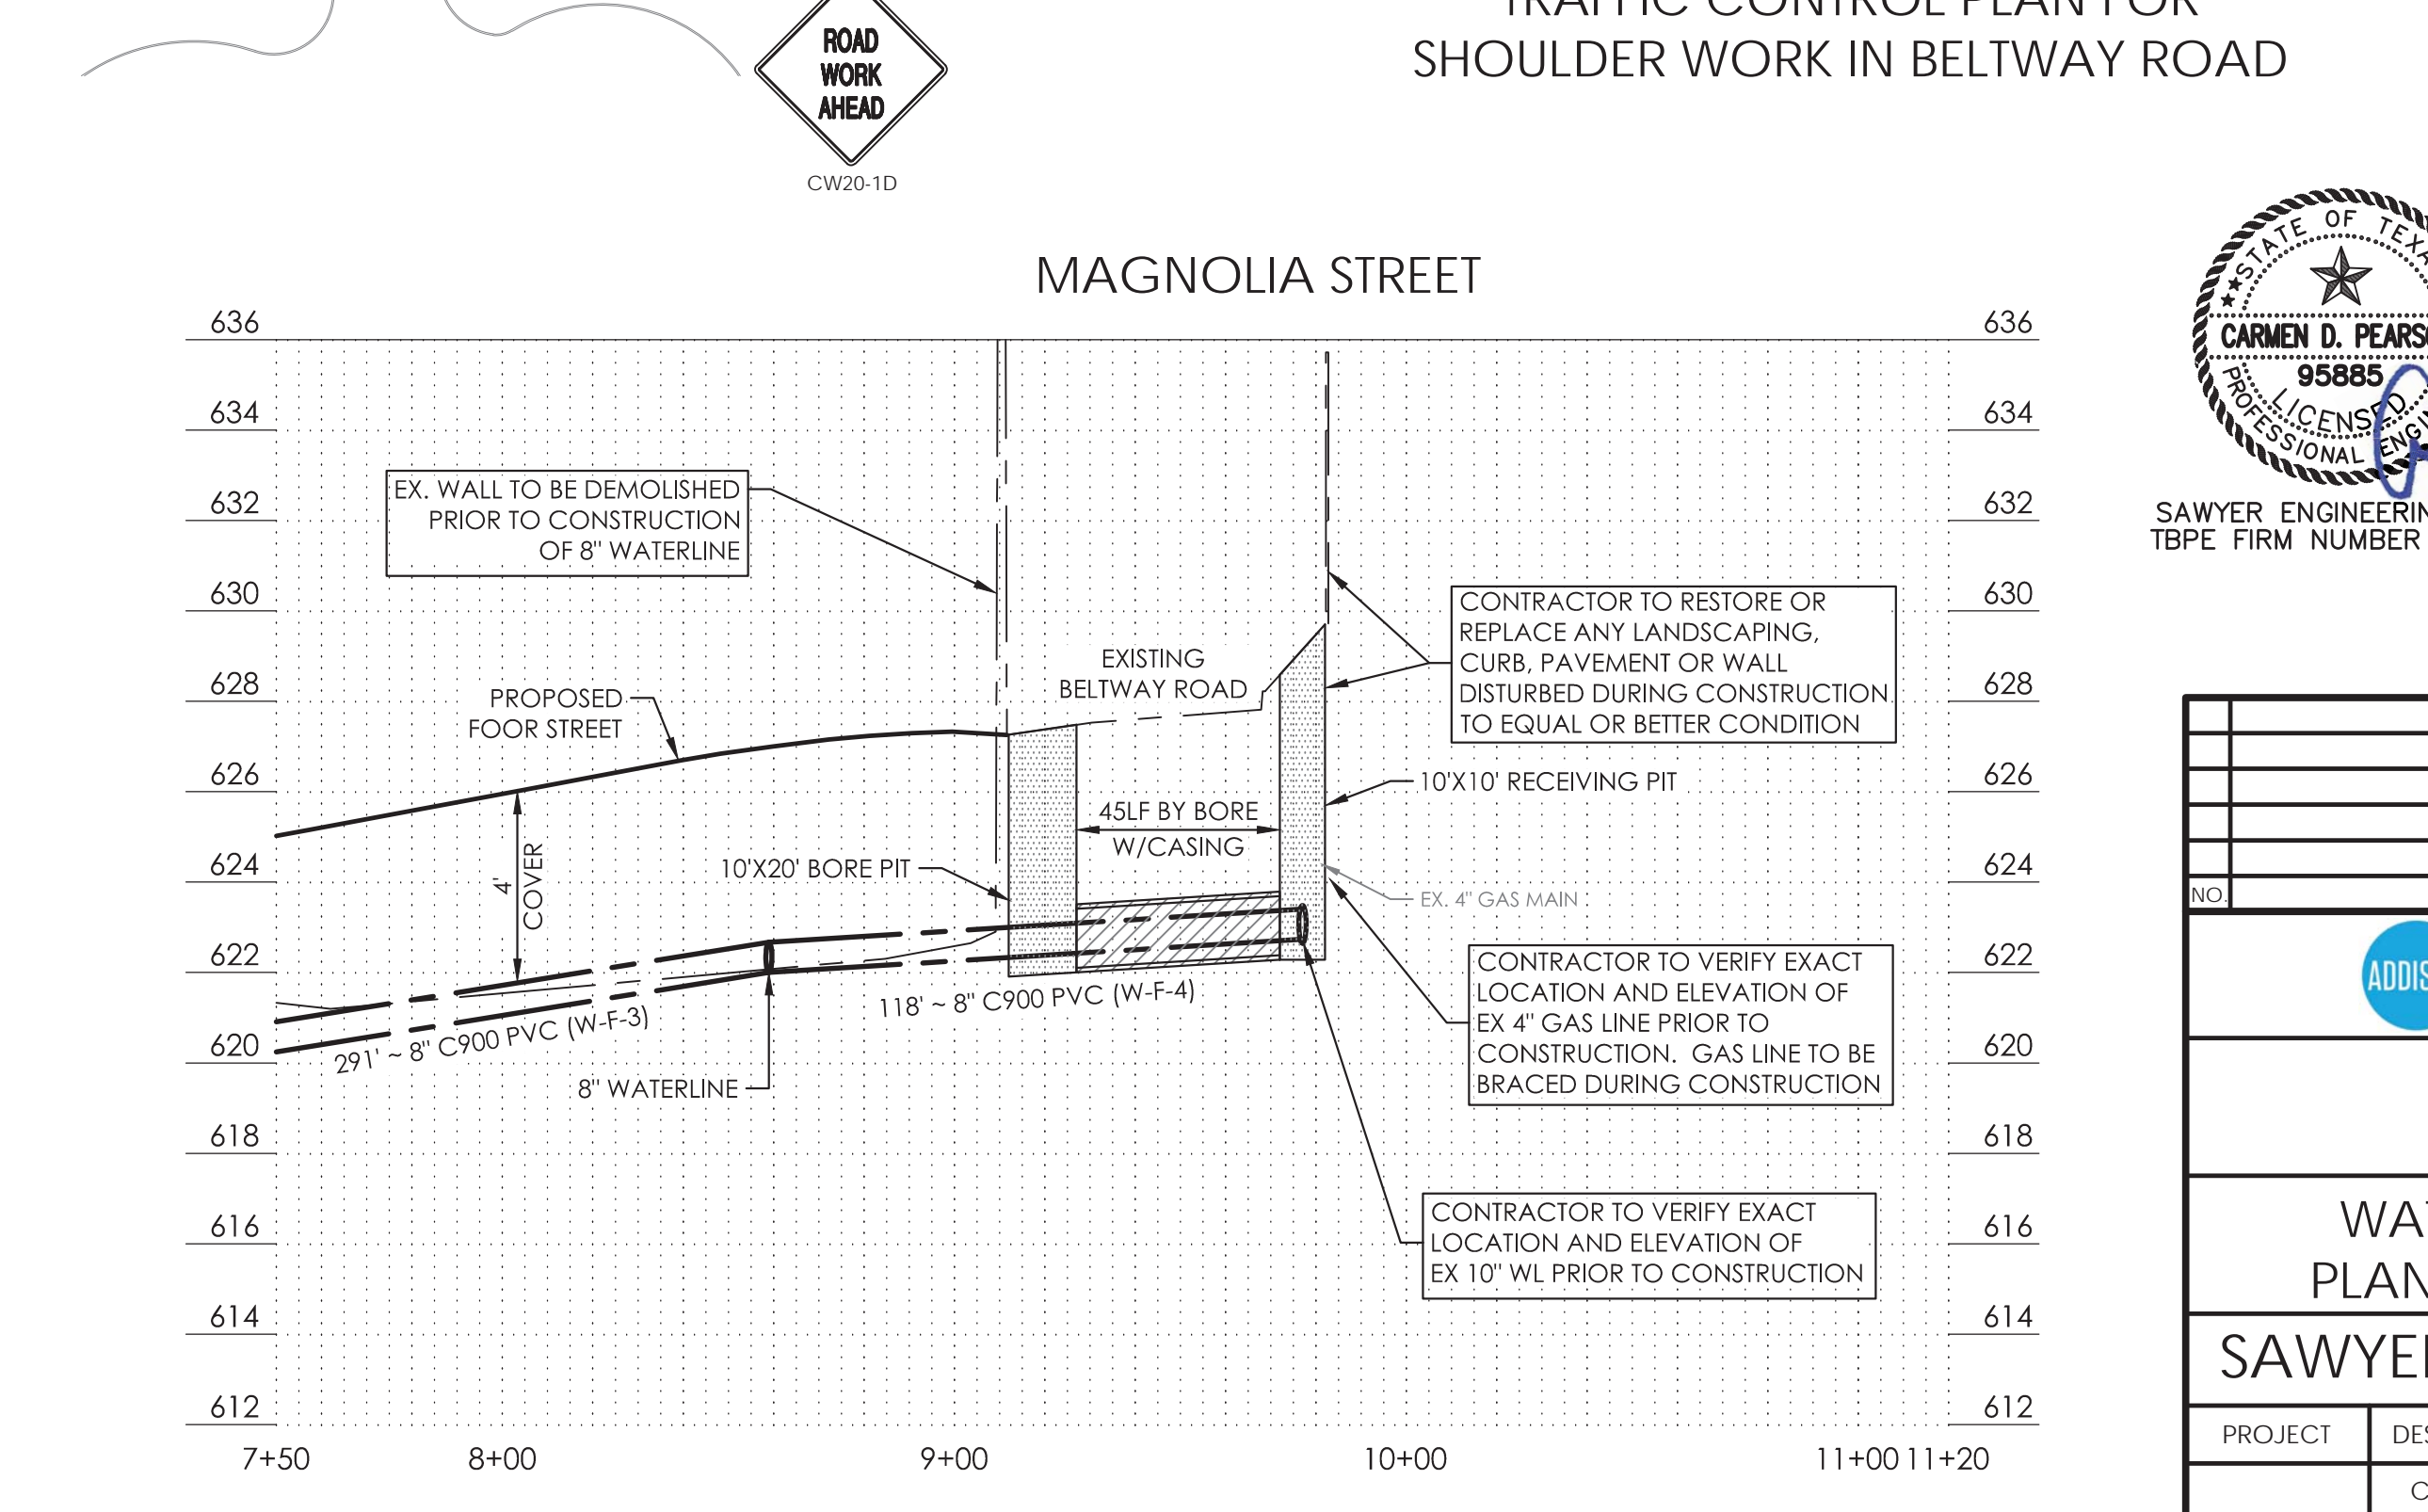
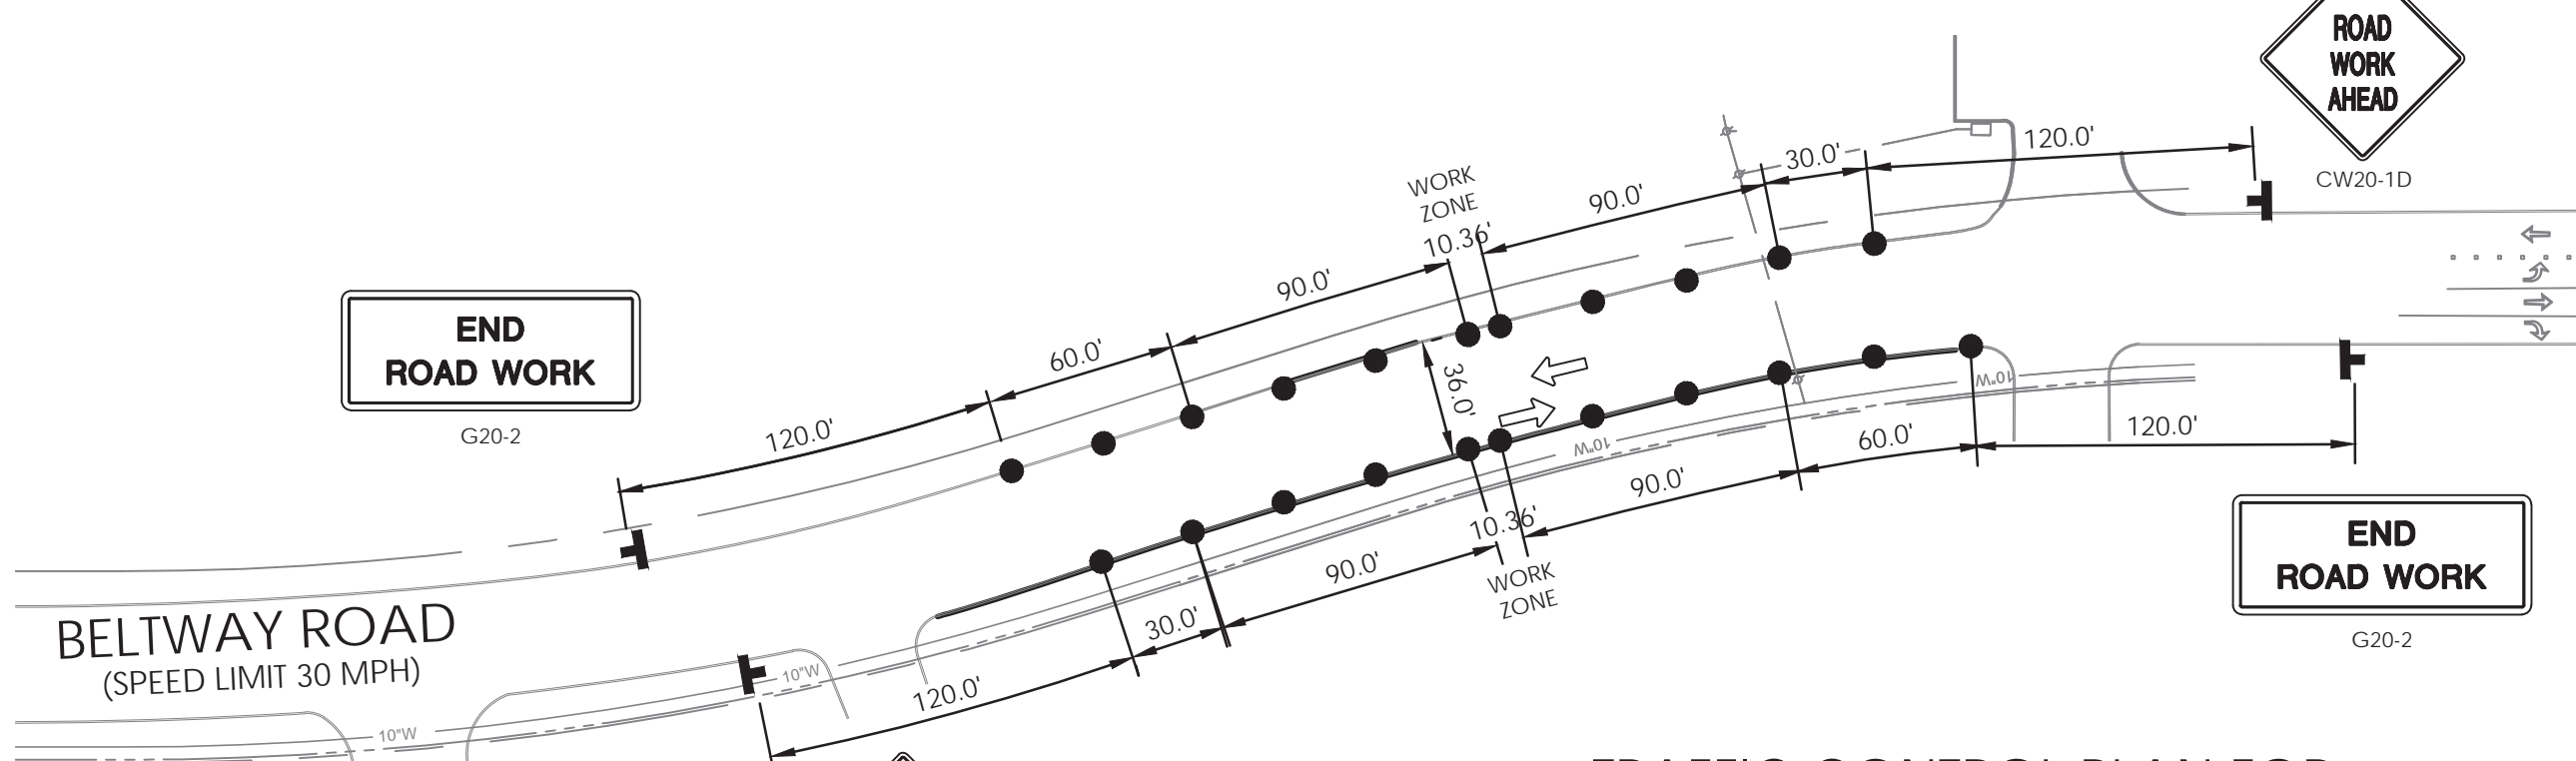
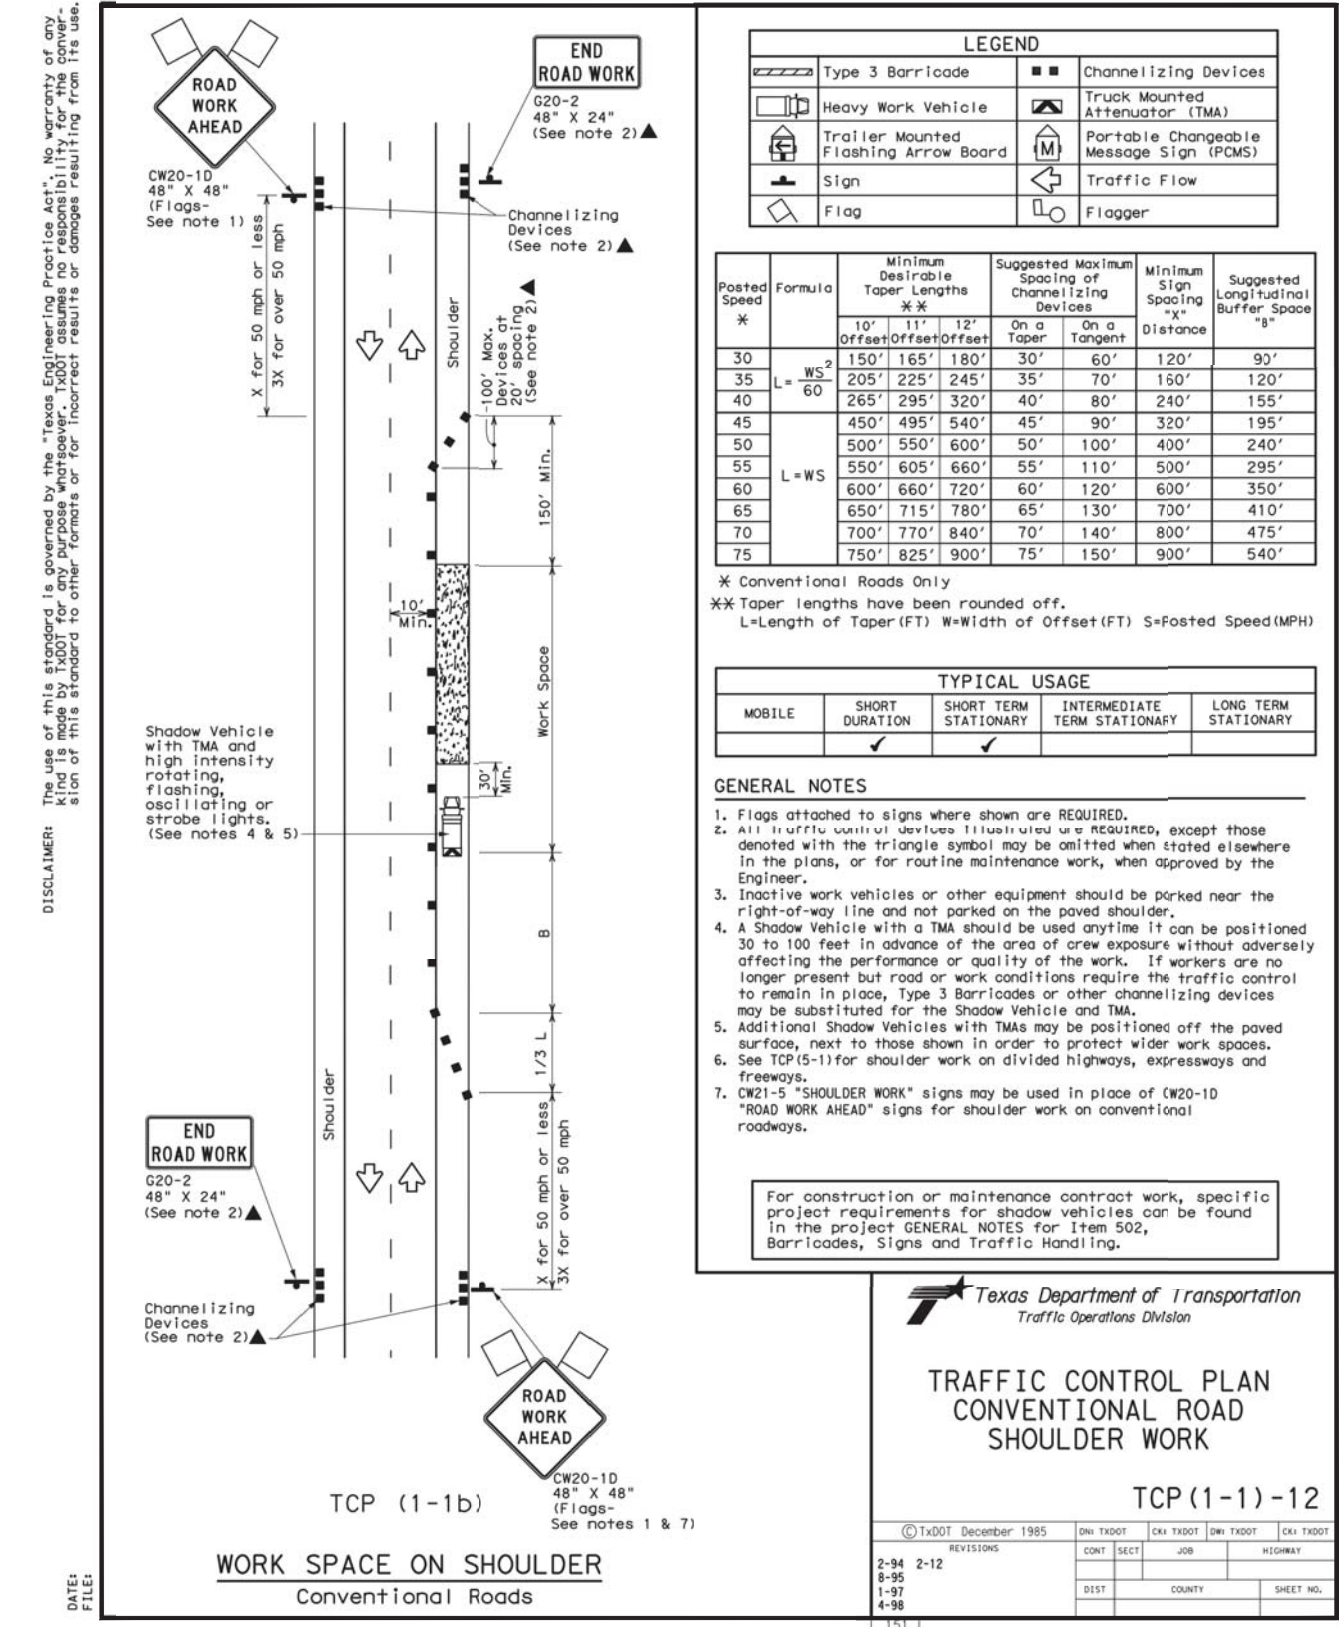
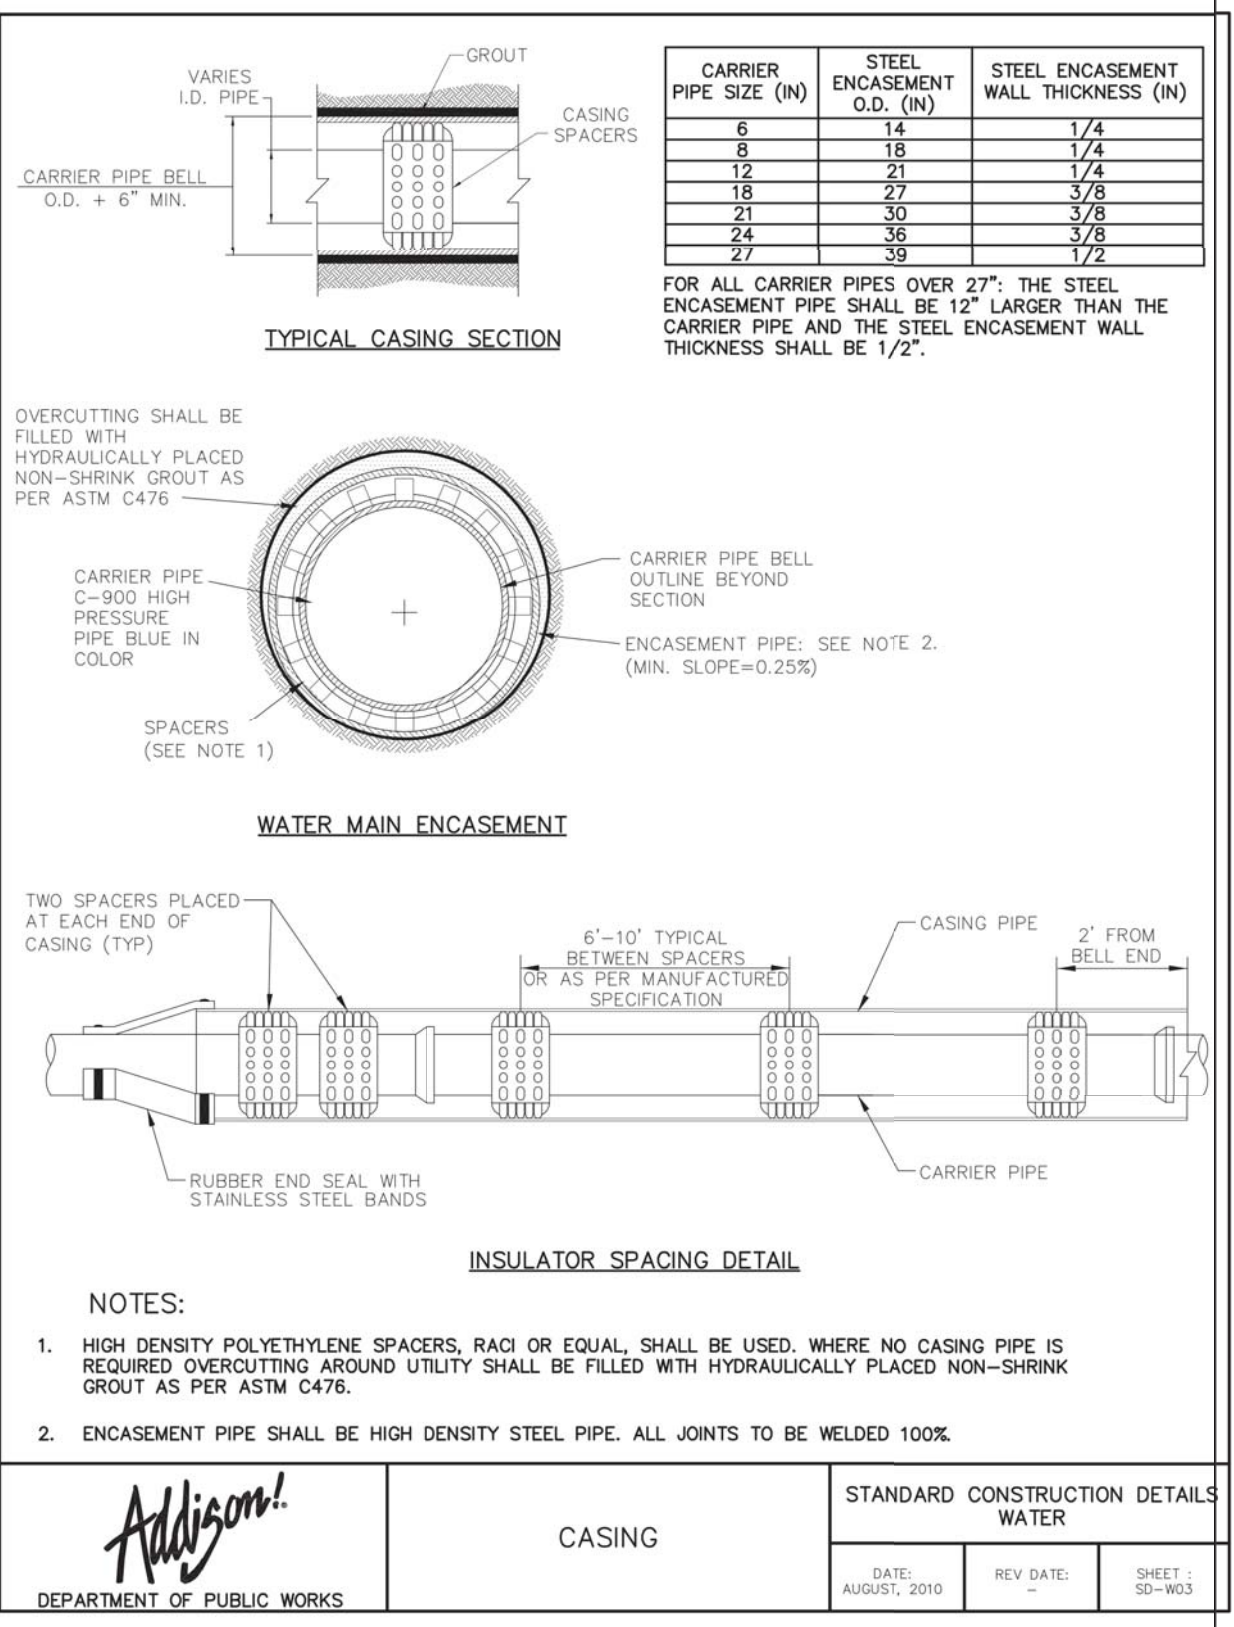
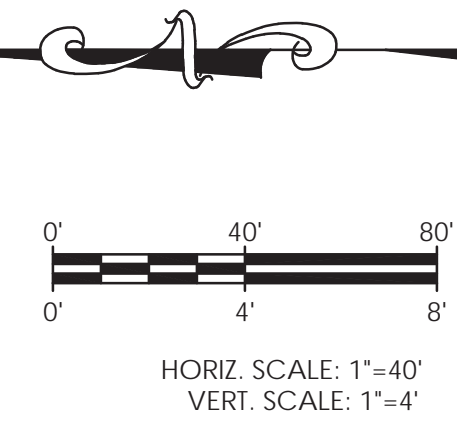


- UTILITY RELOCATION NOTES:
- AFTER UTILITY RELOCATION IS COMPLETE, LICENSED PLUMBING CONTRACTOR TO CONNECT NEW UTILITY LOCATION TO EX UTILITY LINES SERVING SNUFFER/LA VENTANA
  - CONTRACTOR TO PERFORM UTILITY RELOCATION DURING NON-BUSINESS HOURS ONLY.
  - CONTRACTOR TO PROVIDE UN-INTERRUPTED SERVICE FOR SNUFFERS/LA VENTANA DURING BUSINESS HOURS

**SANITARY SEWER AND WATERLINE LEGEND**

- SANITARY SEWER AND MANHOLE
- SANITARY SEWER AND CLEANOUT
- EXISTING SANITARY SEWER AND MANHOLE
- PROPOSED FIRE HYDRANT ASSEMBLY
- PROPOSED WATERLINE WITH GATE VALVE AND BOX WITH 10' W.L.E.
- EXISTING WATERLINE WITH GATE VALVE AND BOX
- PROPOSED STORM SEWER WITH MANHOLE AND INLETS
- PROPOSED PRIVATE STORM SEWER
- EXISTING STORM SEWER AND MANHOLE
- EXISTING INLET
- PROPOSED TREE WELL
- 2x6 TRUNCATED DOME PANEL

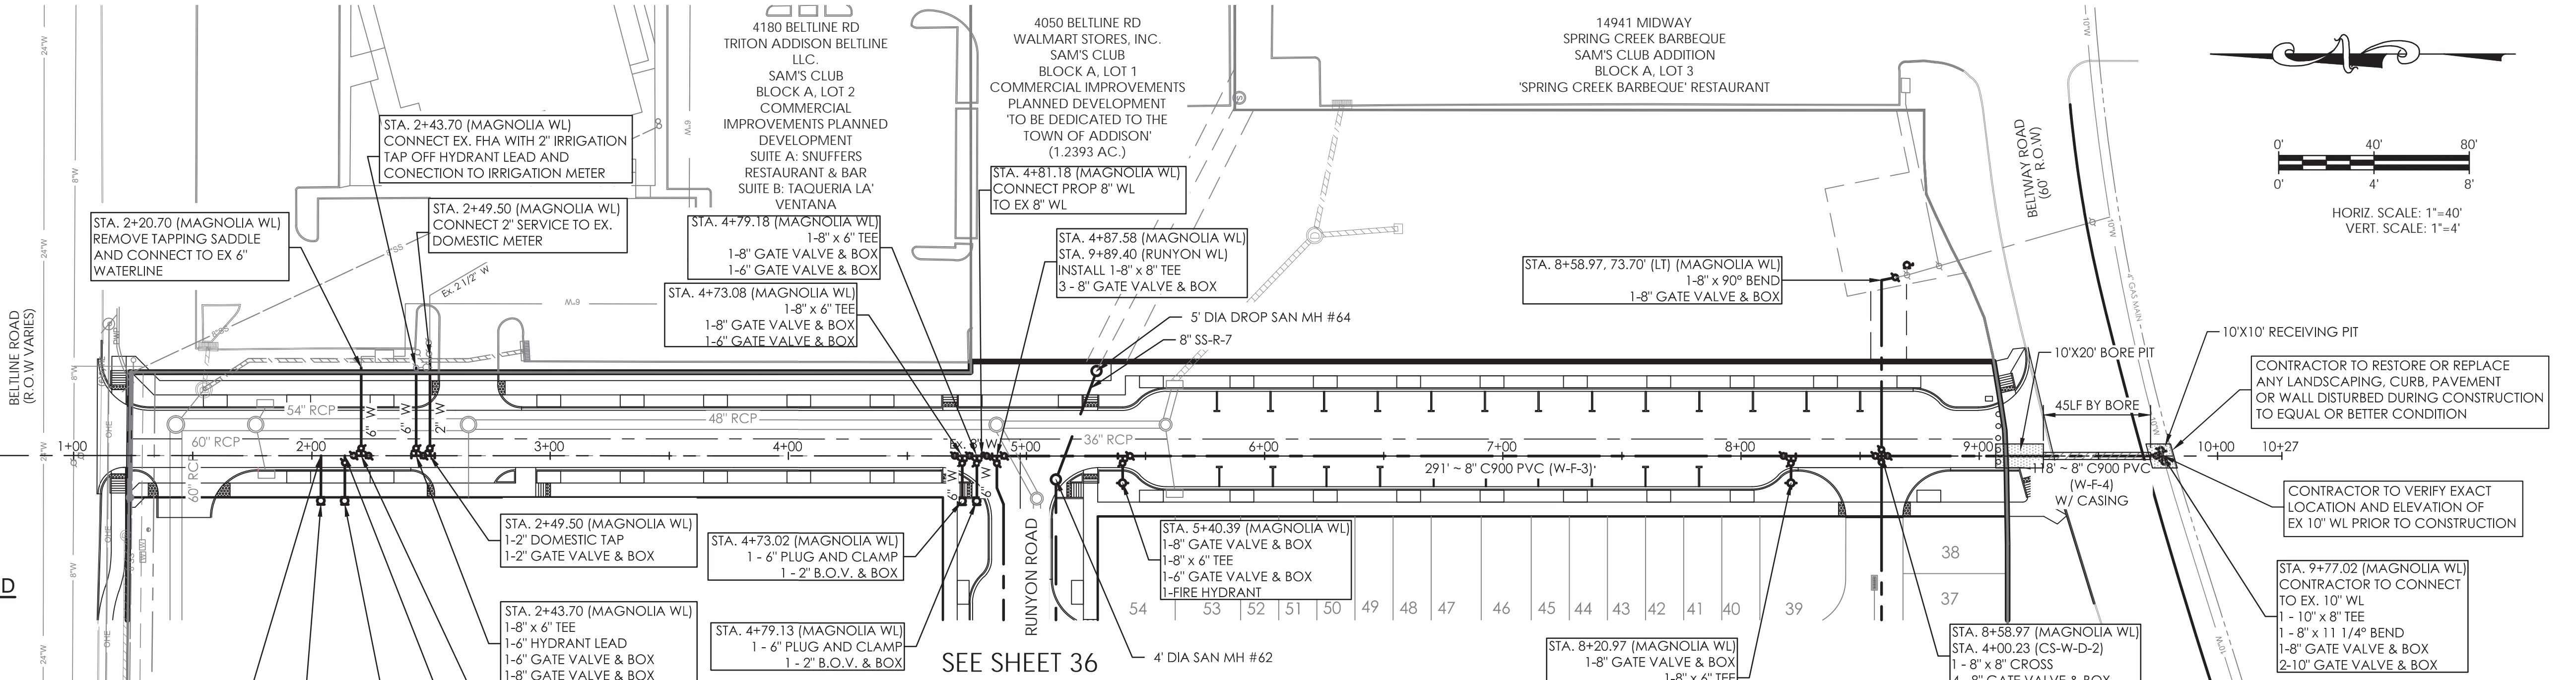

**CARMEN D. PEARSON**  
95885  
PROFESSIONAL ENGINEER  
2018/04/06

SAWYER ENGINEERING, LLC  
TBE FIRM NUMBER F-9171

ONE-CALL NOTIFICATION SYSTEM  
CALL BEFORE YOU DIG  
1-800-545-6005  
OR OTHER UTILITY LOCATING SERVICES AT  
LEAST 48 HOURS PRIOR TO  
CONSTRUCTION ACTIVITIES.

| NO. | REVISION | BY | DATE |
|-----|----------|----|------|
|     |          |    |      |
|     |          |    |      |

**TOWN OF ADDISON  
DALLAS COUNTY, TEXAS**

**IMPROVEMENT PLANS  
ADDISON GROVE**

**WATER LINE AND SANITARY SEWER  
PLAN & PROFILE - MAGNOLIA STREET**

**SAWYER ENGINEERING, LLC** 1520 OLIVER STREET HOUSTON, TEXAS 77007 TBE FIRM NUMBER F-9171 (832) 553-5948

| PROJECT | DESIGN | DRAWN    | DATE | FILE | SHEET |
|---------|--------|----------|------|------|-------|
| CDP     | JDS    | MAY 2017 |      |      | 38    |