


BLOCK C

LOT	PVMT ELEV. @ GARAGE
1	616.50
2	616.50
3	616.50
4	616.50
5	622.70
6	622.70
7	622.70
8	622.60
9	622.90
10	623.20
11	623.40
12	623.60
13	623.80
14	624.20
15	624.40
16	624.40
17	624.40
18	624.40
19	624.20
20	623.40
21	623.20
22	616.50
23	616.50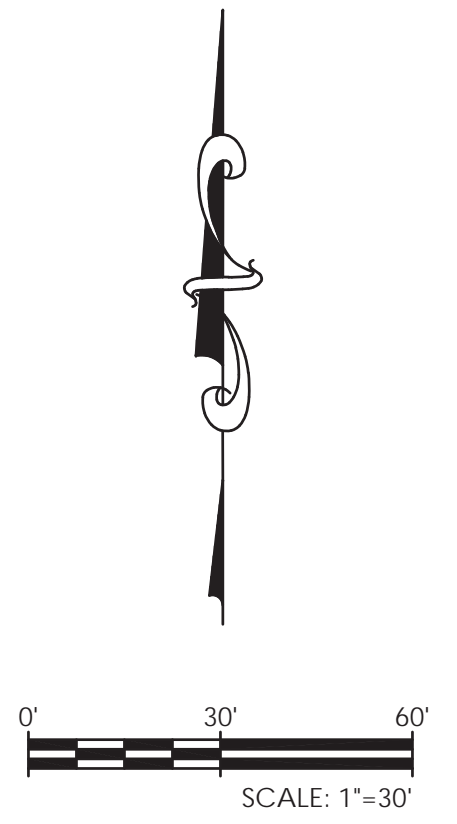
PAVING LEGEND

- PUBLIC SANITARY SEWER MANHOLE
- PRIVATE SANITARY SEWER MANHOLE
- PRIVATE SANITARY SEWER CLEANOUT
- EXISTING SANITARY SEWER MANHOLE
- PUBLIC STORM SEWER MANHOLE
- PUBLIC STORM SEWER INLET
- PRIVATE STORM SEWER INLET
- EXISTING STORM SEWER AND MANHOLE
- EXISTING INLET
- PROPOSED TREE WELL
- PUBLIC R.O.W. FIRE LANE ACCESS
- CONCRETE PRIVATE DRIVE- 24'00" FIRE LANE ACCESS AND UTILITY EASEMENT
- 2'x6' TRUNCATED DOME PANEL



2017/12/19

SAWYER ENGINEERING, LLC
TBPE FIRM NUMBER F-9171

ONE-CALL NOTIFICATION SYSTEM
CALL BEFORE YOU DIG
1-800-545-6005
OR OTHER UTILITY LOCATING SERVICES AT
LEAST 48 HOURS PRIOR TO
CONSTRUCTION ACTIVITIES.

NO.	REVISION	BY	DATE
TOWN OF ADDISON DALLAS COUNTY, TEXAS			
IMPROVEMENT PLANS ADDISON GROVE			
PRIVATE GRADING LAYOUT BLOCK C			
SAWYER ENGINEERING, LLC		1520 OLIVER STREET HOUSTON, TEXAS 77007 (832) 553-5948	
PROJECT	DESIGN	DRAWN	DATE
	CDP	JDS	MAY 2017
FILE	SHEET	48	