
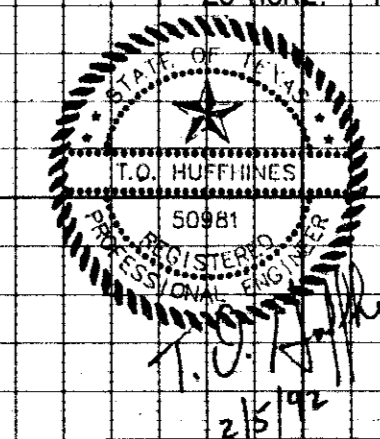
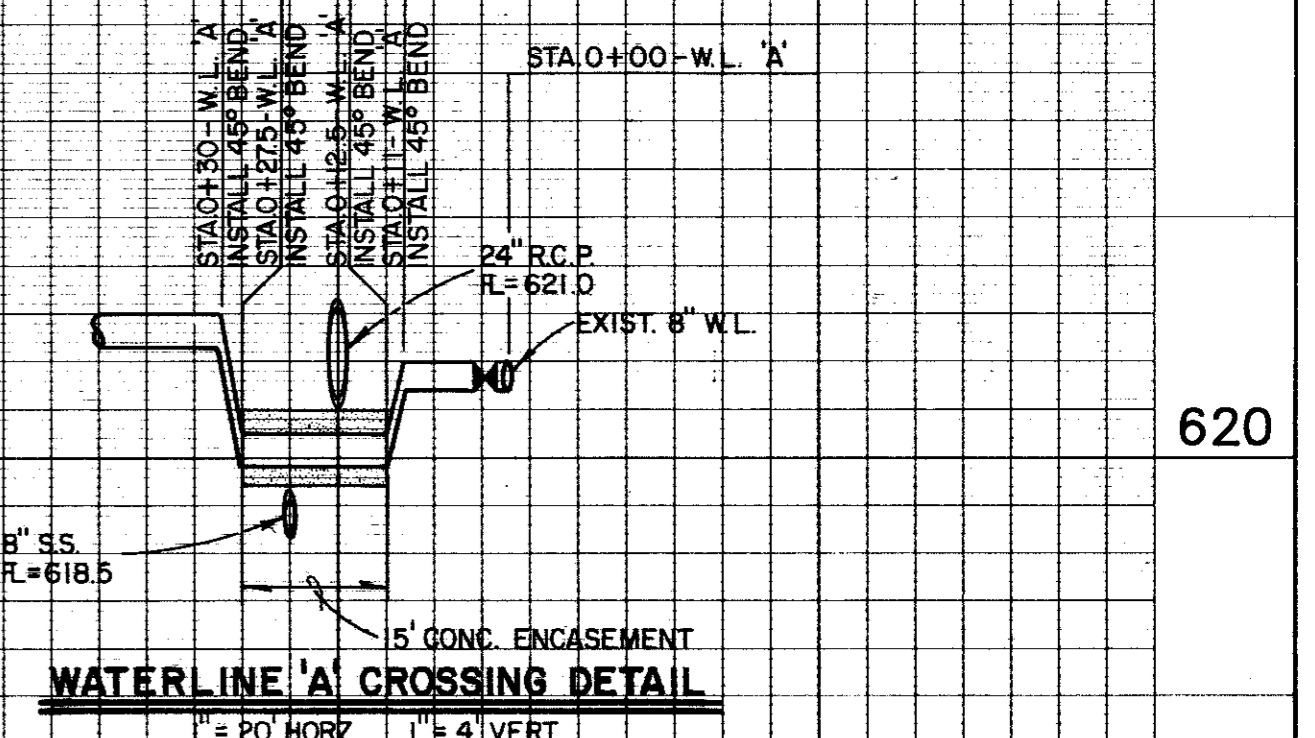


NOTE: TIE IN OF SANITARY SEWER SERVICE SUBJECT TO CITY APPROVAL

NOTE: ALL WATER LINES TO BE PUBLIC WITH DEDICATED EASEMENTS

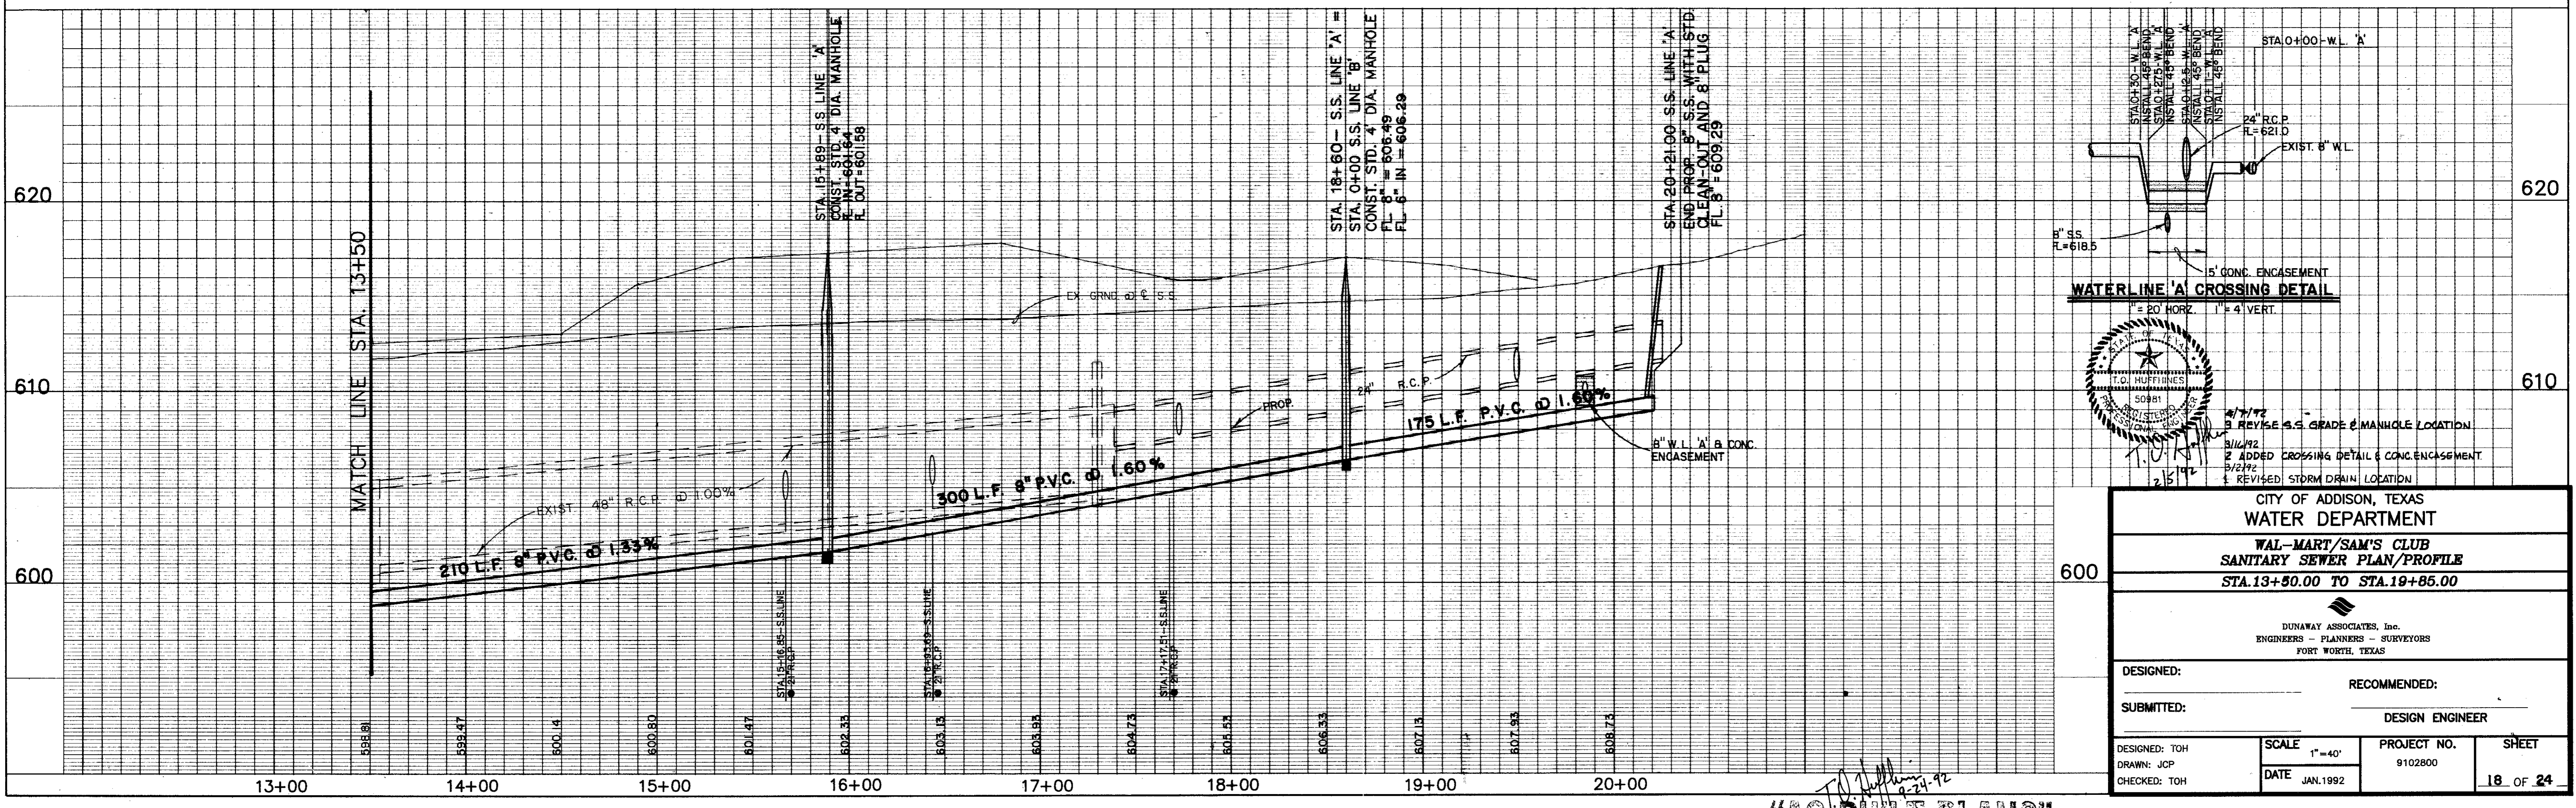

1/7/92  
 3 REVISE S.S. GRADE & MANHOLE LOCATION  
 8/16/92  
 2 ADDED CROSSING DETAIL & CONC. ENCASUREMENT  
 5/2/92  
 1 REVISED STORM DRAIN LOCATION

CITY OF ADDISON, TEXAS WATER DEPARTMENT			
WAL-MART/SAM'S CLUB SANITARY SEWER PLAN/PROFILE STA.13+50.00 TO STA.19+85.00			
DUNAWAY ASSOCIATES, Inc. ENGINEERS - PLANNERS - SURVEYORS FORT WORTH, TEXAS			
DESIGNED:	RECOMMENDED:		
SUBMITTED:	DESIGN ENGINEER		
DESIGNED: TOH	SCALE: 1"=40'	PROJECT NO. 9102800	SHEET 18 OF 24
DRAWN: JCP	DATE: JAN. 1992		
CHECKED: TOH			

*T.O.I. Huffines*  
 12-29-92  
**"AS BUILT PLANS"**  
 REVISED SAN. SEWER MANHOLE  
 LOCATIONS 12-29-92